
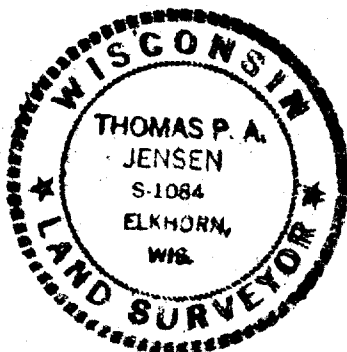


PLAT OF SURVEY

OF

LOTS 5 & 6 OF SUMMER HAVEN SUBDIVISION,
WILLIAMS BAY, WALWORTH COUNTY, WISCONSIN.

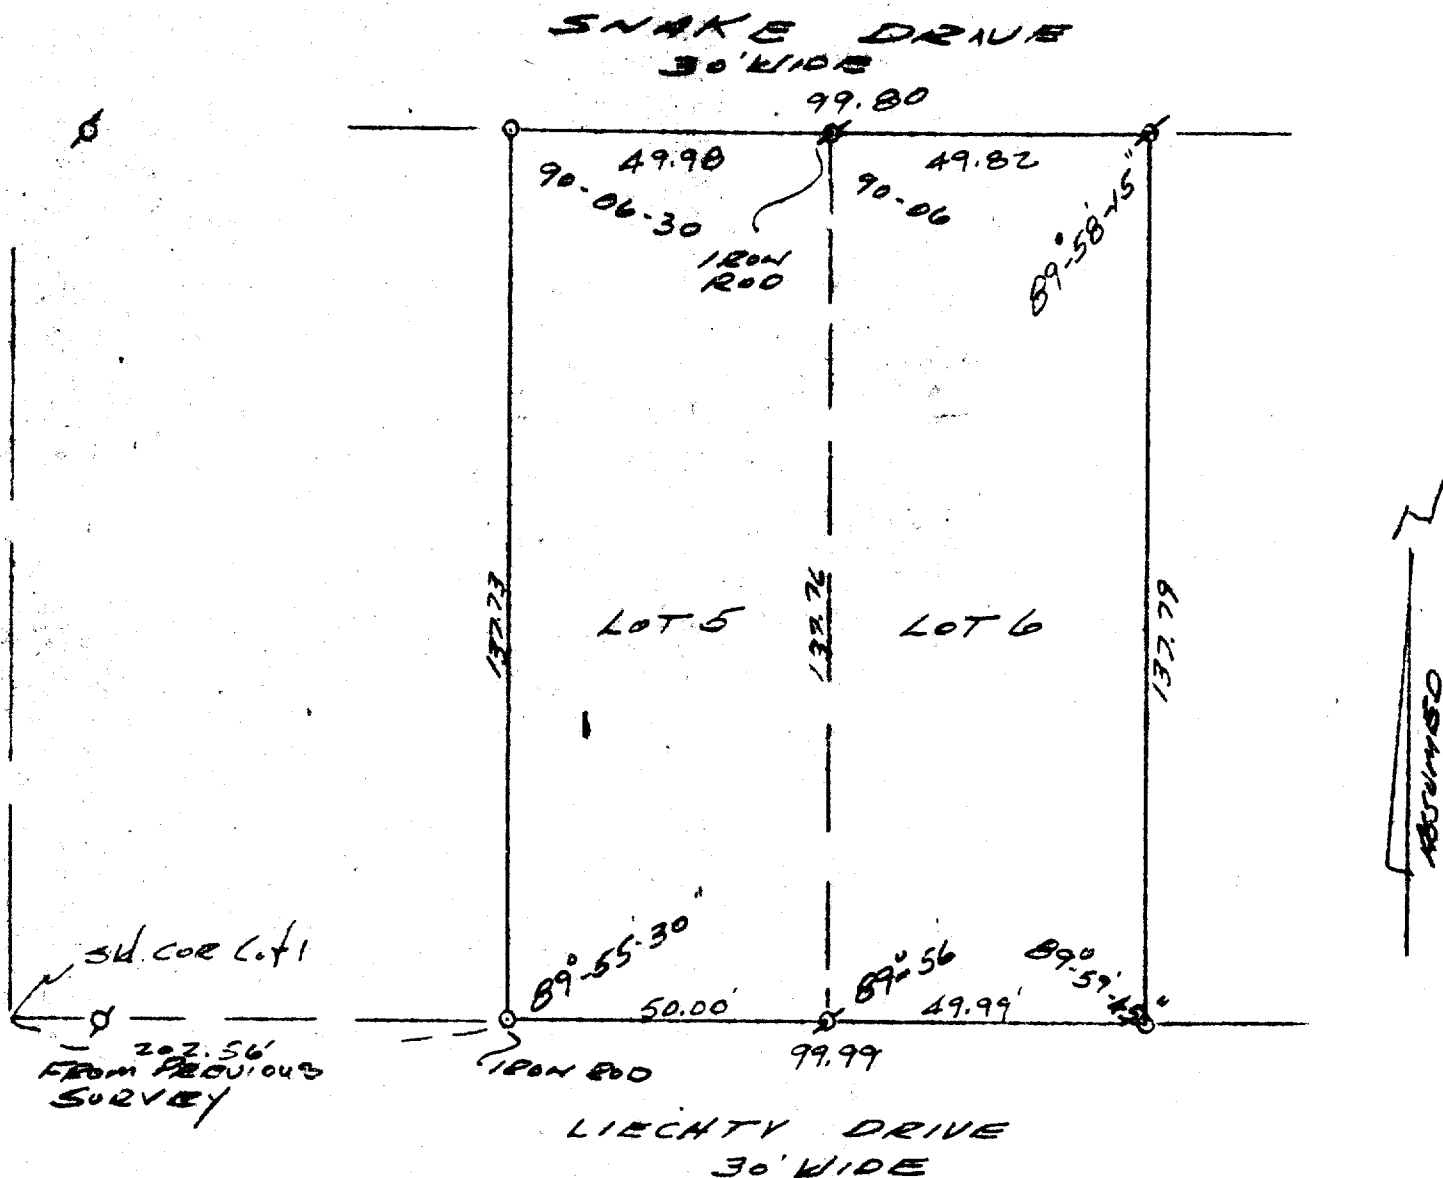

SURVEY AND PLAT BY
JENSEN & JOHNSON, INC.
CIVIL ENGINEERS AND SURVEYORS
Elkhorn, Wisconsin

LEGEND

- — Iron Pipe SET
 - — Concrete Monument
- Scale 1" = 30'

○ — IRON PIPE FOUND

WE CERTIFY: That we have surveyed the above described property and that the plat shown hereon is an accurate survey and a true representation thereof and correctly shows the exterior boundary lines and all divisions of said property.

Date MAY 21, 1974

Wisconsin Registered Land Surveyor, No. S-1084