




PREPARED FOR
DORTHY HIGGINS GERBER
SHOREWEST REALTY
LAKE GENEVA, WI

PLAT OF SURVEY

- OF -

PATHFINDER SURVEYING INC.
(formerly)
J.K. SURVEYING INC.
P.O BOX 322
LAKE GENEVA, WI. 53147
WWW.PATHFINDERSURVEYING.NET
262-248-8303

LOT 3, BLOCK 9, WILLIAMS SECOND ADDITION TO THE
VILLAGE OF WILLIAMS BAY, LOCATED IN THE NE 1/4 OF
SECTION 1, TOWN 1 NORTH, RANGE 18 EAST, VILLAGE
OF WILLIAMS BAY, COUNTY OF WALWORTH AND STATE
OF WISCONSIN.

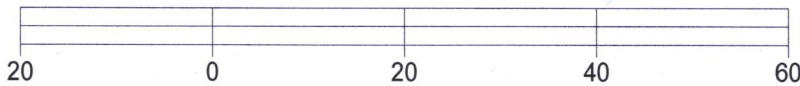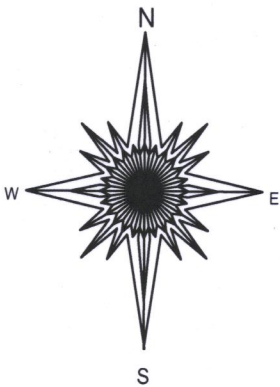
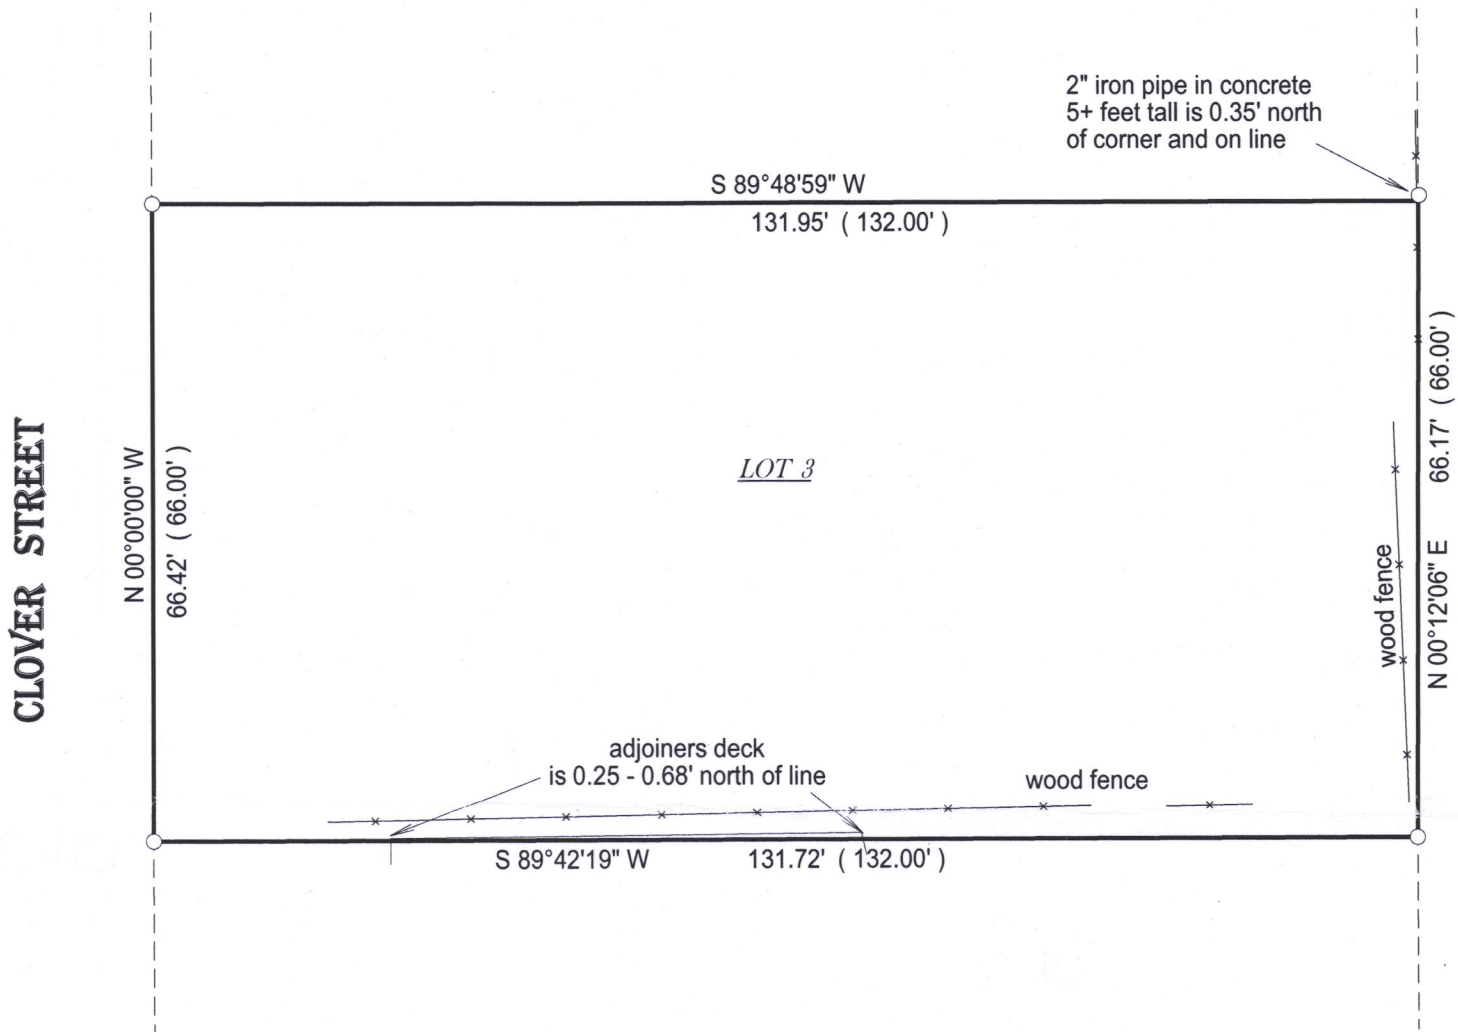


BASIS OF BEARING OF THIS PLAT: THE EAST LINE OF CLOVER ST.
WAS ASSUMED TO BEAR NORTH AS MONUMENTED.

I hereby certify that I have surveyed the above- described property and the
above map is a true representation thereof and shows the size and
location of the property, its exterior boundaries, the location and
dimensions of all structures thereon, fences, apparant easements and
roadways and visible encroachments if any.

This survey is made for the present owners of the property, and those who
purchase, mortgage, or guarantee the title thereto, within one year from
the date hereof.

DATED THIS 1ST DAY OF NOVEMBER, 2016.

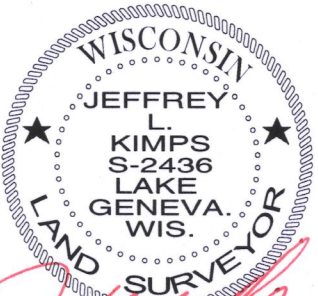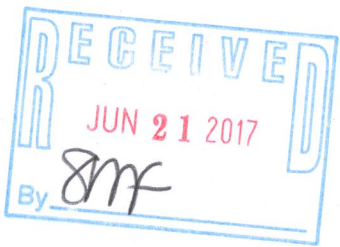

JEFFREY L KIMPS S - 2436
Wisconsin Professional Land Surveyor
(original if signed in red)

() = recorded as

□ = found iron bar

○ = found iron pipe

● = set iron pipe

■ = set iron bar

SCALE 1" = 20'

JOB # 16-344

TAX ID # WOP00121

011-2735