


PREPARED FOR  
LINDA TONGE  
KEEFE REAL ESTATE  
LAKE GENEVA WI

# PLAT OF SURVEY

- OF -

PATHFINDER SURVEYING INC.  
(formerly)  
J.K. SURVEYING INC.  
P.O BOX 322  
LAKE GENEVA, WI. 53147  
WWW.PATHFINDERSURVEYING.NET  
262-248-8303

LOT 193 CEDAR POINT PARK, ACCORDING TO THE RECORD PLAT  
THEREOF, LOCATED IN THE VILLAGE OF WILLIAMS BAY, COUNTY  
OF WALWORTH AND STATE OF WISCONSIN.

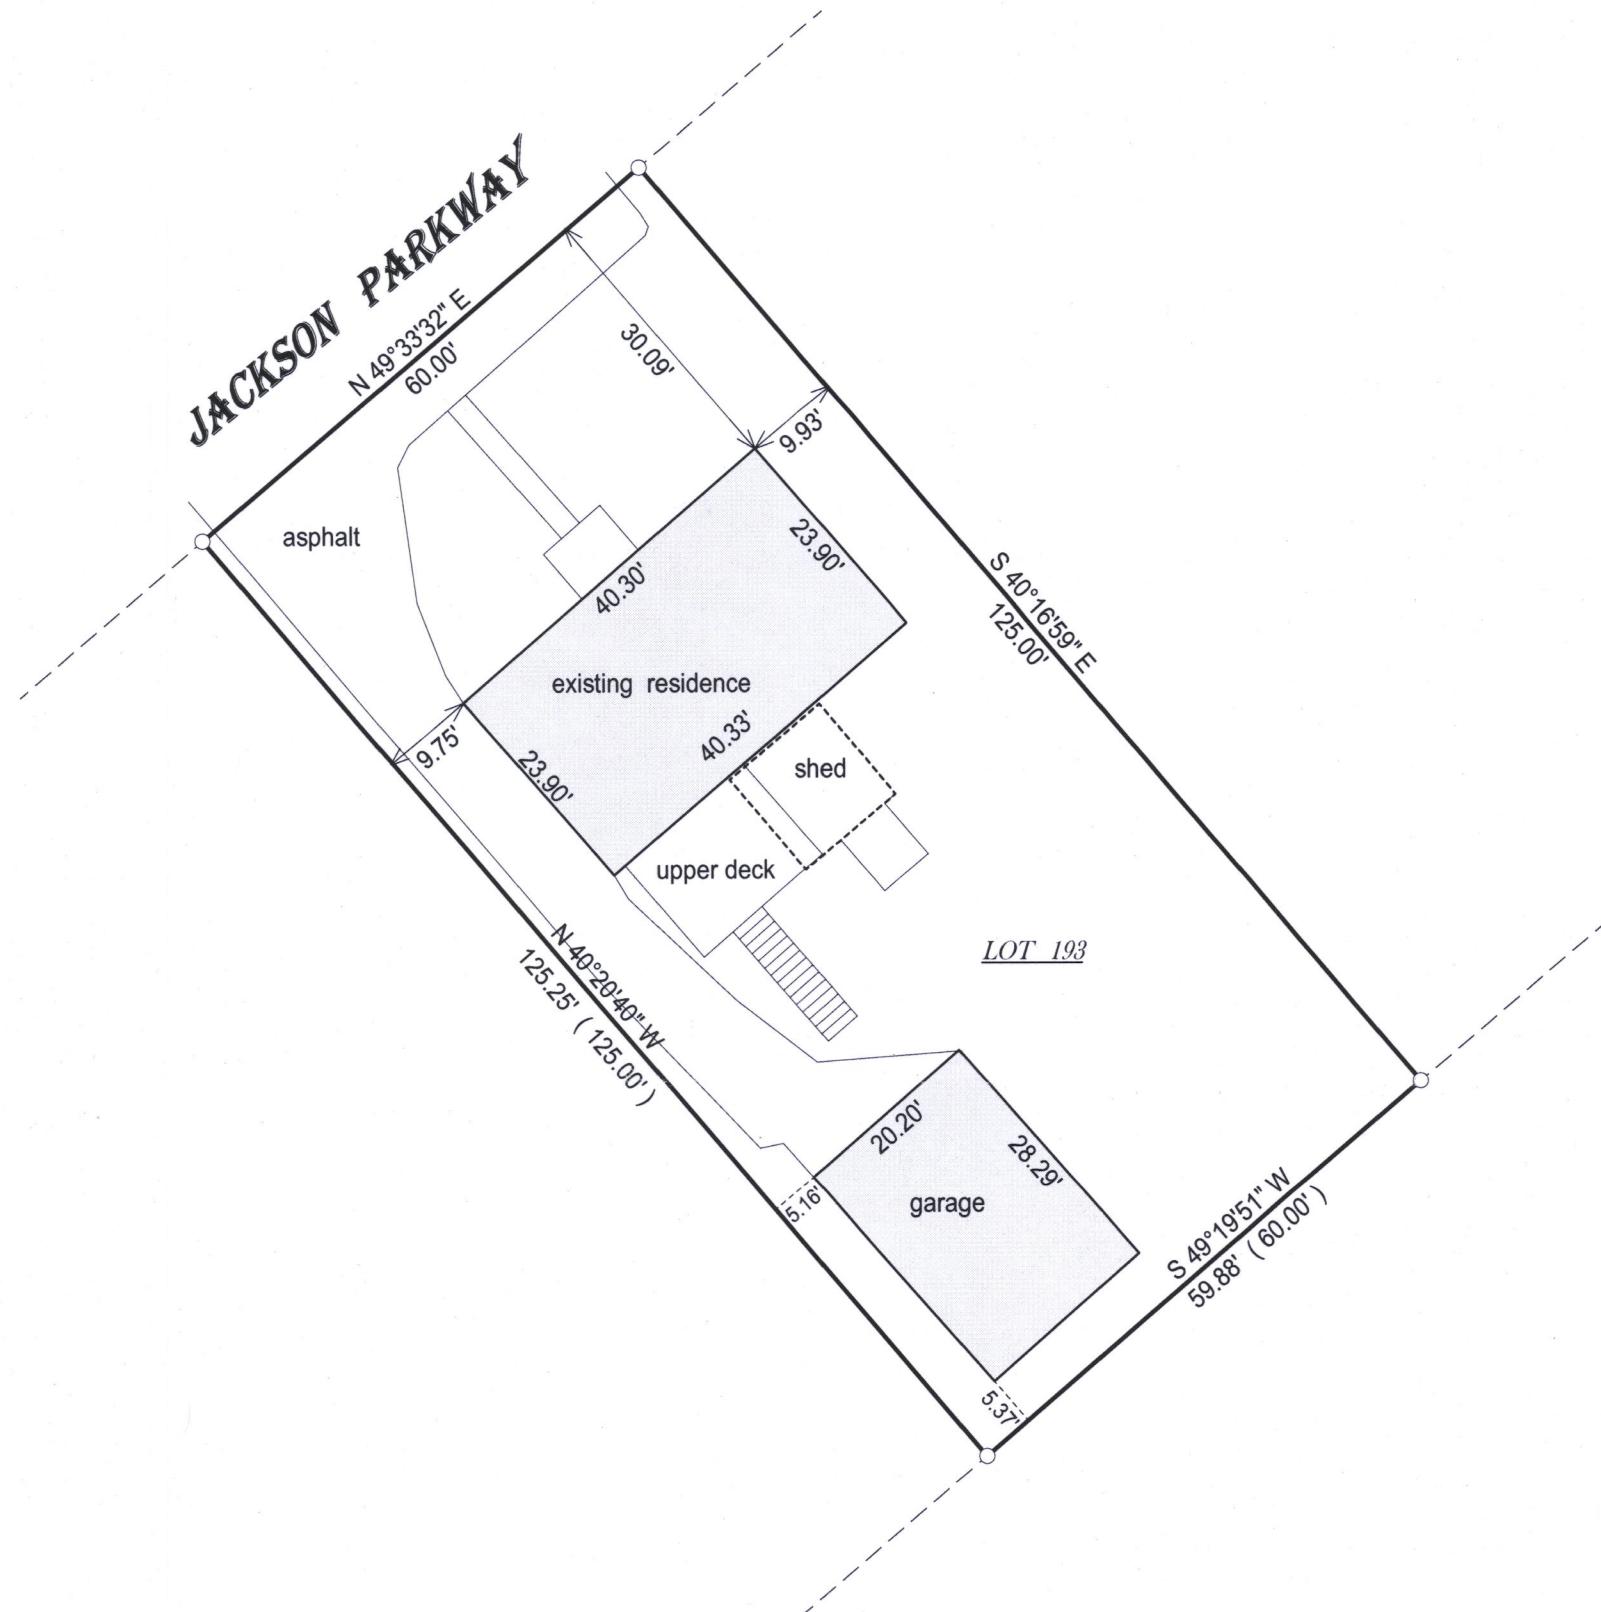

( ) = recorded as

= found iron bar

= found iron pipe


= set iron pipe

= set iron bar

SCALE 1" = 20'

JOB # 17-128

TAX ID #  
WCP00167

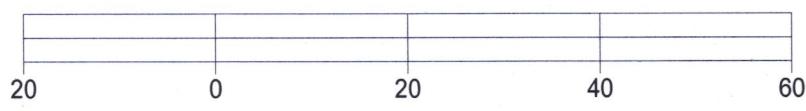


BASIS OF BEARING OF THIS PLAT: THE US STATE PLANE COORDINATE  
SYSTEM, SOUTH ZONE NAD 83 ( WISCORS ).

I hereby certify that I have surveyed the above- described property and the  
above map is a true representation thereof and shows the size and  
location of the property, its exterior boundaries, the location and  
dimensions of all structures thereon, fences, apparent easements and  
roadways and visible encroachments if any.

This survey is made for the present owners of the property, and those who  
purchase, mortgage, or guarantee the title thereto, within one year from  
the date hereof.

DATED THIS 19TH DAY OF MAY, 2017.

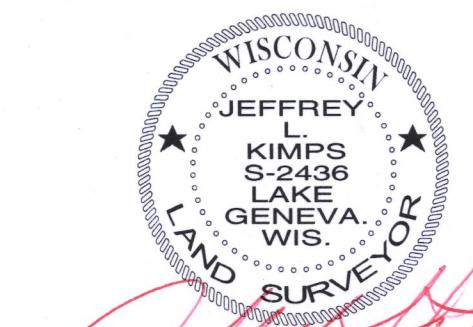

JEFFREY L. KIMPS S-2436  
Wisconsin Professional Land Surveyor  
( original if signed in red )

WCP-167

011-2741