


PLAT OF SURVEY

OF

lots 45 & 43 of Bay View Subdivision, Village of Williams Bay, Wisconsin

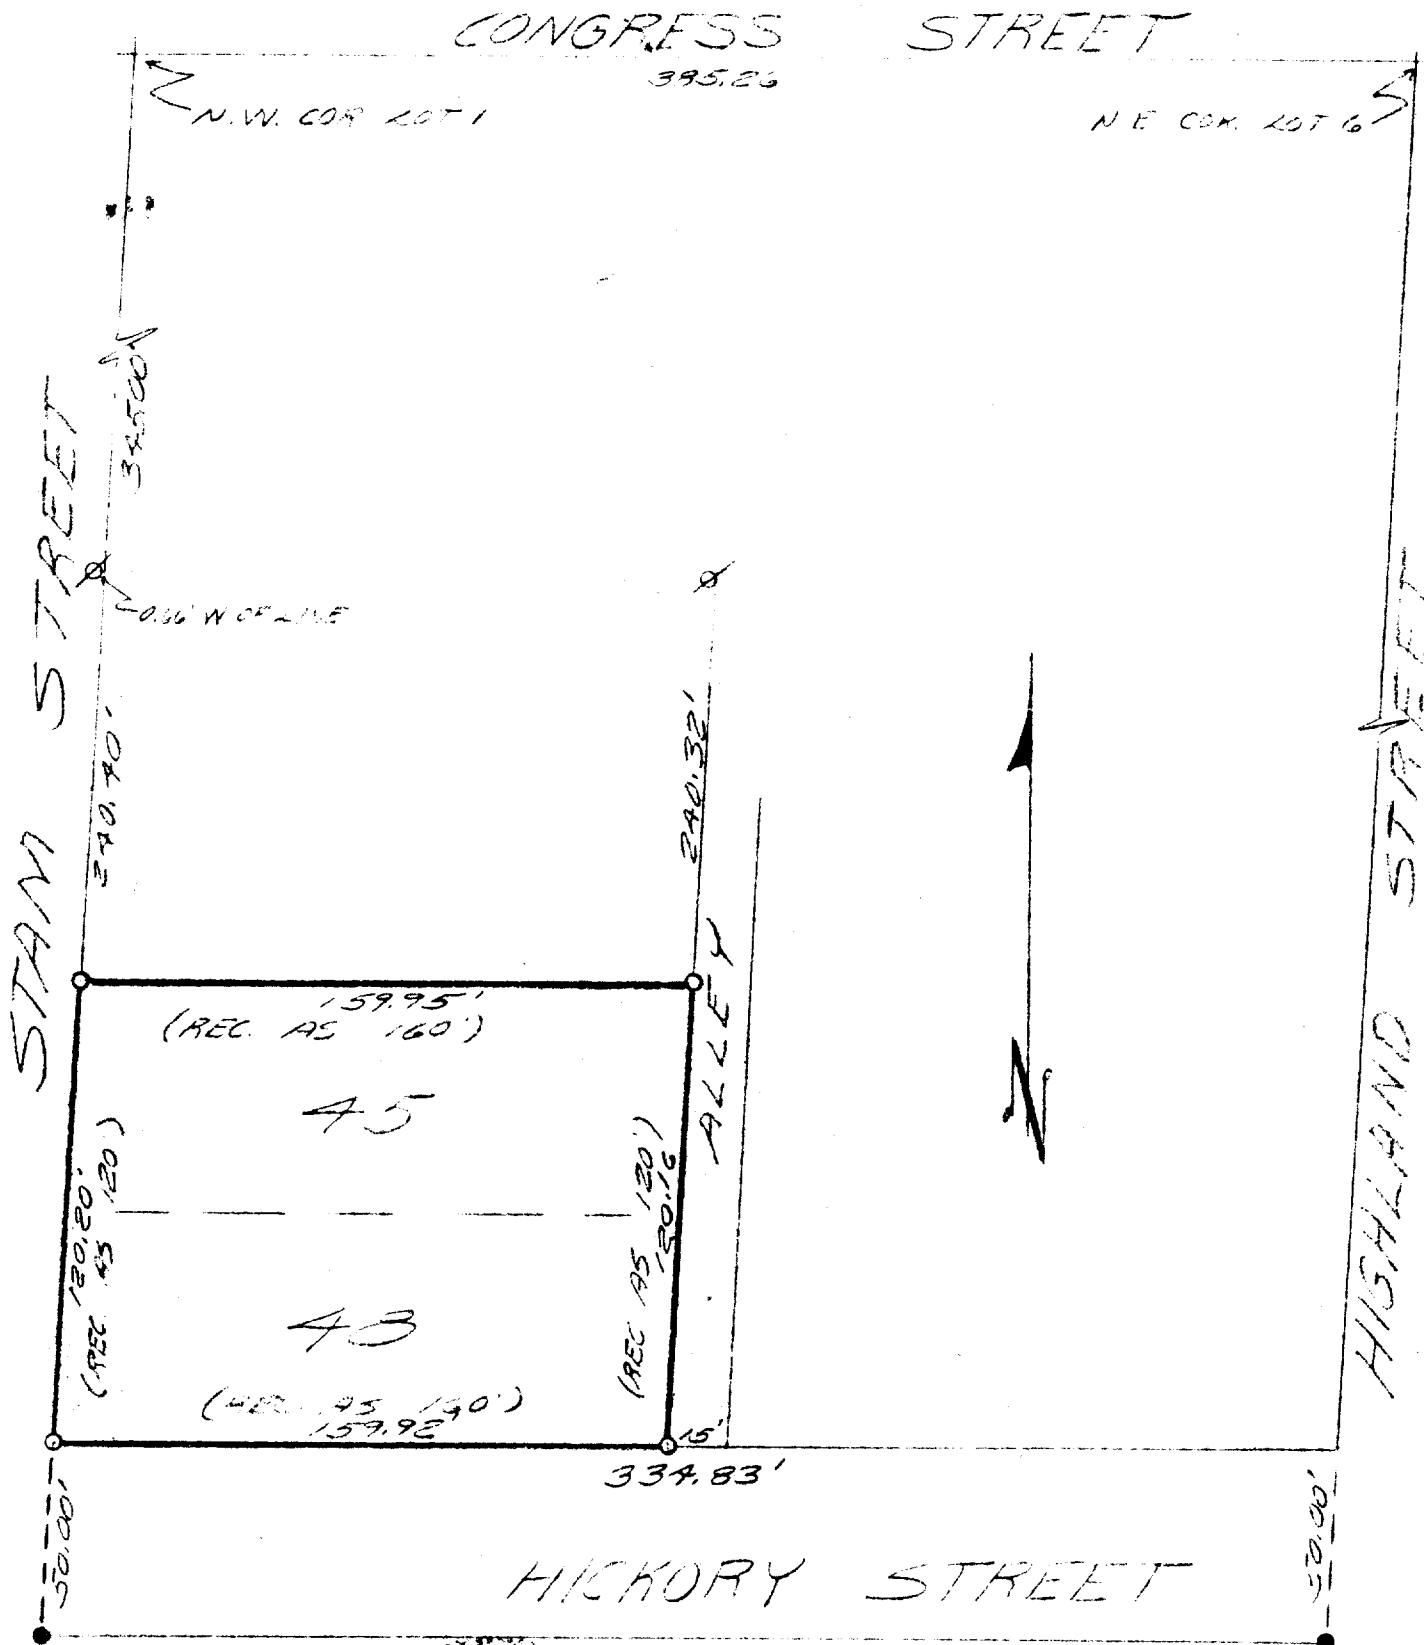

SURVEY AND PLAT BY

JENSEN & JOHNSON, INC.

CIVIL ENGINEERS AND SURVEYORS

Elkhorn, Wisconsin

LEGEND

- Ø — Iron Pipe Found
- — Concrete Monument
- Scale 1" = 50'
- — Iron Pipe Set



WE CERTIFY that we have surveyed the above described property and that the plat shown hereon is an accurate survey and a true representation thereof and correctly shows the exterior boundary lines and all divisions of said property.

Date 20 Apr. 1973

Lloyd L. Jensen
LLOYD L. JENSEN,

Wisconsin Registered Land Surveyor, No. S-211