

Plat of Survey

of

Lot 9 in Block 2 of University Heights,

a subdivision located in the Northwest 1/4 of the Southeast 1/4 of Section 1, Town 1 North, Range 16 East, Village of Williams Bay, Walworth County, Wisconsin.


Surveyed for: **Jeff Wolski**
72 Stam Street
Williams Bay, Wisconsin. 53191

Lot 9
Tax Parcel
WUH 00012
0.692 Acre
30,150 Sq.Ft.


House
No. 72

Approx. floor
Elev.=98.1.

Stam Street
(49.5' Wide)

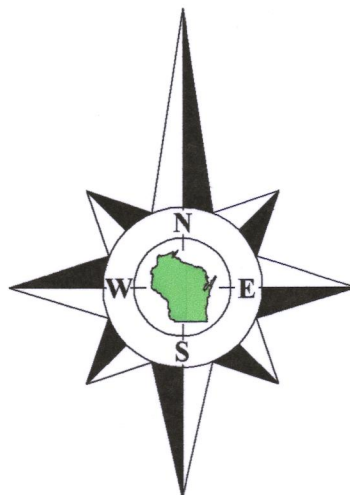

Bearings referenced to the West line of Stam Street,
recorded as (N0°46'W) on the plat of University Heights.

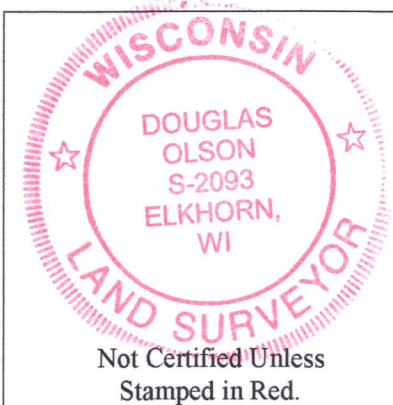

Notes:

- 1) This Plat of Survey is not certified unless signed and sealed in red ink.
- 2) This survey is subject to Wisconsin lien laws. This Plat of Survey is the notice of intent to file lien. Lien waiver required.
- 3) The Survey Date shown on this Plat of Survey is the completion date of the field work.


Copyright© 2017 by Olson Land Surveying, LLC.

All rights reserved. No part of this survey plat may be reproduced or transmitted in any form by any means - graphic, electronic, or mechanical, including photocopying, tracing, or information storage and retrieval systems - without permission in writing from Douglas G. Olson, Olson Land Surveying, LLC.

I hereby certify that I have surveyed the above described property in compliance with Chapter A-E 7 of the Wisconsin Administrative Code and that the map hereon is correct to the best of my knowledge and belief.

Douglas G. Olson
Wisconsin Professional Land Surveyor - 2093

Southeast Corner of
Lot 7 in Block 2 of
University Heights.

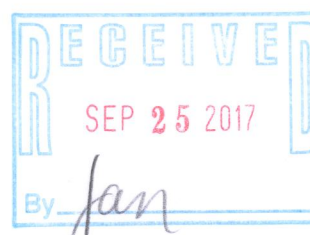

WUH-12 011-2782

Sheet 1 of 1 Sheets

Job Reference Number

2017.017

Legend of Symbols & Abbreviations


Found Concrete Monument
Found Iron Pin in Concrete
Found Iron Rod, 1/4" dia.
Found Iron Rod, 1/2" dia.
Recorded Information
Utility Pole
Manhole
Asphalt Surface
Concrete Surface
Stone Wall
Brick Pavement

North
South
East
West
Degrees
Minutes
Seconds
Feet
Meters
No. Number
NE Northeast
SE Southeast
SW Southwest
NW Northwest

OLSON
LAND SURVEYING, LLC
Rural | Residential | Commercial

45 South Wisconsin Street | P.O. Box 322
Elkhorn, Wisconsin. 53121
Telephone: (262) 723-3434
Facsimile: (262) 723-8044
Email: doug@olsonsurveying.com
Website: www.olsonsurveying.com

Scale in Feet
1" = 10'

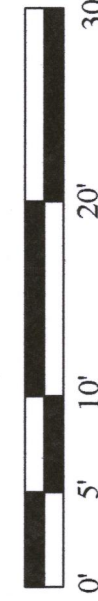

Survey date: March 20, 2017.
Revisions: