


BENCH MARK IS WEST EDGE
OF CONC. AROUND SEWER
COVER - EL. = 100.00
FLOWLINE OF OUTLET LINE =
96.90.
FLOWLINE OF INLET LINE FROM
ADM. BLDG. = 97.60

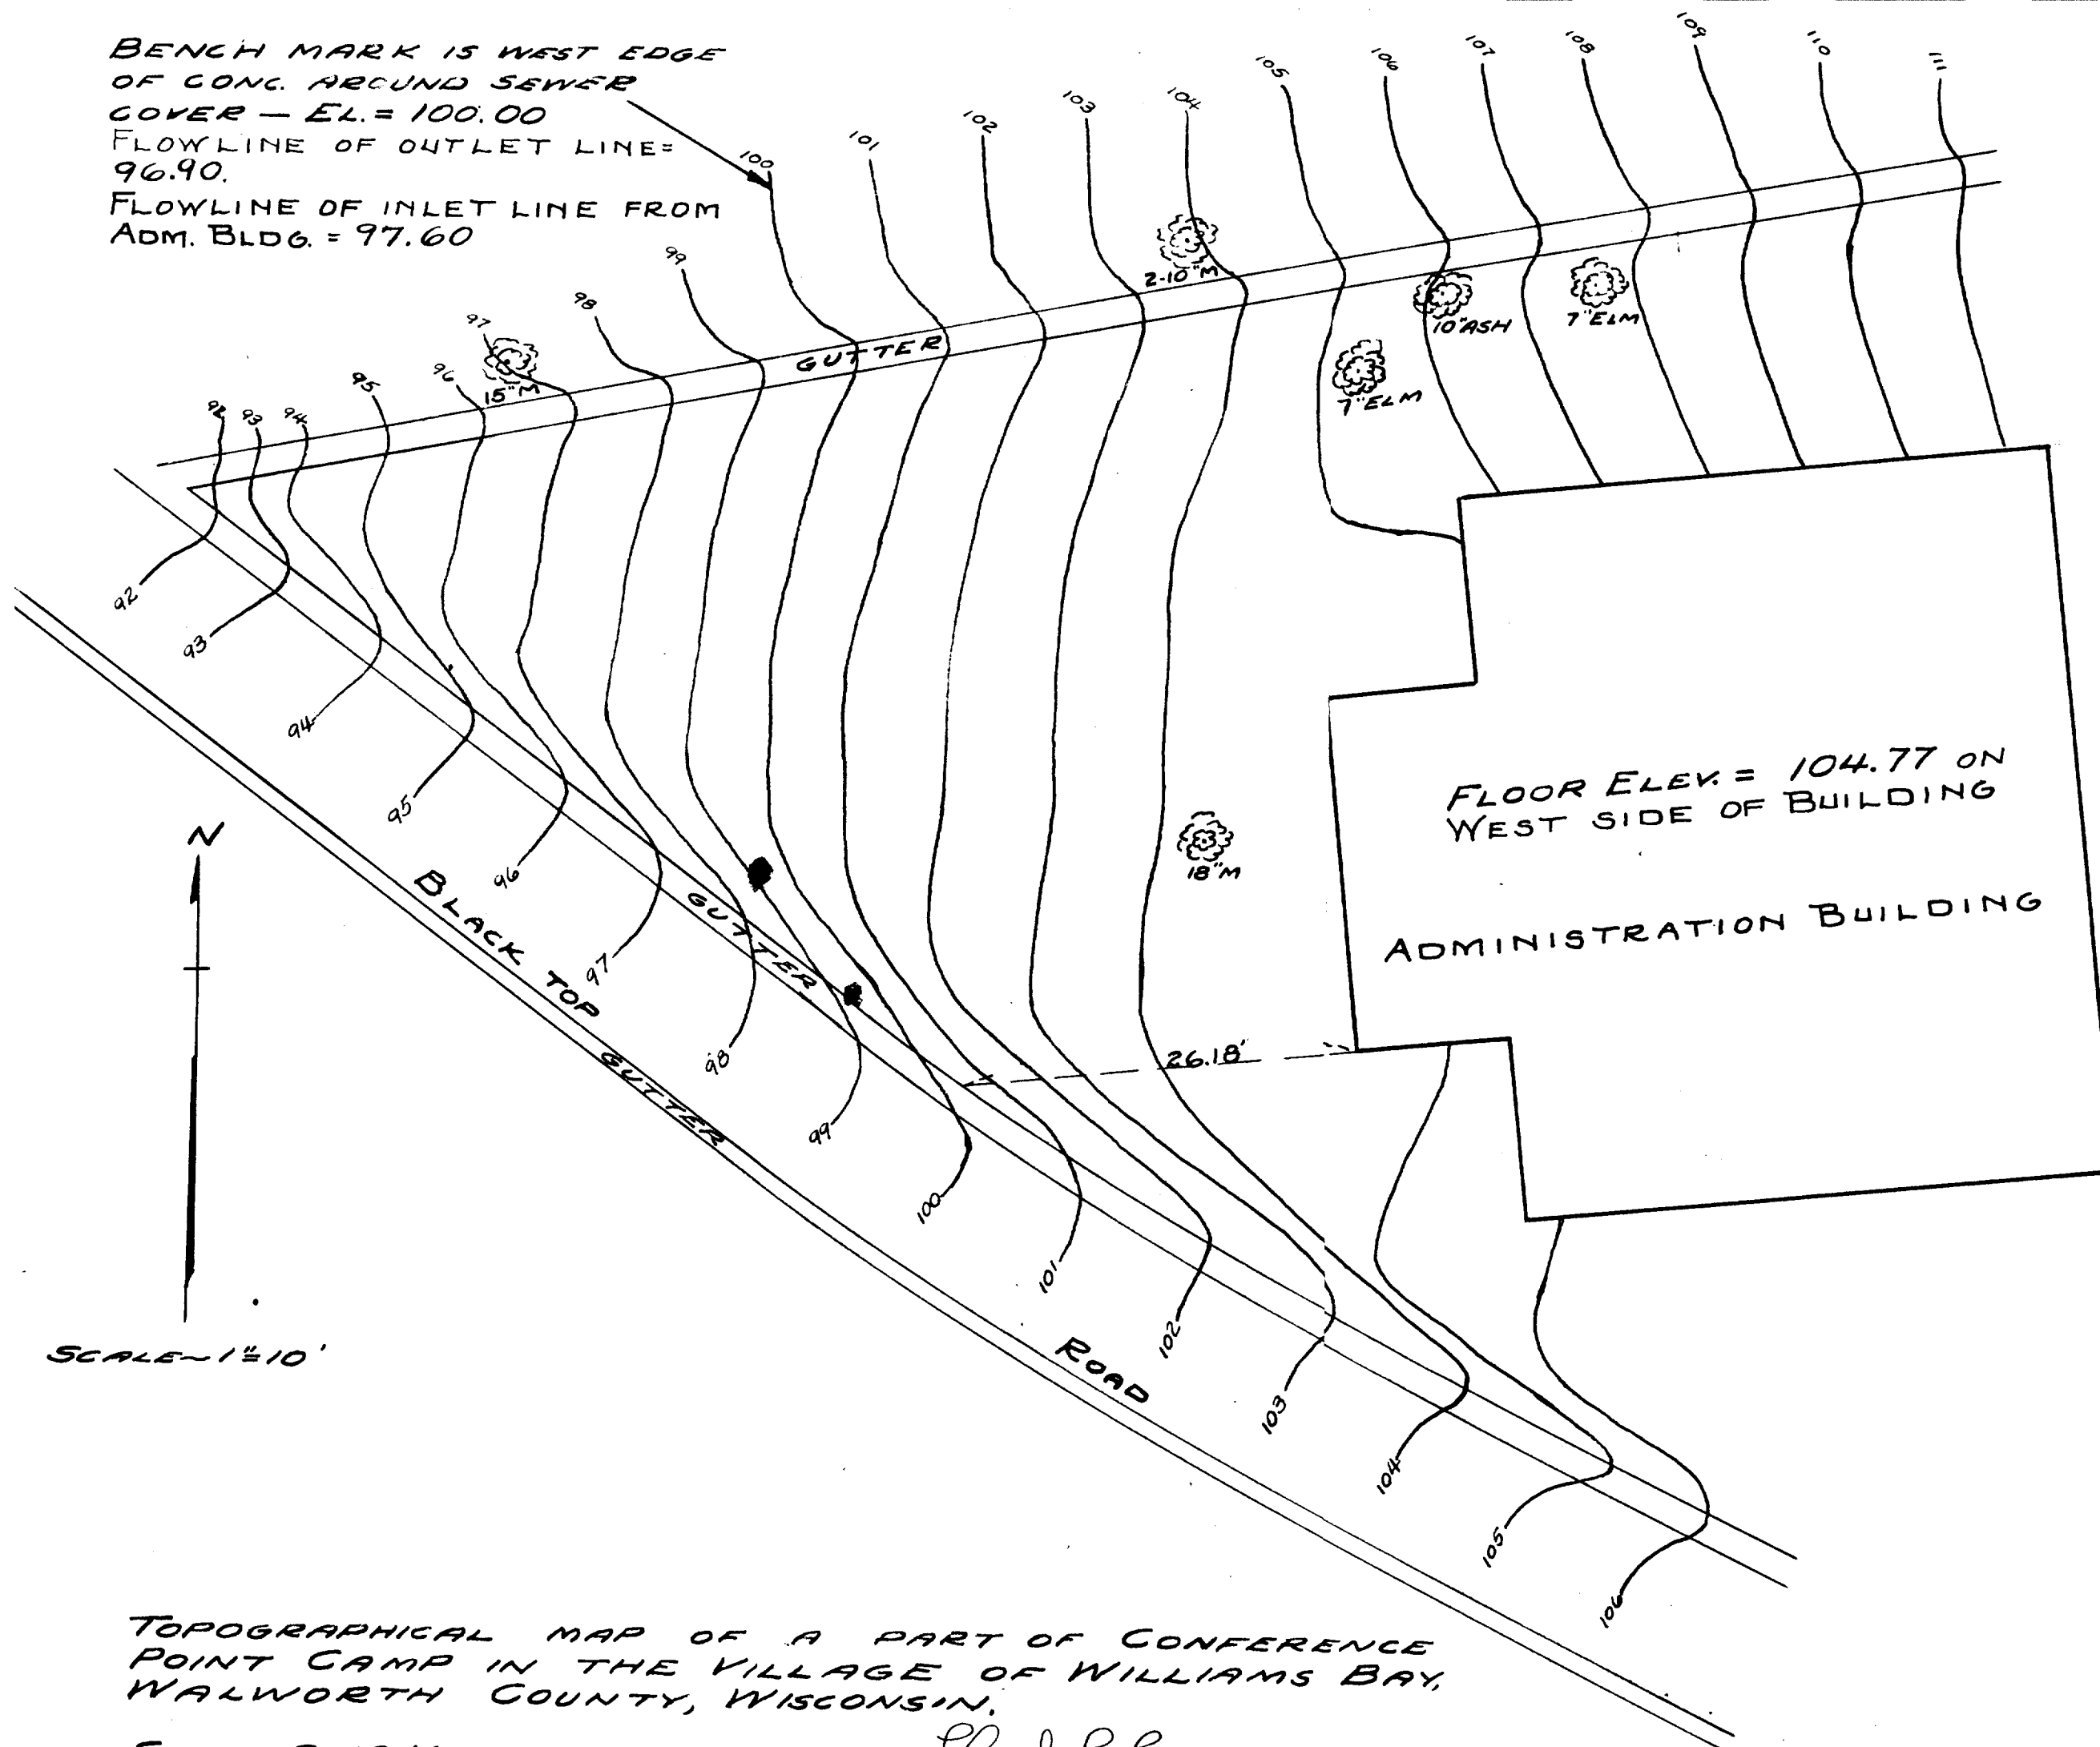

SCALE - 1" = 10'

TOPOGRAPHICAL MAP OF A PART OF CONFERENCE
POINT CAMP IN THE VILLAGE OF WILLIAMS BAY,
WALWORTH COUNTY, WISCONSIN.

SEPT. 9, 1946

UP-72

Lloyd L. Jensen
COUNTY SURVEYOR

11-27 J