


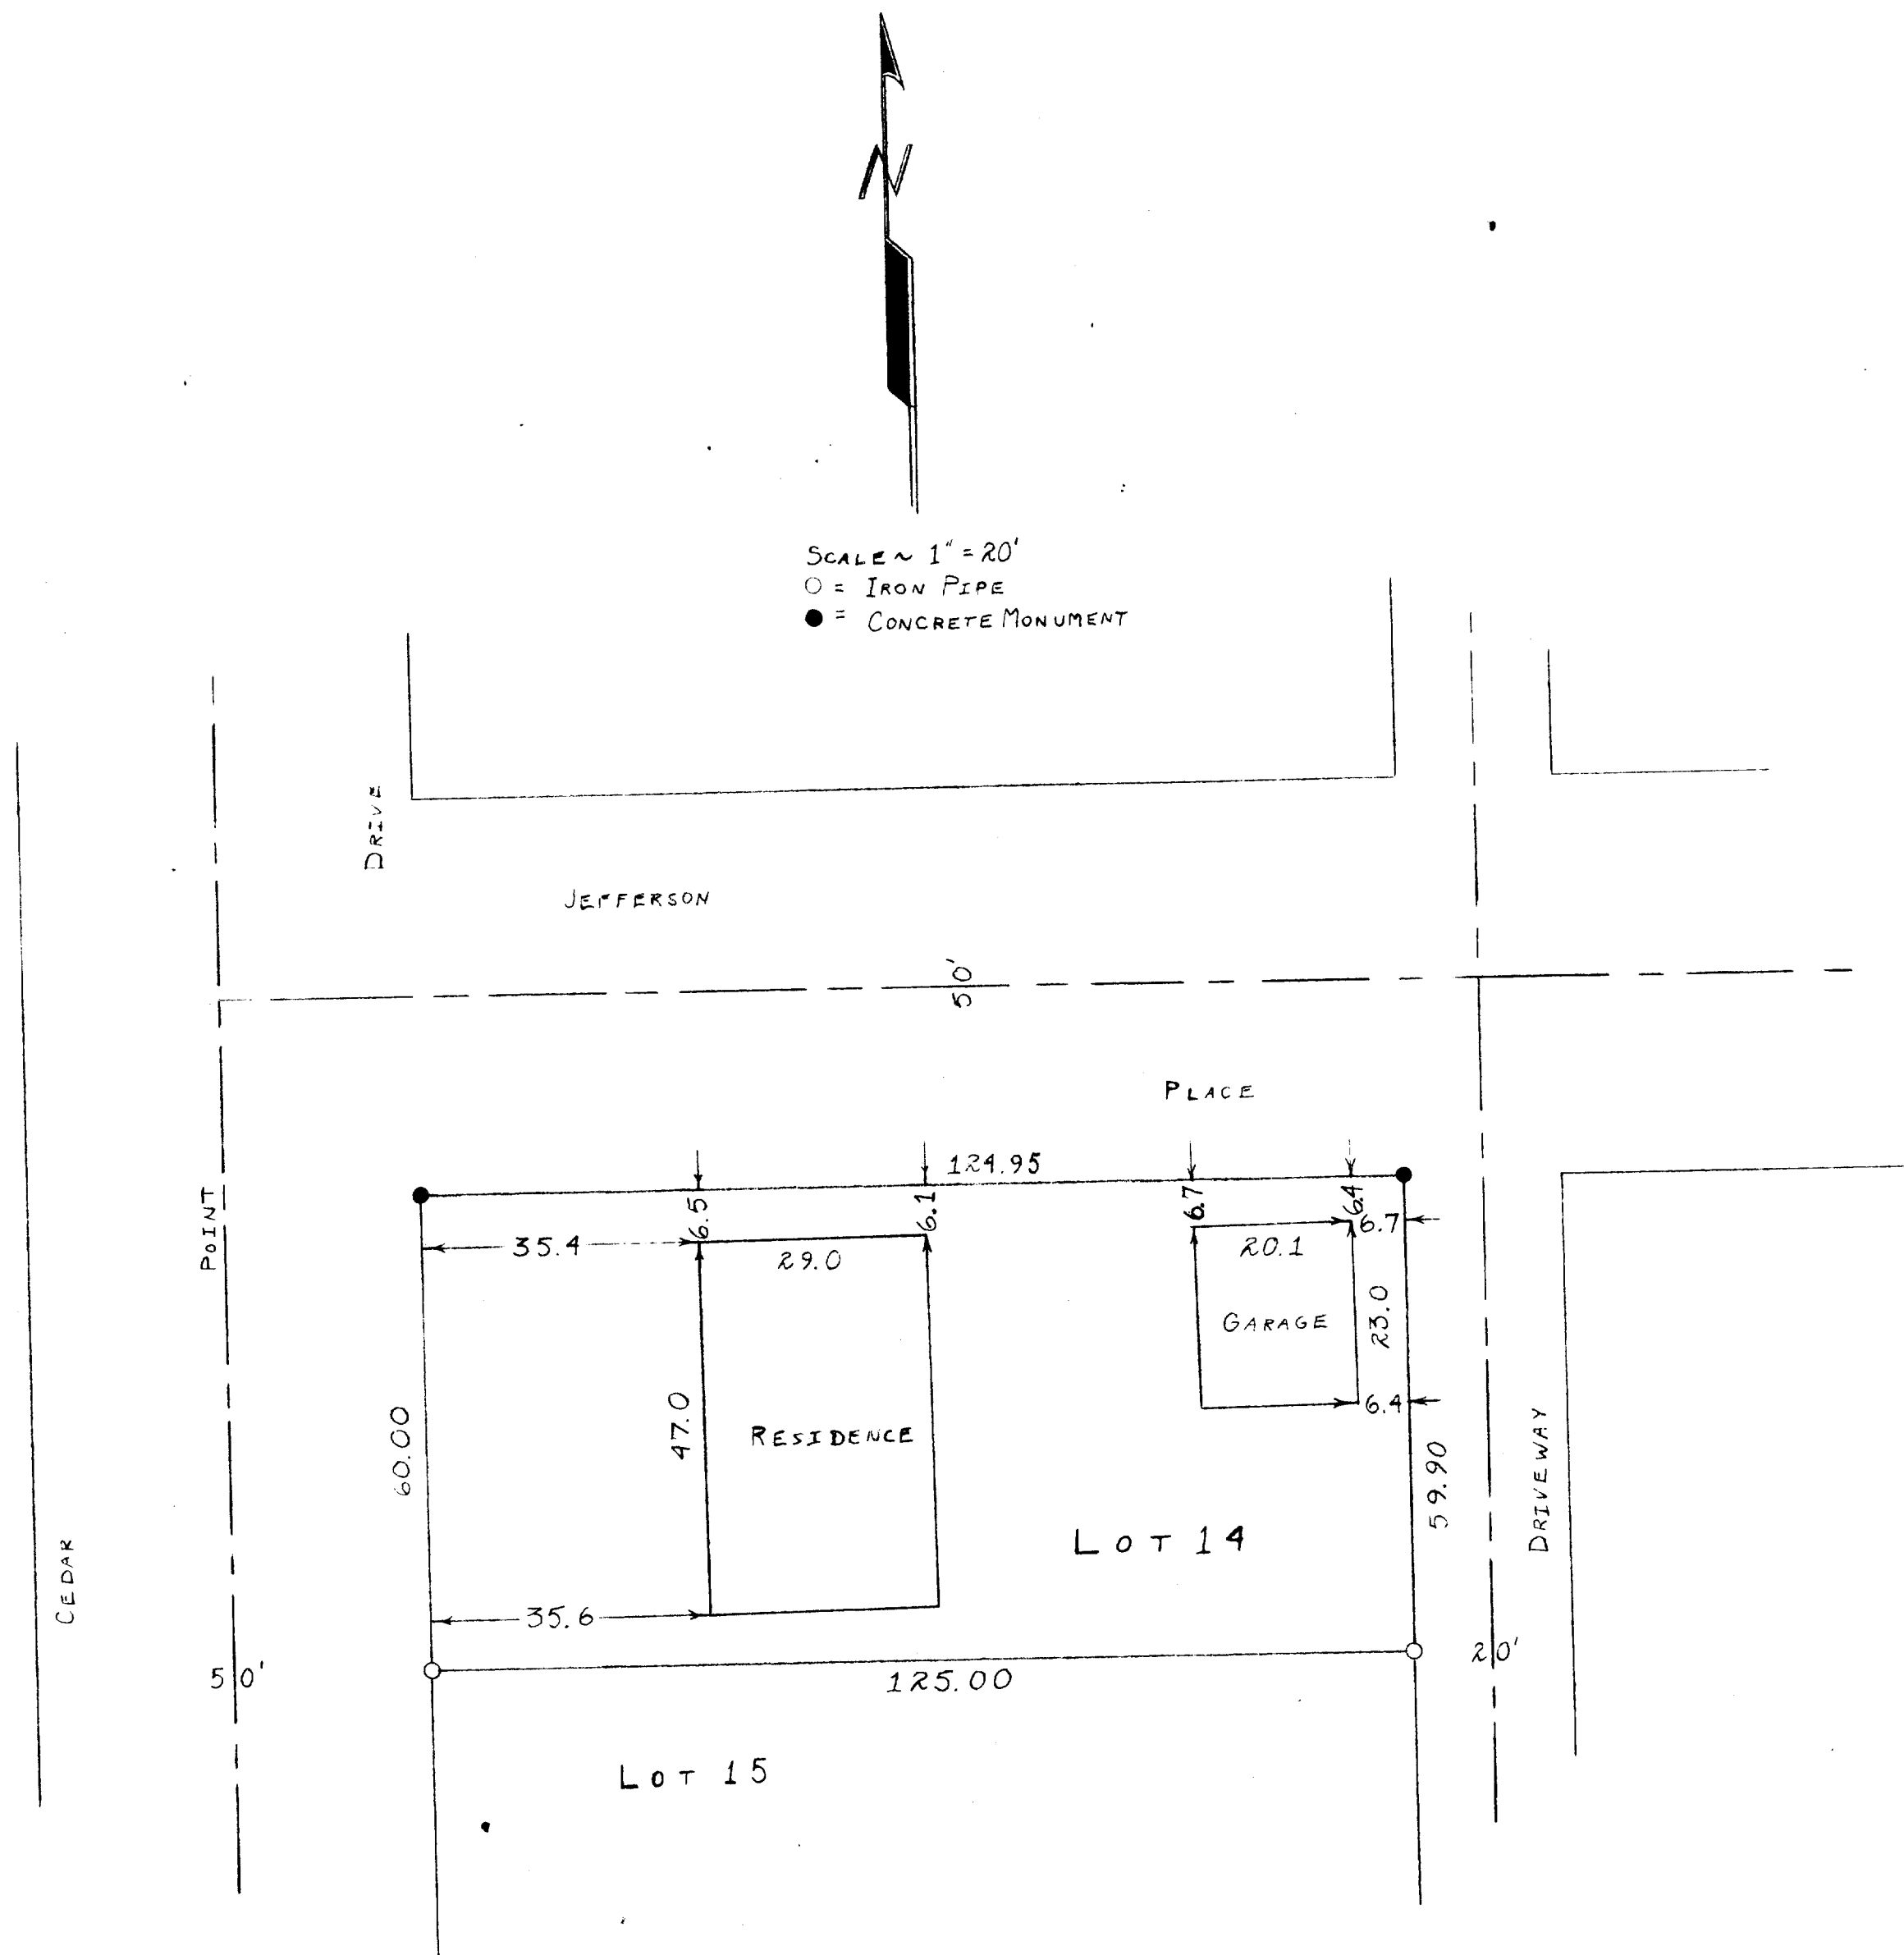

STATE OF WISCONSIN) SS
 WALWORTH COUNTY)

I, GEORGE T. DUNHAM, DO HEREBY CERTIFY THAT I HAVE
 SURVEYED THE PROPERTY DESCRIBED AS FOLLOWS:
 LOT 14 OF CEDAR POINT PARK, VILLAGE OF WILLIAMS BAY,
 WALWORTH COUNTY, WISCONSIN

AND THAT THE ABOVE PLAT IS A CORRECT REPRESENTATION OF THE
 PROPERTY LINES AND THE IMPROVEMENTS LOCATED THEREON.
 JULY 14, 1959

George T. Dunham
 GEORGE T. DUNHAM, SURVEYOR
 DELAWARE, WISCONSIN