


PLAT OF SURVEY – AS BUILT RESIDENCE

LOT 5, BLOCK 2 OF PRAIRIE VIEW SUBDIVISION

REC. IN CAB. C, SLIDE 195, AS DOC. NO. 623223
 LOCATED IN PART OF THE NW 1/4 AND NE 1/4 OF THE NE 1/4
 OF SECTION 2, TOWN 1 NORTH, RANGE 16 EAST, VILLAGE OF WILLIAMS BAY,
 WALWORTH COUNTY, WISCONSIN

GRID
 NORTH
 WISCONSIN STATE PLANE COORDINATE SYSTEM
 SOUTH ZONE (NAD-27)
 E. LINE OF THE NE 1/4 OF
 SECTION 2-1-16 BEARS S 00°08'45" W

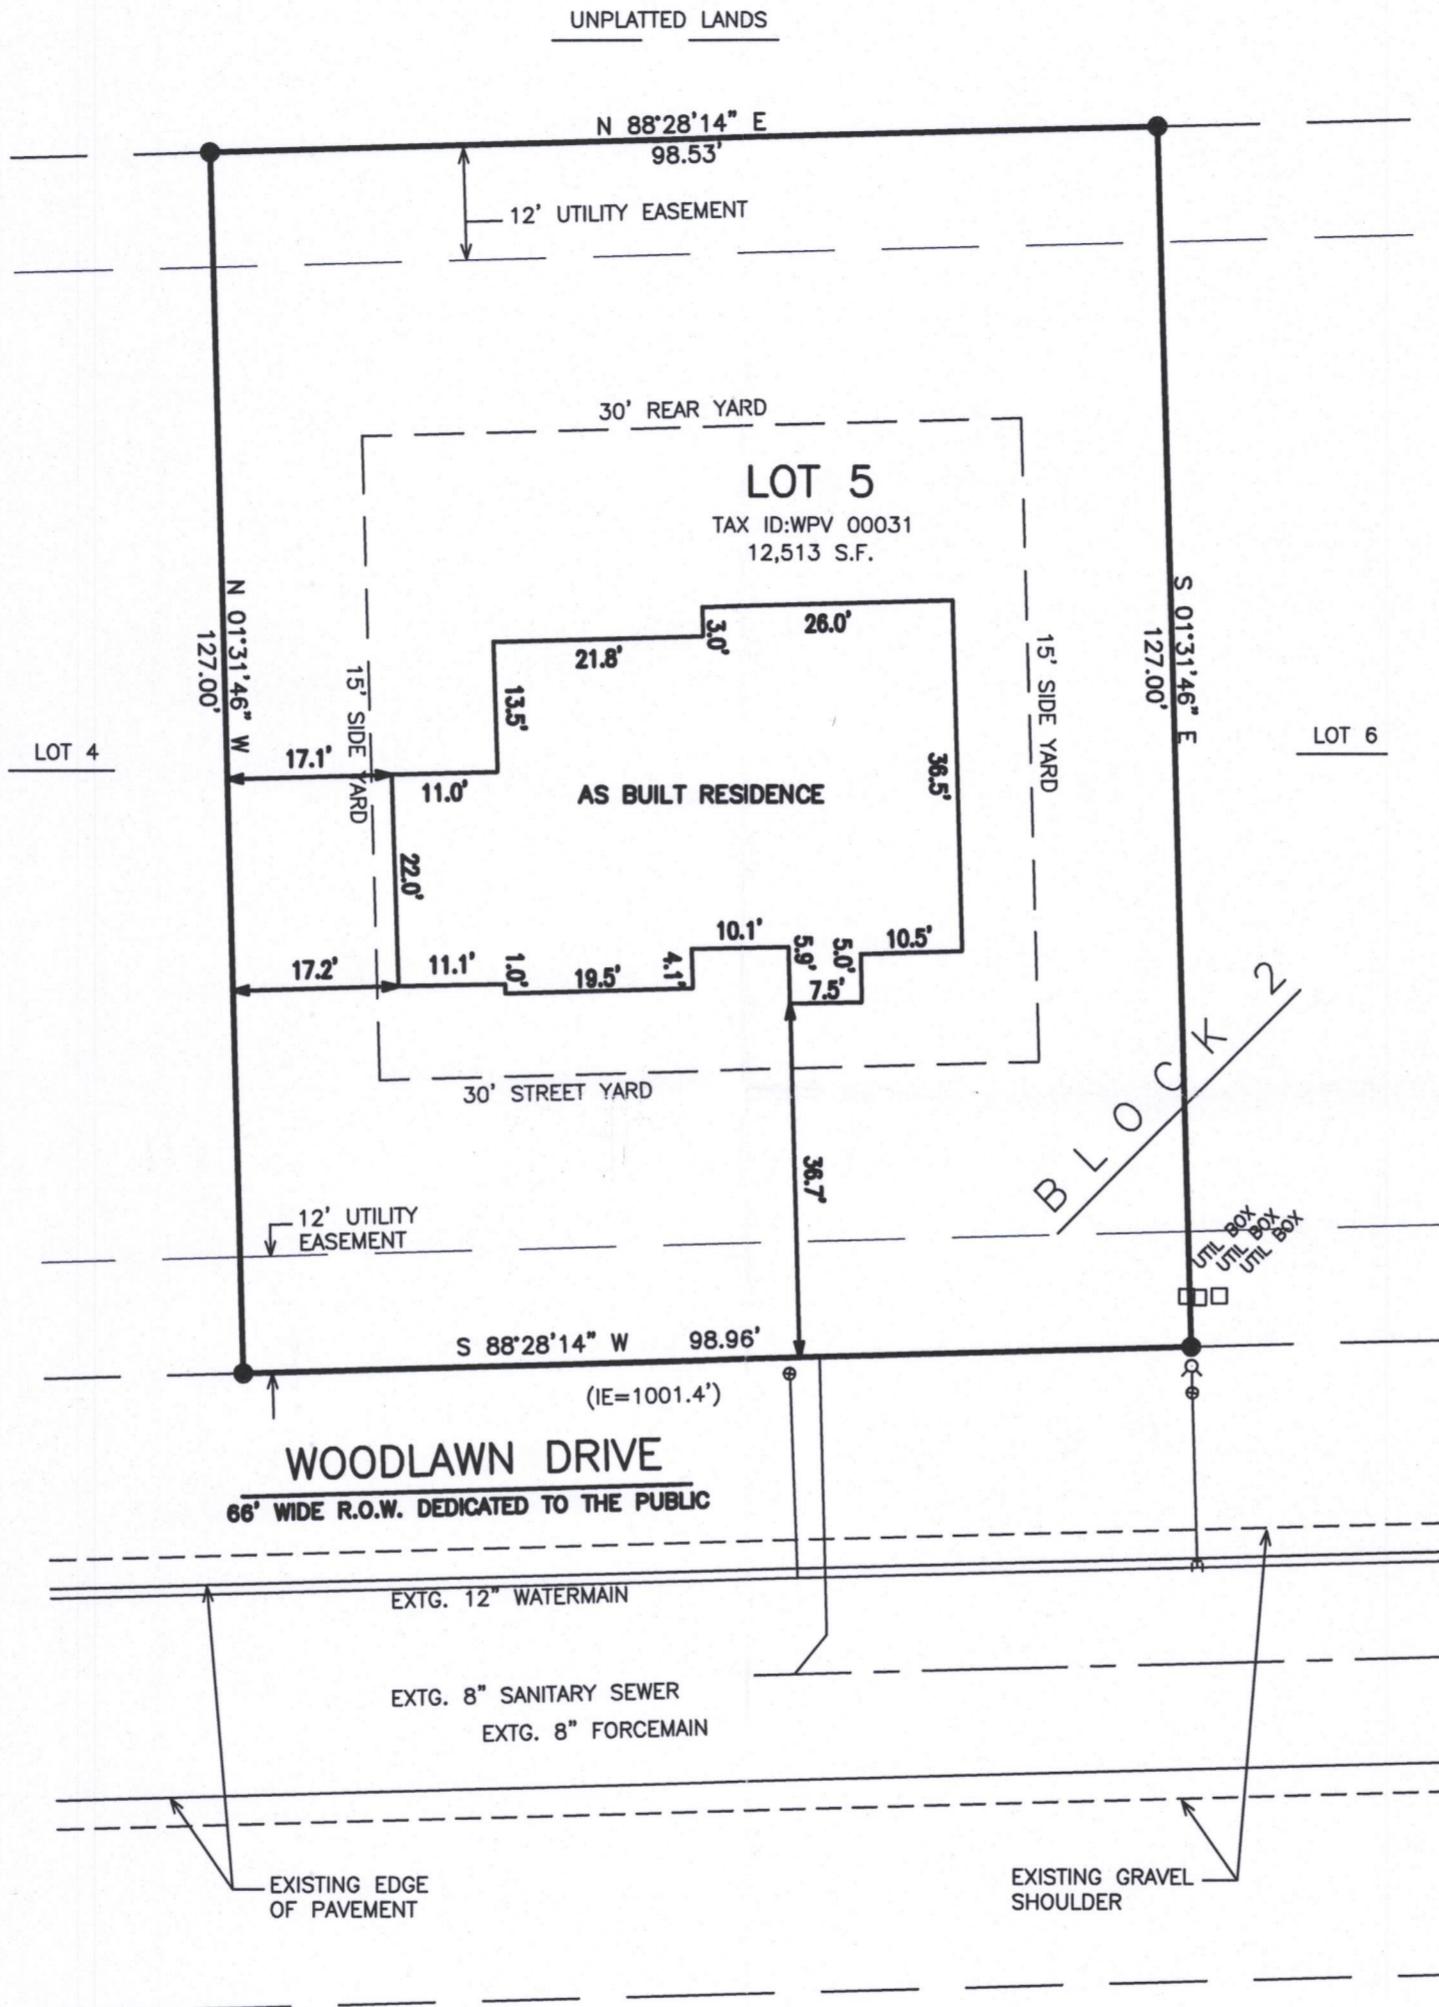


LEGEND

- = FOUND IRON PIPE STAKE, 1 3/8" O.D.
- ✖ = FOUND IRON REBAR STAKE, 3/4" DIA.
- = FOUND CONCRETE COUNTY MONUMENT WITH BRASS CAP
- = SET SOLID ROUND IRON BAR STAKE, 1 5/16" x 30" x 4.60 lbs./ft.
- {XXX} = RECORDED AS

ALL OTHER LOT AND OUTLOT CORNERS ARE
 SET IRON REBAR STAKES, 3/4" x 24" x
 1.50 lbs./ft.

20 10 0
20 40 60 80
MAP SCALE IN FEET – ORIGINAL 1"=20'

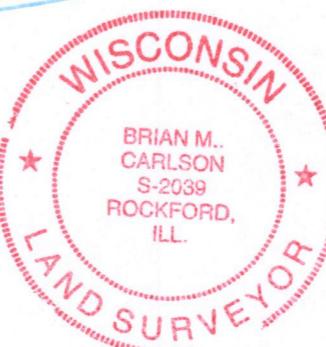

NOTE: COPIES OF THIS MAP TO WHICH THE FOLLOWING CERTIFICATE WILL APPLY SHOW THE SURVEYOR'S ORIGINAL SEAL AND SIGNATURE IN RED INK. COPIES BY ANY OTHER MEANS MAY HAVE ALTERATIONS WHICH DO NOT REPRESENT THE SURVEYOR'S WORK PRODUCT.

I HEREBY CERTIFY THAT THE ABOVE DESCRIBED PROPERTY HAS BEEN SURVEYED UNDER MY DIRECTION AND THAT THE ABOVE MAP IS A TRUE REPRESENTATION THEREOF AND SHOWS THE SIZE AND LOCATION OF THE PROPERTY AND ITS EXTERIOR BOUNDARIES. THIS SURVEY IS MADE FOR THE USE OF THE PRESENT OWNERS OF THE PROPERTY, AND ALSO THOSE WHO PURCHASE, MORTGAGE, OR GUARANTEE THE TITLE THERETO WITHIN ONE YEAR FROM THE DATE HEREOF.

DATED: JULY 29, 2005

12/07/2017 REVISED TO
SHOW SIZE AND LOCATION
OF AS BUILT RESIDENCE.

BRIAN M. CARLSON P.L.S. 2039

FARRIS, HANSEN & ASSOCIATES, INC.

ENGINEERING – ARCHITECTURE – SURVEYING
 7 RIDGWAY COURT
 P.O. BOX 437
 ELKHORN, WISCONSIN 53121
 OFFICE: (262) 723-2098
 FAX: (262) 723-5886

REVISIONS

09/14/2017 – LB
 ADD PROP. RES.

09/20/2017 – LB
 CHANGE PROP. RES.

12/07/2017 – LB
 AS BUILT

PROJECT NO.
5825.02.05

DATE:
07/29/2005

SHEET NO.
1 OF 1