


AS-BUILT SURVEY  
LOT 24 OF BLOCK 1 OF PRAIRIE VIEW SUBDIVISION

LOCATED IN PART OF THE NW 1/4 OF THE NE 1/4  
OF SECTION 2, TOWN 1 NORTH, RANGE 16 EAST,  
VILLAGE OF WILLIAMS BAY, WALWORTH COUNTY, WISCONSIN

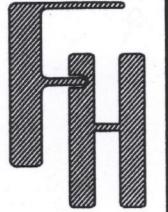


PLAT OF SURVEY - PERMIT  
LOT 24 BLOCK 1 PRAIRIE VIEW SUBDIVISION  
WILLIAMS BAY, WI 53191

- WORK ORDERED BY  
SHODEEN  
17 N. 1ST STREET - SU  
GENEVA, IL 60134

ENGINEERING — ARCHITECTURE — SURVEYING  
7 RIDGWAY COURT P.O. BOX 437  
ELKHORN, WISCONSIN 53121  
OFFICE: (262) 723-2098 FAX: (262) 723-5886

REVISIONS  
1/29/2018 - LB  
ERMIT

PROJECT NO.  
5825.01.24  
DATE:  
07/28/2005  
SHEET NO.  
1 OF 1

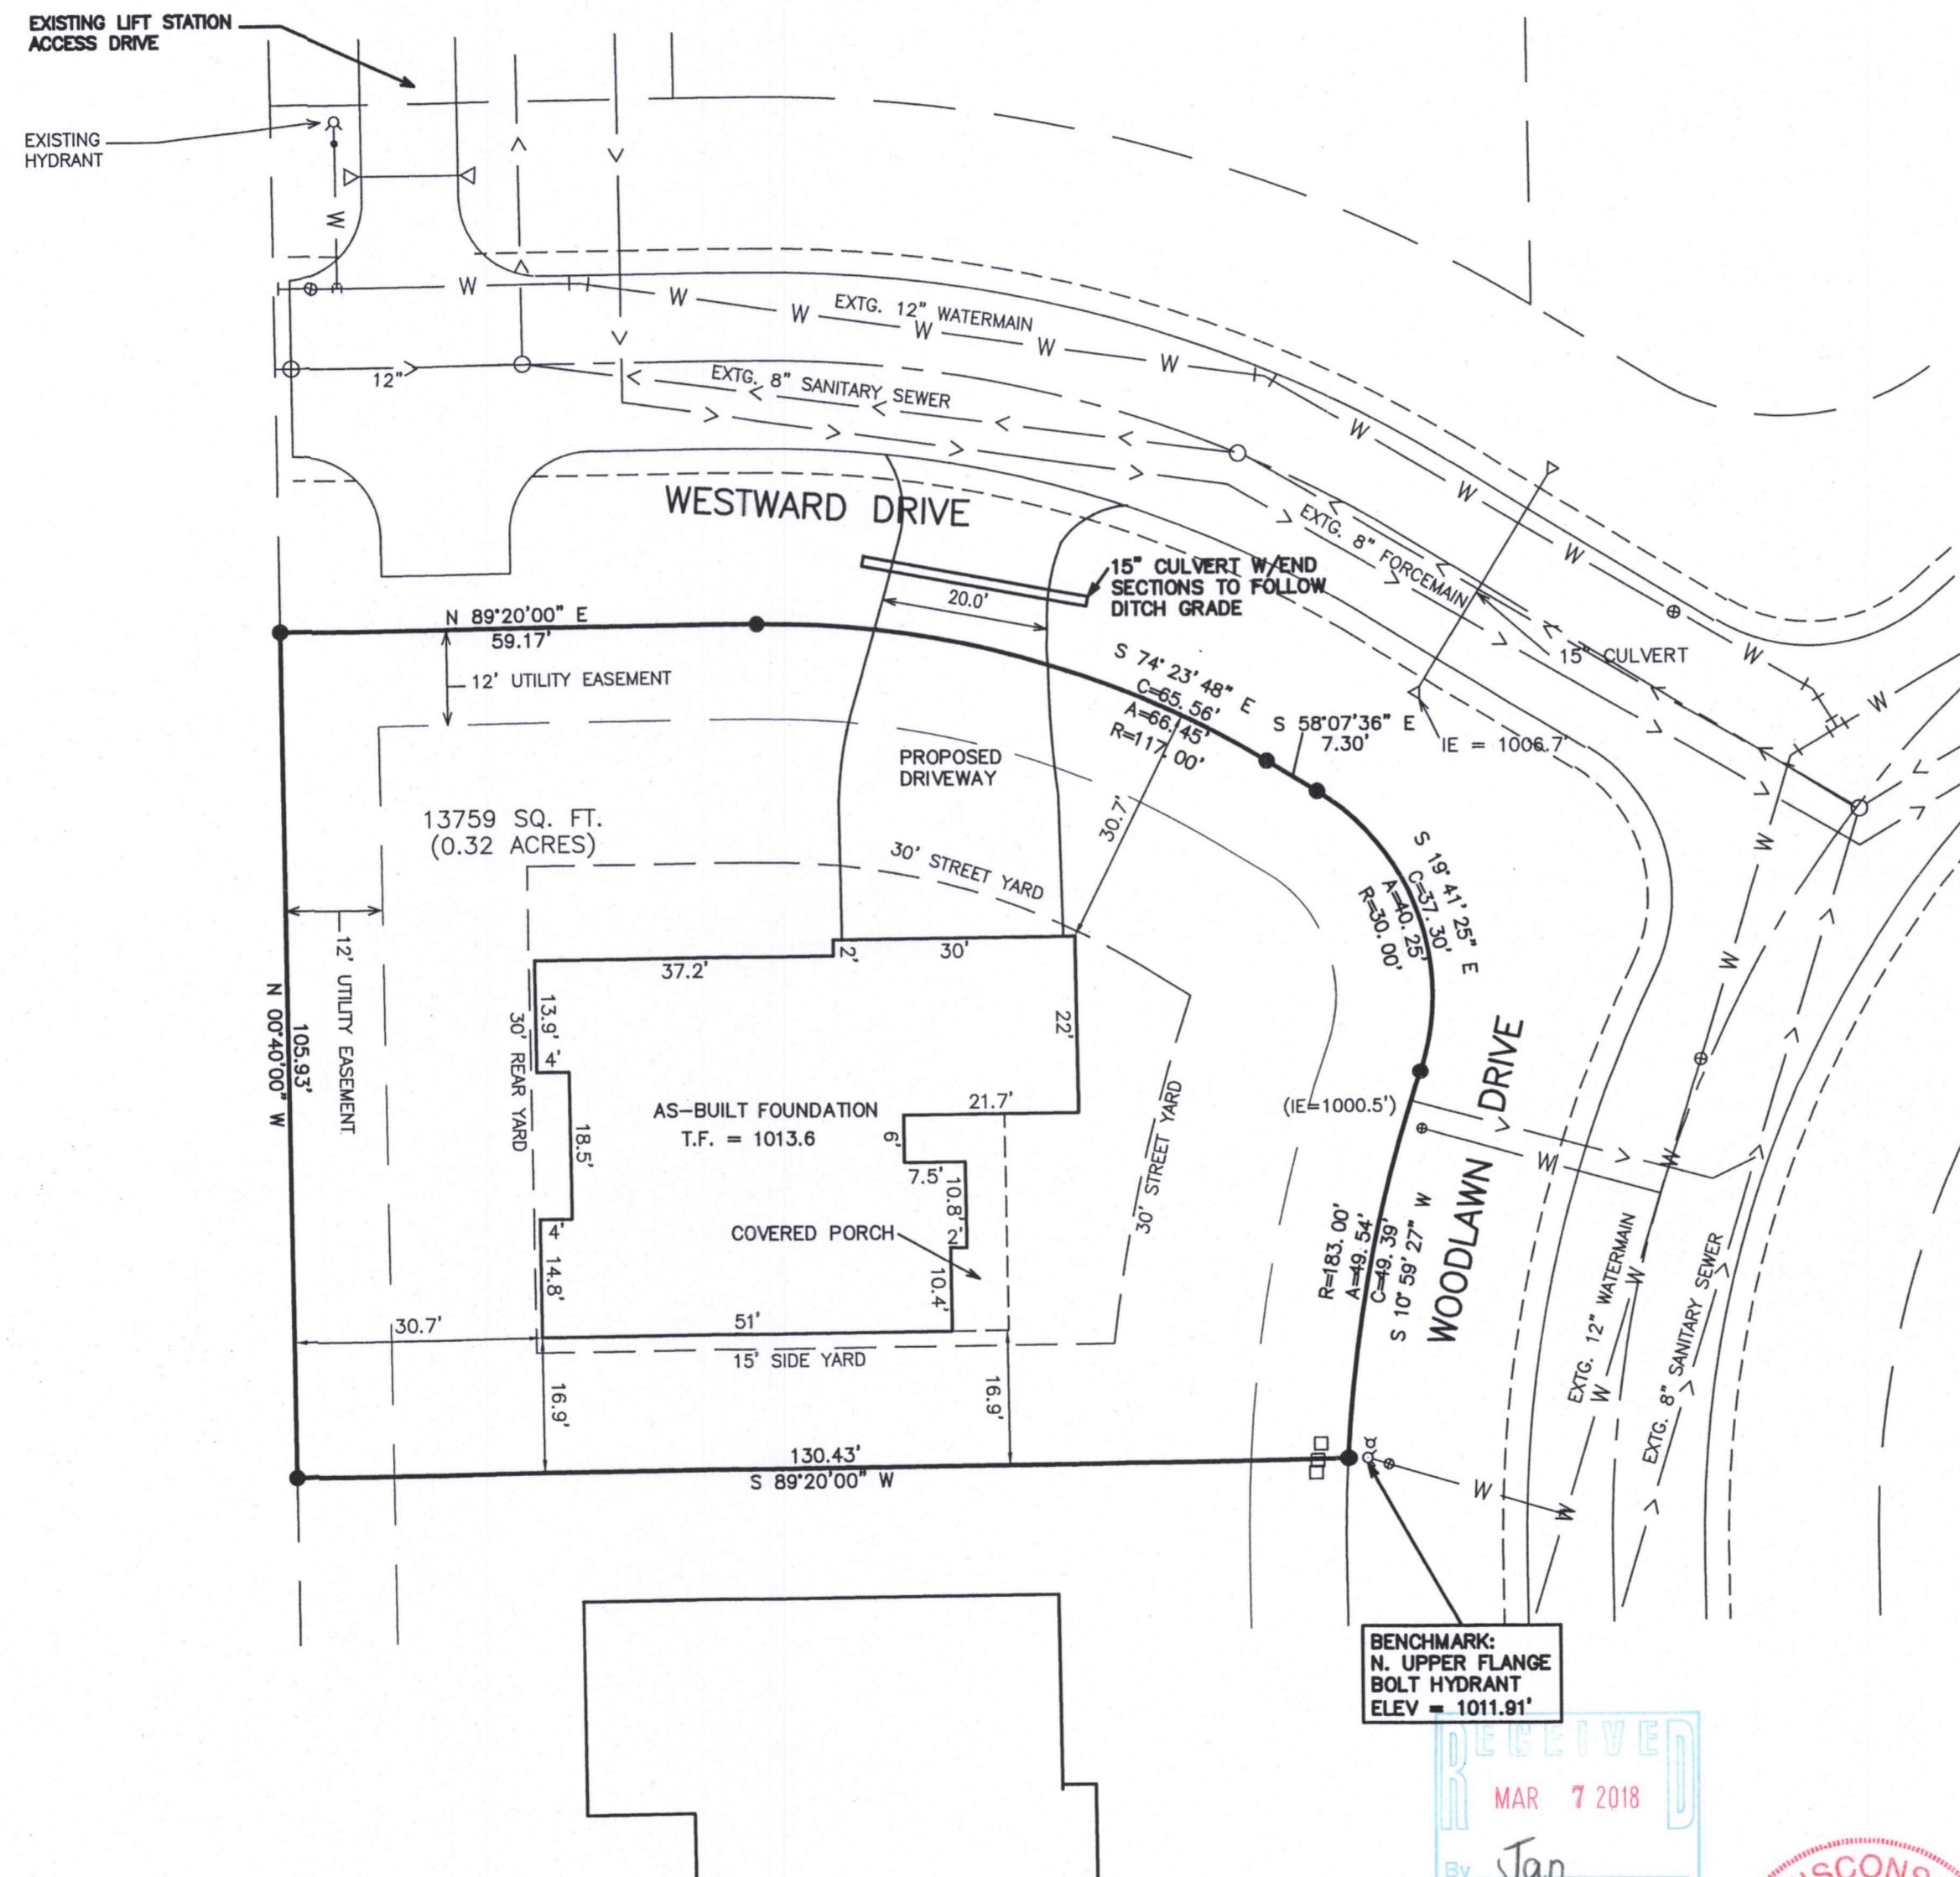

NOTE: COPIES OF THIS MAP TO WHICH THE FOLLOWING CERTIFICATE WILL APPLY SHOW THE SURVEYOR'S ORIGINAL SEAL AND SIGNATURE IN RED INK. COPIES BY ANY OTHER MEANS MAY HAVE ALTERATIONS WHICH DO NOT REPRESENT THE SURVEYOR'S WORK PRODUCT.

I HEREBY CERTIFY THAT THE ABOVE DESCRIBED PROPERTY HAS BEEN SURVEYED  
UNDER MY DIRECTION AND THAT THE ABOVE MAP IS A TRUE REPRESENTATION  
THEREOF AND SHOWS THE SIZE AND LOCATION OF THE PROPERTY AND ITS EXTERIOR  
BOUNDARIES. THIS SURVEY IS MADE FOR THE USE OF THE PRESENT OWNERS OF THE  
PROPERTY, AND ALSO THOSE WHO PURCHASE, MORTGAGE, OR GUARANTEE THE TITLE  
THERETO WITHIN ONE YEAR FROM THE DATE HEREOF.

DATED: 07/28/2005

01/29/2018 - REVISED TO  
SHOW SIZE AND LOCATION  
OF PROPOSED RESIDENCE

02/23/2018 - REVISED TO  
SHOW SIZE AND LOCATION  
OF NEW FOUNDATION

Brian M. Carlson  
BRIAN M. CARLSON P.L.S. 2039

WPV-24

011-2821