




PREPARED FOR
MAC COREY
D'APRILE PROPERTIES

PLAT OF SURVEY

- OF -

LOT 47, FIRST ADDITION TO CEDAR POINT PARK,
ACCORDING TO THE RECORDED PLAT THEREOF, SAID LAND
BEING IN THE VILLAGE OF WILLIAMS BAY, COUNTY OF
WALWORTH COUNTY AND STATE OF WISCONSIN.

PATHFINDER SURVEYING
(a NMB Company)
P.O BOX 322
LAKE GENEVA, WI. 53147
WWW.PATHFINDERSURVEYING.NET
262-248-8303

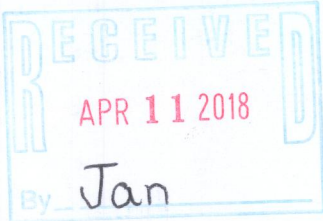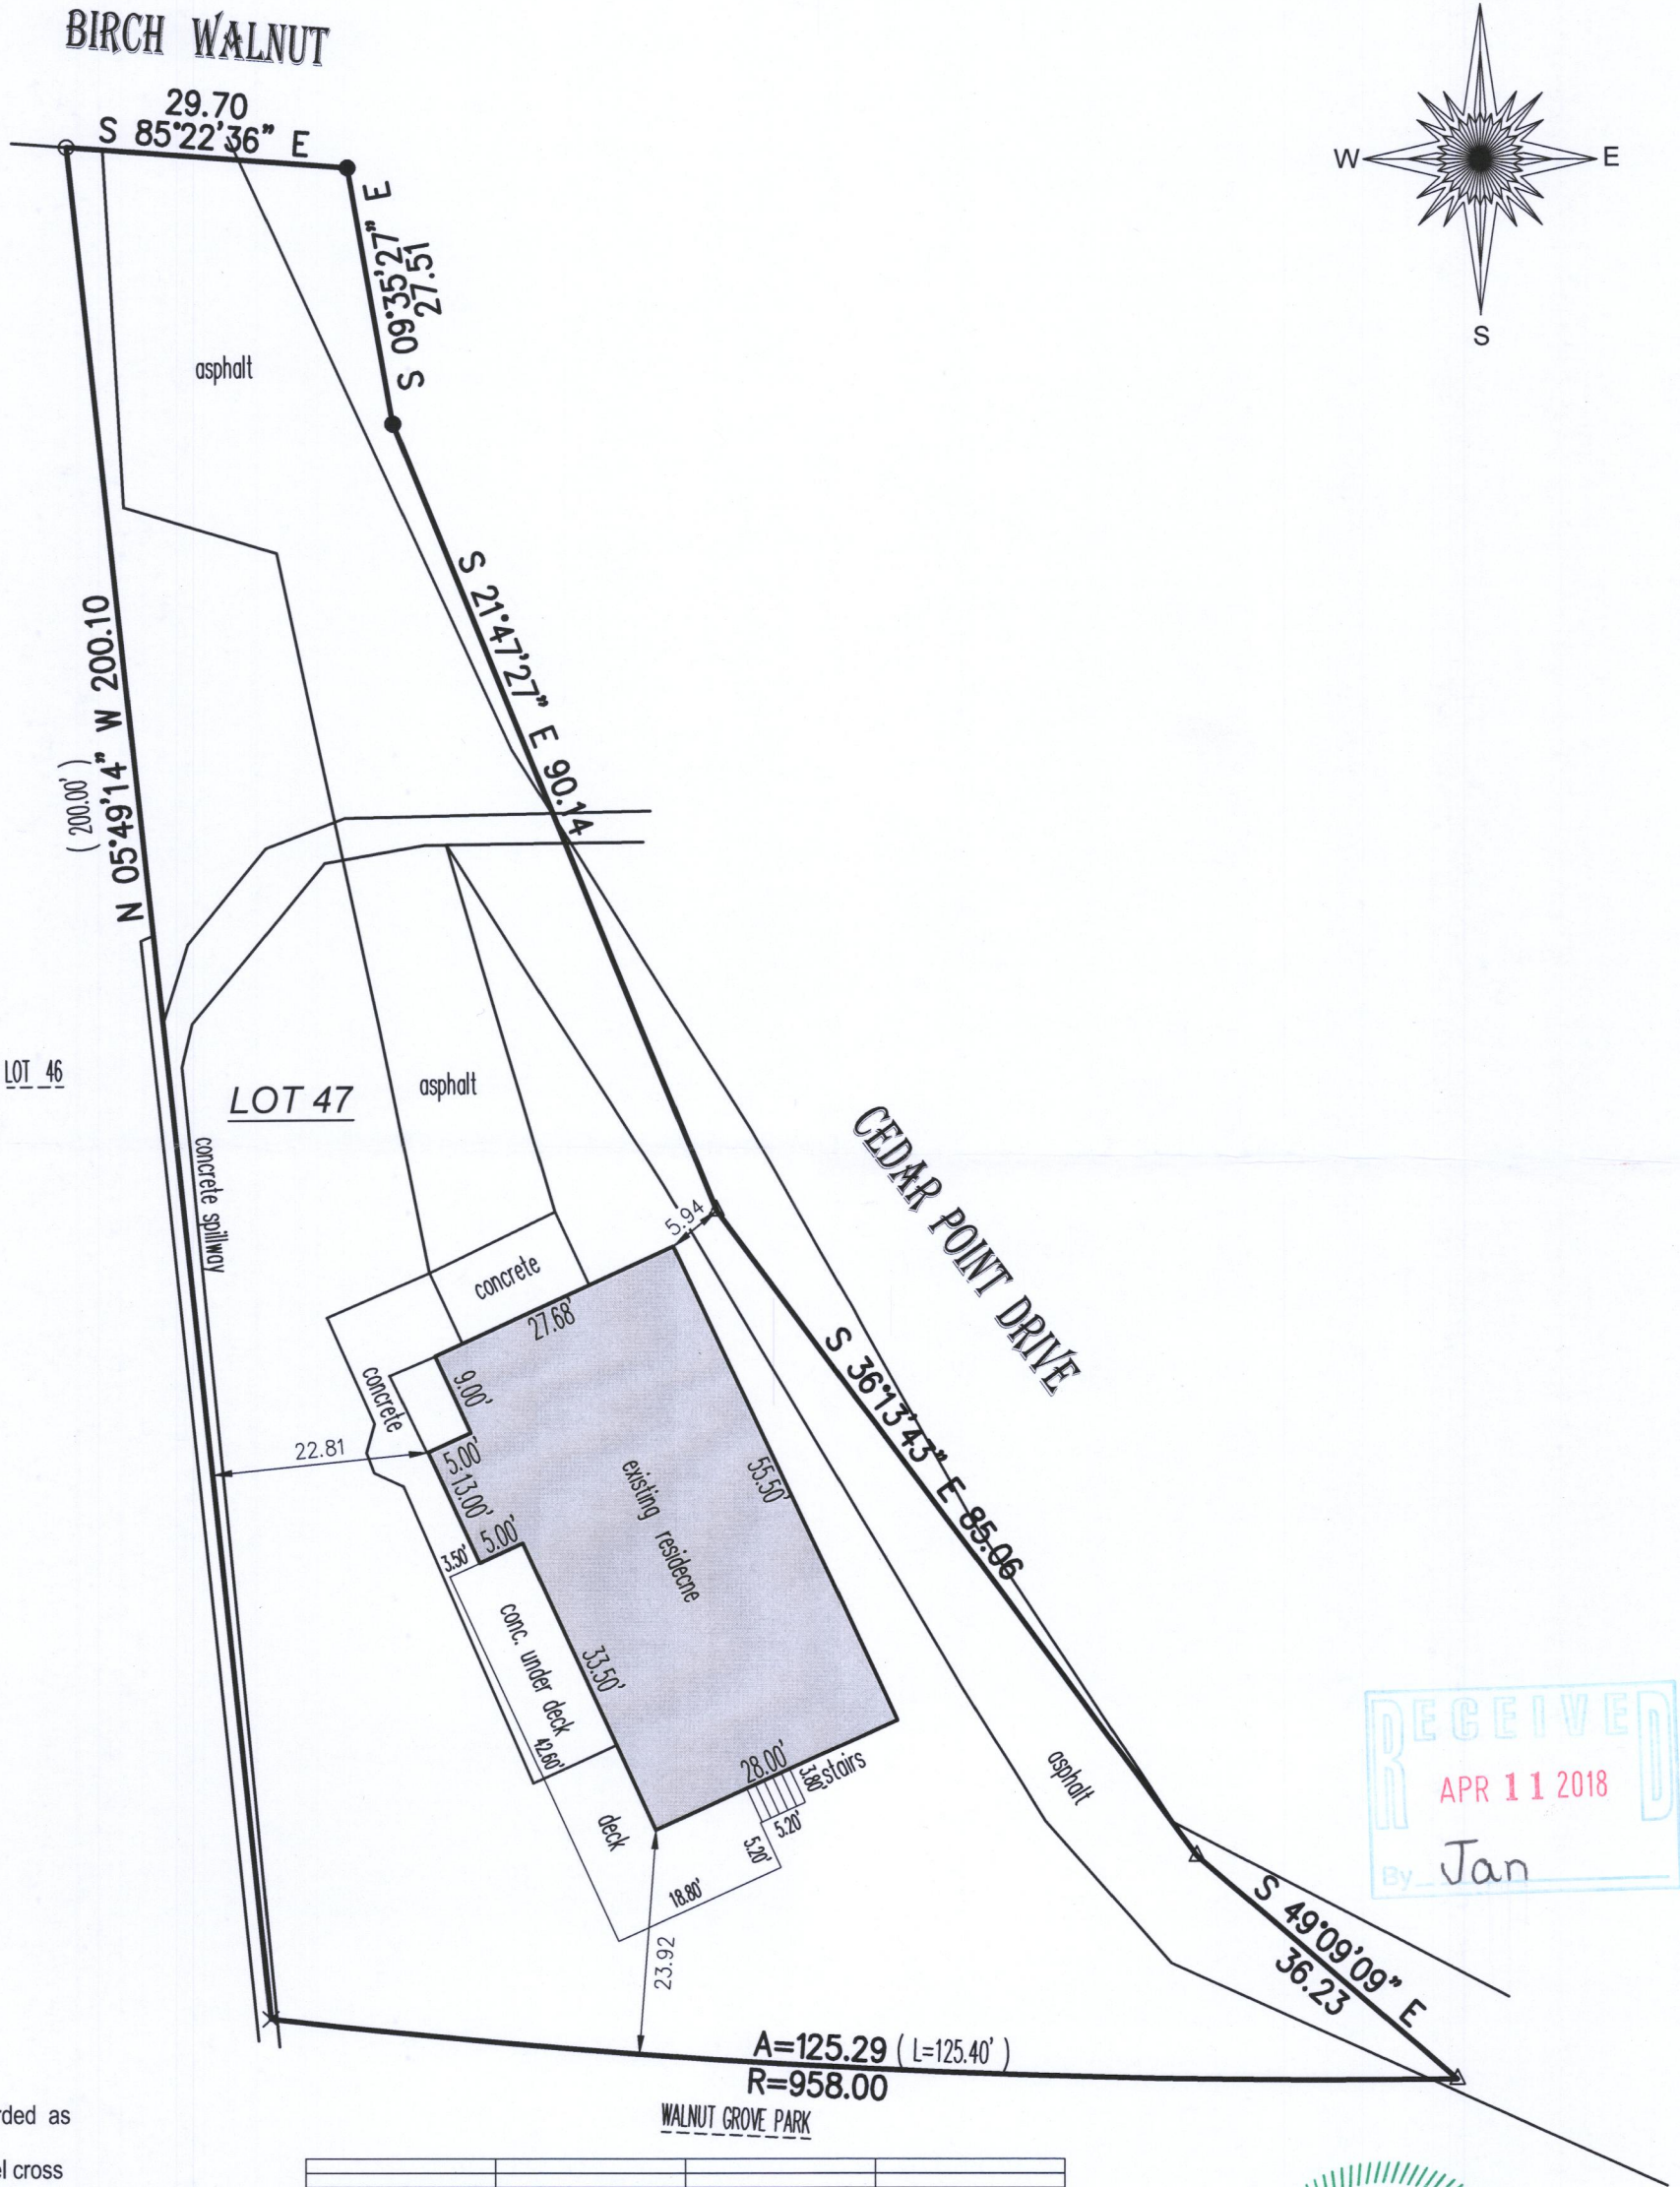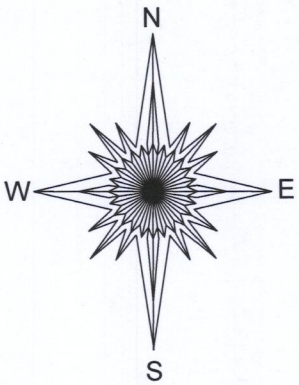


- () = recorded as
- ✕ = chisel cross
- = found iron pipe
- △ = mag nail
- = set iron pipe

SCALE 1" = 20'

JOB # 2017.0264.01

TAX ID # WCP100043

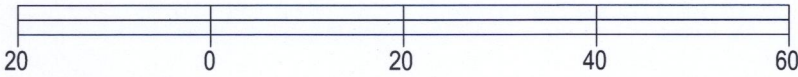

BASIS OF BEARING OF THIS PLAT: THE US STATE PLANE
COORDINATE SYSTEM SOUTH ZONE, NAD 83. WISCORS.

I hereby certify that I have surveyed the above- described property and the
above map is a true representation thereof and shows the size and
location of the property, its exterior boundaries, the location and dimensions
of all structures thereon, fences, apparent easements and roadways and
visible encroachments if any.

This survey is made for the present owners of the property, and those who
purchase, mortgage, or guarantee the title thereto, within one year from the
date hereof.

DATED THIS 16TH DAY OF NOVEMBER, 2017.



Mark R. Madsen
MARK R. MADSEN S - 2271
Wisconsin Professional Land Surveyor

WCP1-43 011-2829