


PLAT OF SURVEY
-OF-

LOT 102 IN BLOCK 1 IN LAKEWOOD TRAILS NORTH SUBDIVISION, LOCATED IN THE NORTHWEST 1/4 AND THE NORTHEAST 1/4 OF THE NORTHWEST 1/4 OF SECTION 1, IN TOWNSHIP 1 NORTH, RANGE 16 EAST OF THE FOURTH PRINCIPAL MERIDIAN, IN THE VILLAGE OF WILLIAMS BAY, COUNTY OF WALWORTH AND STATE OF WISCONSIN.

SURVEY FOR: JOHN LAW OF RE/MAX PLAZA
SURVEY ADDRESS: 426 FAIR OAKS DRIVE, WILLIAMS BAY, WI 53191

CURVE DATA
RADIUS = 193.00'
CENTRAL ANGLE = 21°09'06"
CHORD = 70.85'
CHORD BEARING = S15°35'13"W

BEARINGS HEREON RELATE TO THE NORTH LINE OF LOT 102 OF LAKEWOOD TRAILS NORTH SUBDIVISION. ASSUMED BEARING OF SOUTH 63°50'17" EAST AS PLATTED.


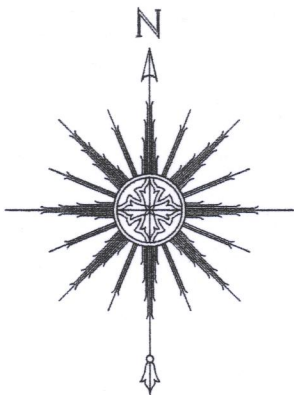


0 15' 30' 60'
SCALE: 1" = 30'

"I HEREBY CERTIFY THAT I HAVE SURVEYED THE ABOVE DESCRIBED PROPERTY AND THAT THE ABOVE MAP IS A CORRECT REPRESENTATION THEREOF AND SHOWS THE SIZE AND LOCATION OF THE PROPERTY, ITS EXTERIOR BOUNDARIES, THE LOCATION OF ALL VISIBLE STRUCTURES AND DIMENSIONS OF ALL PRINCIPAL BUILDINGS THEREON, BOUNDARY FENCES, APPARENT EASEMENTS, ROADWAYS AND ENCROACHMENTS, IF ANY."

"THIS SURVEY IS MADE FOR THE USE OF THE PRESENT OWNERS OF THE PROPERTY, AND THOSE WHO PURCHASE, MORTGAGE, OR GUARANTEE THE TITLE THERETO WITHIN ONE YEAR FROM DATE HEREOF."

SATTER SURVEYING, LLC
LAND SURVEYS, MAPPING AND PLANNING
272 ORIGEN STREET
BURLINGTON, WI 53105
262-661-4239

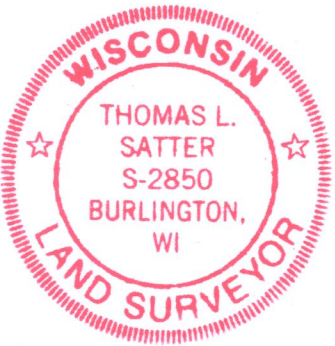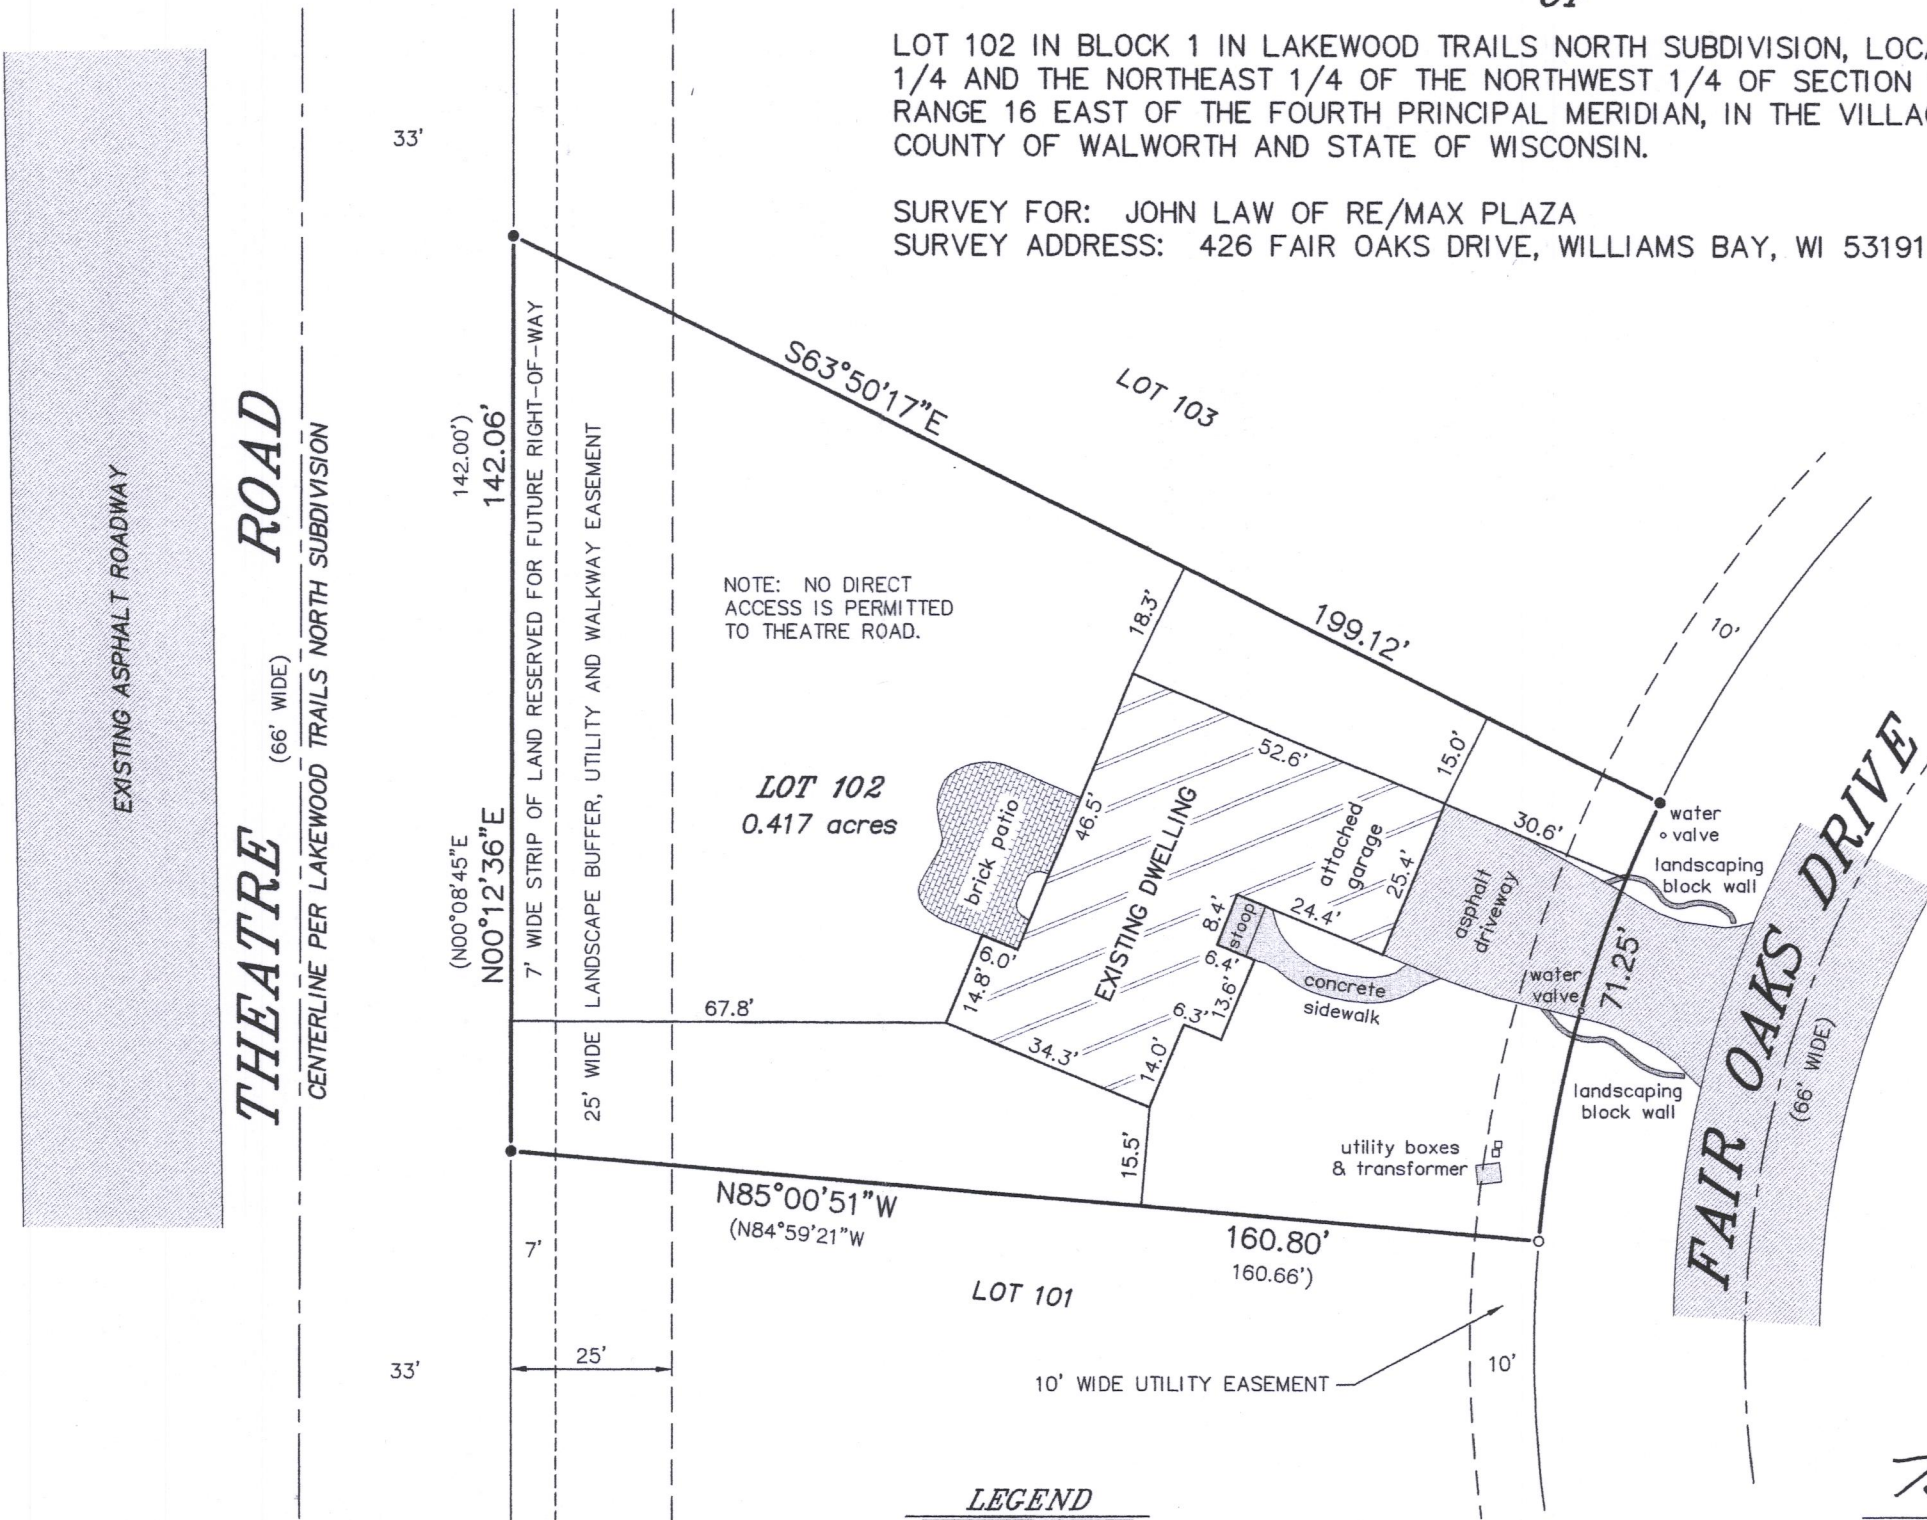

THIS IS NOT AN ORIGINAL PRINT
UNLESS THIS SEAL IS RED.

Thomas L. Satter
THOMAS L. SATTER S-2850

- LEGEND
- FOUND 3/4" DIA. IRON ROD
 - FOUND 1-5/16" O.D. IRON PIPE
 - () RECORDED AS

JUNE 13, 2018 051819
DATE JOB NUMBER

WLAKN-2 011-2841