

PREPARED FOR  
KEEFE REAL ESTATE



ORDERED BY  
DAN OLESTON

PLAT OF SURVEY

- OF -

The South 30 feet of Lot 31 of Lockwood's Subdivision, in the  
Village of Williams Bay, Walworth County, Wisconsin.

PATHFINDER SURVEYING  
(a NMB Company )  
P.O BOX 322  
LAKE GENEVA, WI. 53147  
WWW.PATHFINDERSURVEYING.NET  
262-248-8303

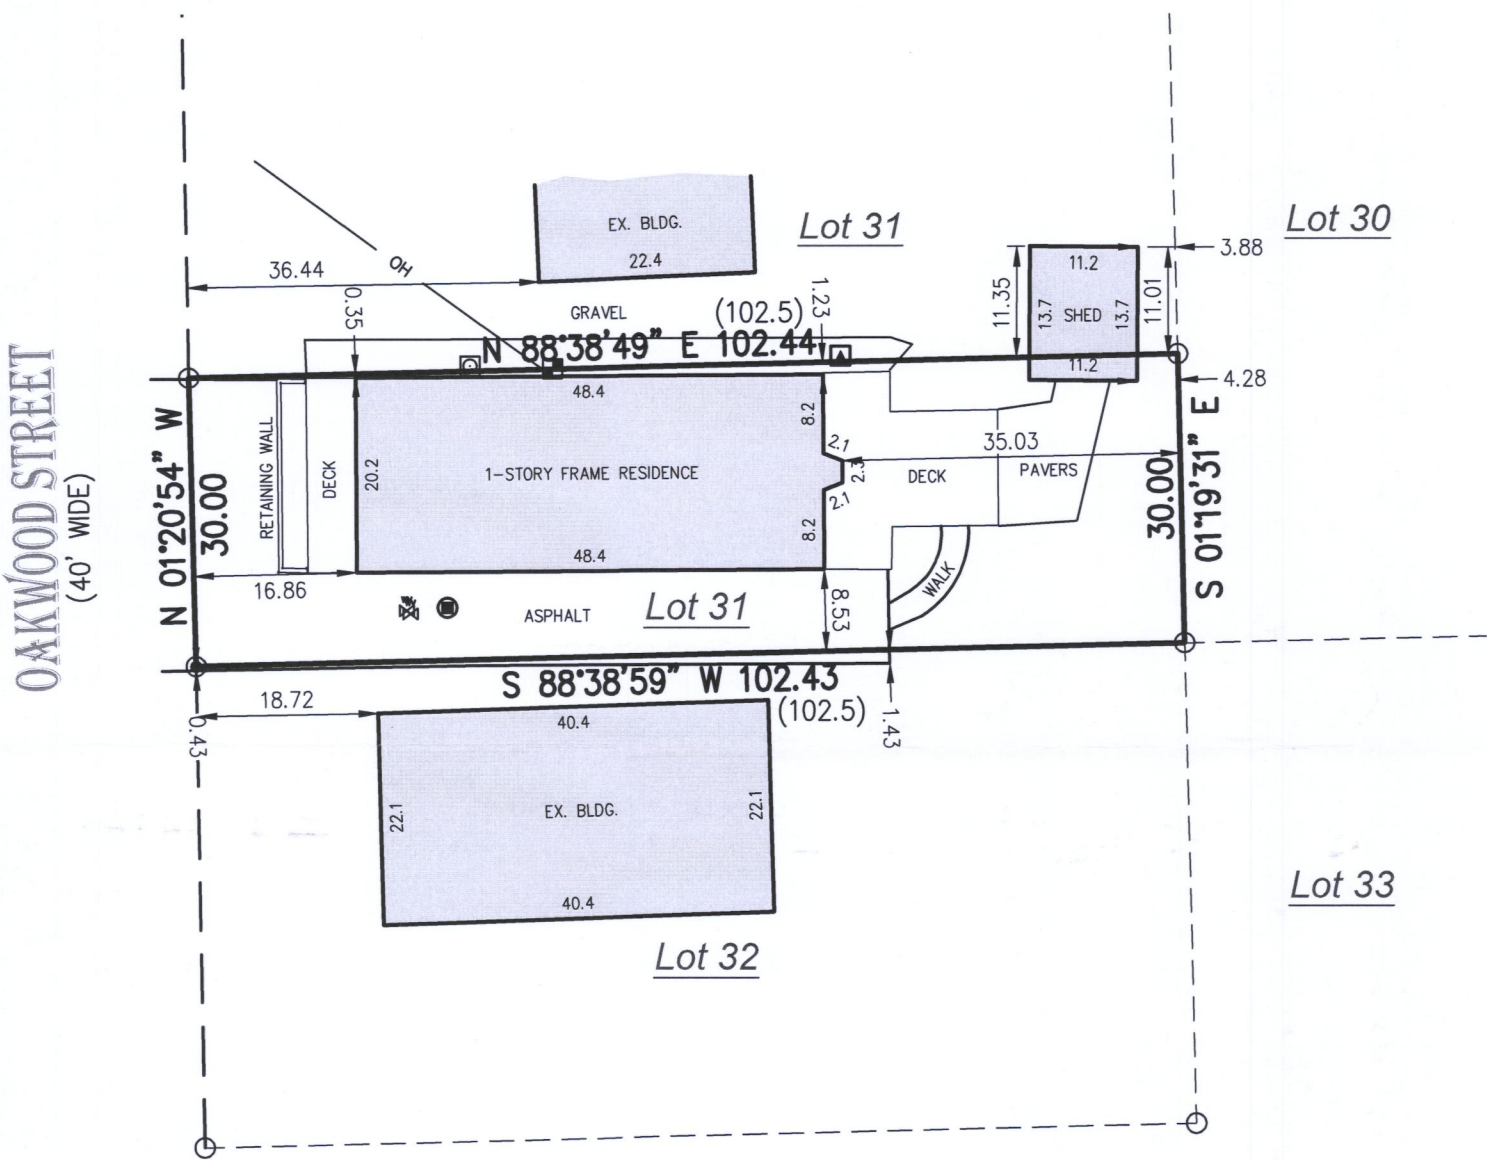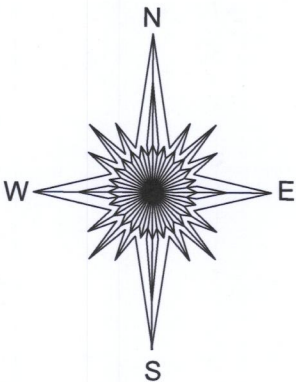


- ( ) = recorded as
- WV = water valve
- = found iron pipe
- OH— = overhead wires
- = electric meter
- ▲ = hvac
- = misc manhole
- = gas meter

SCALE 1" = 20'

JOB # 2018.0097.01

TAX ID # WLW3 00022

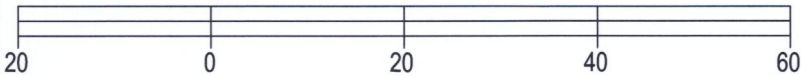


BASIS OF BEARING OF THIS PLAT: THE US STATE PLANE  
COORDINATE SYSTEM SOUTH ZONE, NAD 83. WISCORS.

I hereby certify that I have surveyed the above- described property and the  
above map is a true representation thereof and shows the size and  
location of the property, its exterior boundaries, the location and dimensions  
of all structures thereon, fences, apparent easements and roadways and  
visible encroachments if any to the best of my knowledge and belief.

This survey is made for the present owners of the property, and those who  
purchase, mortgage, or guarantee the title thereto, within one year from the  
date hereof.

DATED THIS 12TH DAY OF APRIL, 2018.

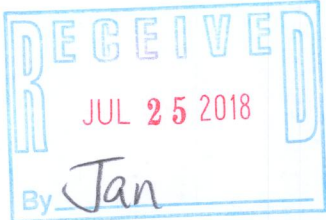

*Mark R. Madsen*

MARK R. MADSEN S - 2271  
Wisconsin Professional Land Surveyor

WLW3-22 011-2843