

PREPARED FOR
KEEFE REAL ESTATE

ORDERED BY
LINDA TONGE

PLAT OF SURVEY

- OF -

Lot 181, Original Plat of Cedar Point Park, located in Section 6,
Township 1 North, Range 17 East, Village of Williams Bay,
Walworth County, Wisconsin.

PATHFINDER SURVEYING



(a NMB Company)

P.O BOX 322

LAKE GENEVA, WI. 53147

WWW.PATHFINDERSURVEYING.NET

262-248-8303

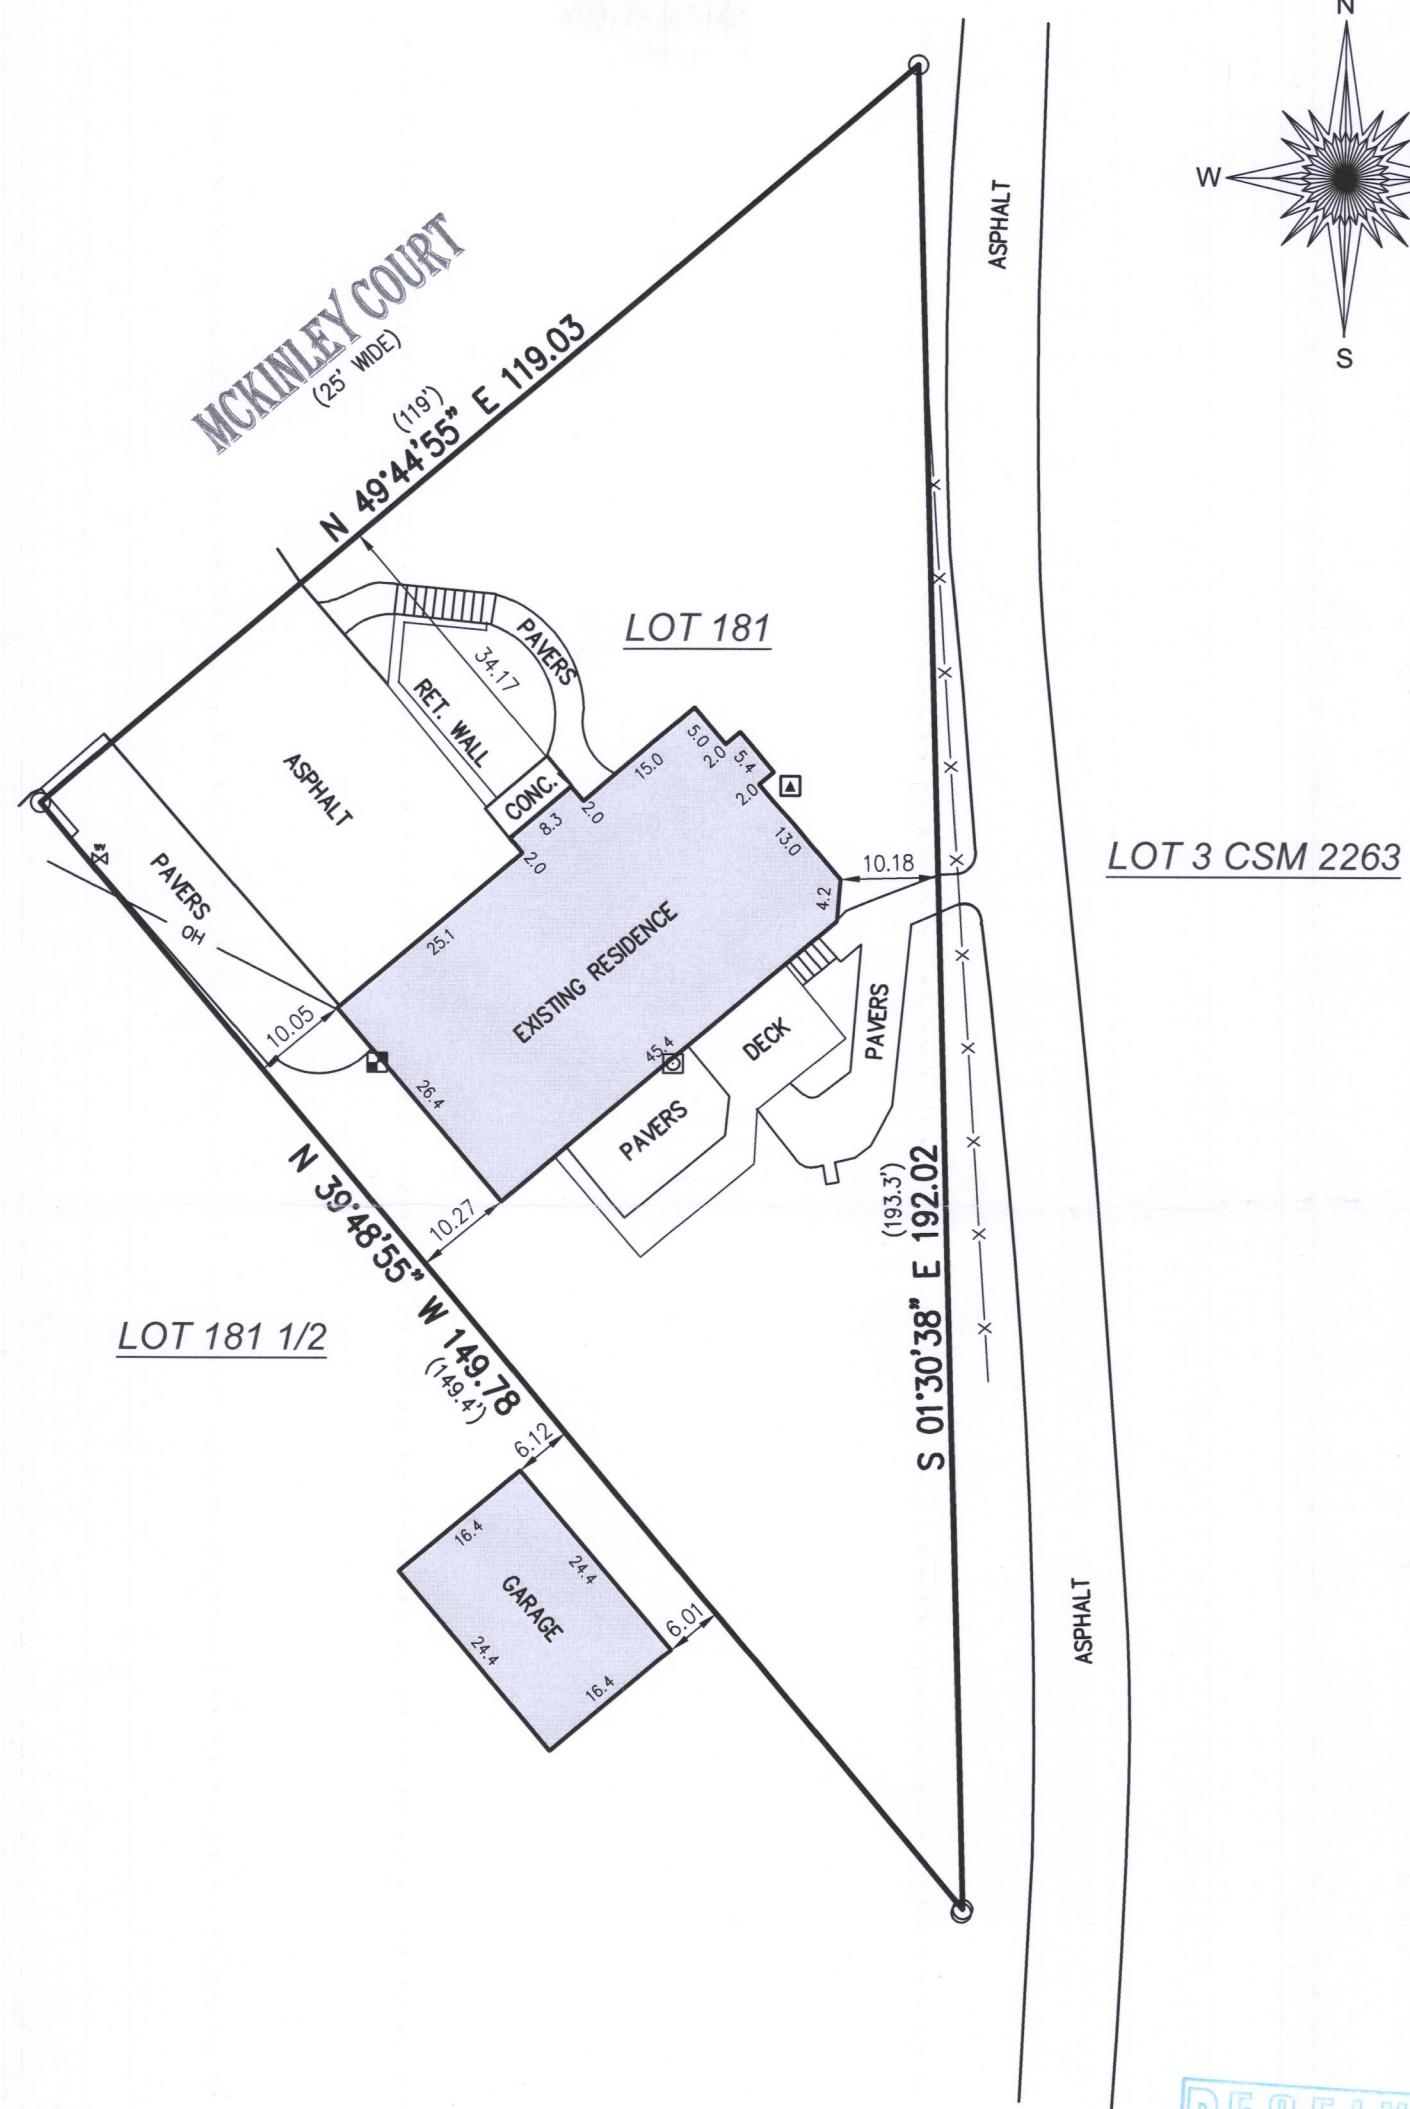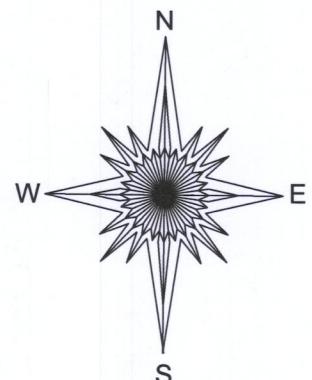

- () = recorded as
- = found iron pipe
- OH — = overhead wires
- X — = fence
- = electric meter
- ▲ = hvac
- = gas meter
- WV = water valve

20 0 20 40 60

BASIS OF BEARING OF THIS PLAT: THE US STATE PLANE
COORDINATE SYSTEM SOUTH ZONE, NAD 83. WISCONS.


SCALE 1" = 20'

JOB # 2018.0183.01

TAX ID # WCP 00154

This survey is made for the present owners of the property, and those who purchase, mortgage, or guarantee the title thereto, within one year from the date hereof.

DATED THIS 20TH DAY OF JUNE, 2018.

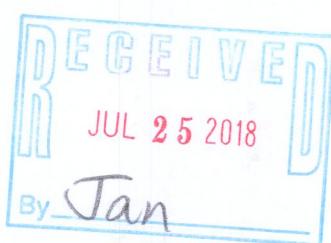

Mark R. Madsen S-2271
Wisconsin Professional Land Surveyor

WCP-154

011-2846