


*PLAT OF SURVEY*  
-OF-

COMMENCING AT AN IRON STAKE THAT IS 330 FEET SOUTH 88°50' WEST OF AND 169 FEET NORTH 01°08' WEST OF THE NORTHEAST CORNER OF BETHEL BLOCK, A SUBDIVISION OF THE VILLAGE OF WILLIAMS BAY, WALWORTH COUNTY, WISCONSIN, THENCE SOUTH 88°50' WEST 100 FEET TO AN IRON STAKE, THENCE NORTH 01°08' WEST 125 FEET TO AN IRON STAKE, THENCE NORTH 88°50' EAST 100 FEET TO AN IRON STAKE, THENCE SOUTH 01°08' EAST 125 FEET TO THE PLACE OF BEGINNING. SAID LAND BEING IN THE VILLAGE OF WILLIAMS BAY, COUNTY OF WALWORTH AND STATE OF WISCONSIN.

SURVEY FOR: SHIRLEY COULMAN OF KEEFE REAL ESTATE  
SURVEY ADDRESS: 114 WITTIG COURT, WILLIAMS BAY, WI 53191

BEARINGS HEREON RELATE TO THE  
NORTH RIGHT-OF-WAY LINE OF  
WITTIG COURT. ASSUMED BEARING OF  
SOUTH 88°50'00" WEST AS DEEDED.

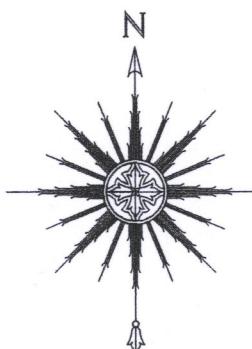

SCALE:  $1'' = 20'$


SCALE: 1" = 20

588°50'00" W

*LEGEND*

- FOUND 1-5/16" O.D. IRON PIPE
- SET MAG SPIKE
- ( ) RECORDED AS
- ~ UTILITY POLE

NOTE: THIS OFFICE BELIEVES THE FOUND IRON PIPE  
ARE LIKELY THE SAME PIPE DEPICTED ON A SURVEY  
BY JOSEPH BIAGI DATED FEBRUARY 8, 1946 AND WERE  
HELD AS THE BEST EVIDENCE OF THE PROPERTY LINES.

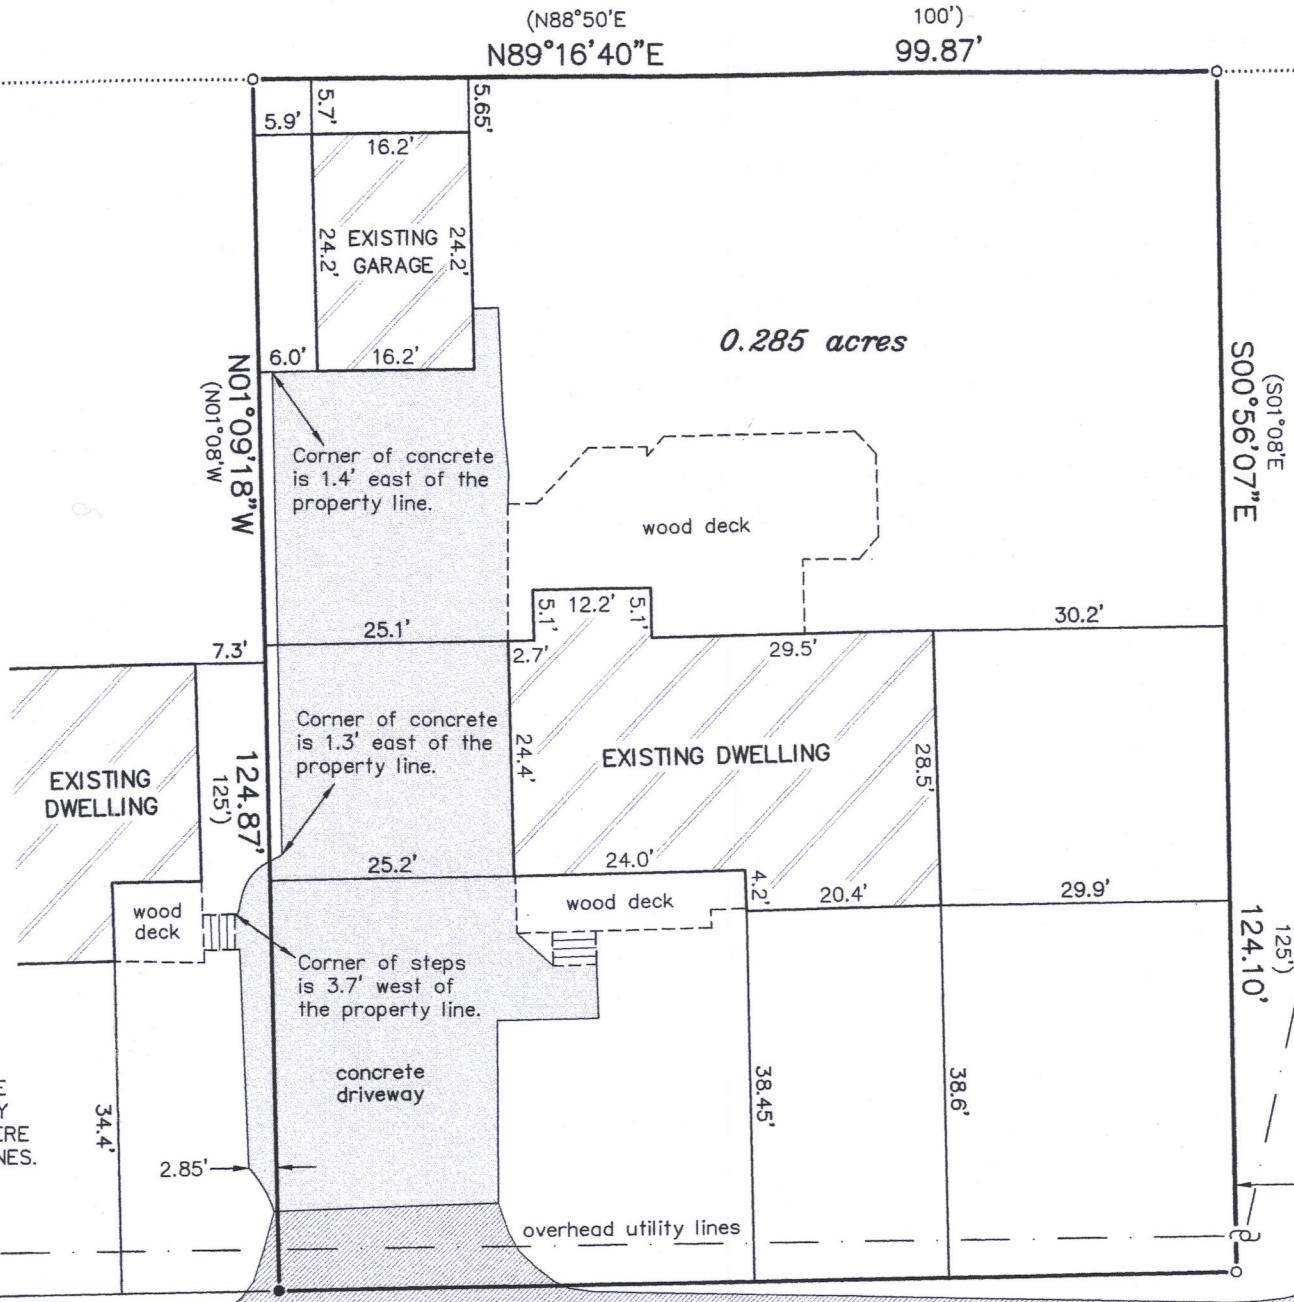

**COURT**

**SATTER SURVEYING, LLC**  
LAND SURVEYS, MAPPING AND PLANNING

272 ORIGEN STREET  
BURLINGTON, WI 53105  
262-661-4239

"I HEREBY CERTIFY THAT I HAVE SURVEYED THE ABOVE DESCRIBED PROPERTY AND THAT THE ABOVE MAP IS A CORRECT REPRESENTATION THEREOF AND SHOWS THE SIZE AND LOCATION OF THE PROPERTY, ITS EXTERIOR BOUNDARIES, THE LOCATION OF ALL VISIBLE STRUCTURES AND DIMENSIONS OF ALL PRINCIPAL BUILDINGS THEREON, BOUNDARY FENCES, APPARENT EASEMENTS, ROADWAYS AND ENCROACHMENTS, IF ANY."

"THIS SURVEY IS MADE FOR THE USE OF THE PRESENT OWNERS OF THE PROPERTY, AND THOSE WHO PURCHASE, MORTGAGE, OR GUARANTEE THE TITLE THERETO WITHIN ONE YEAR FROM DATE HEREOF."

Thomas L. Satter Ja  
THOMAS L. SATTER S-2850

THOMAS L. SATTER


S-2850

JULY 25, 2018

---

DATE

061813

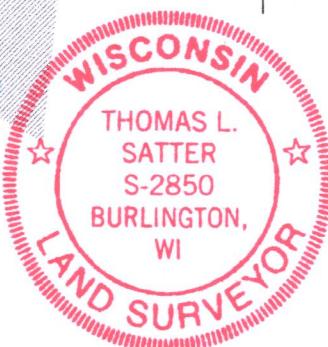

THIS IS NOT AN ORIGINAL PRINT  
UNLESS THIS SEAL IS RED.