


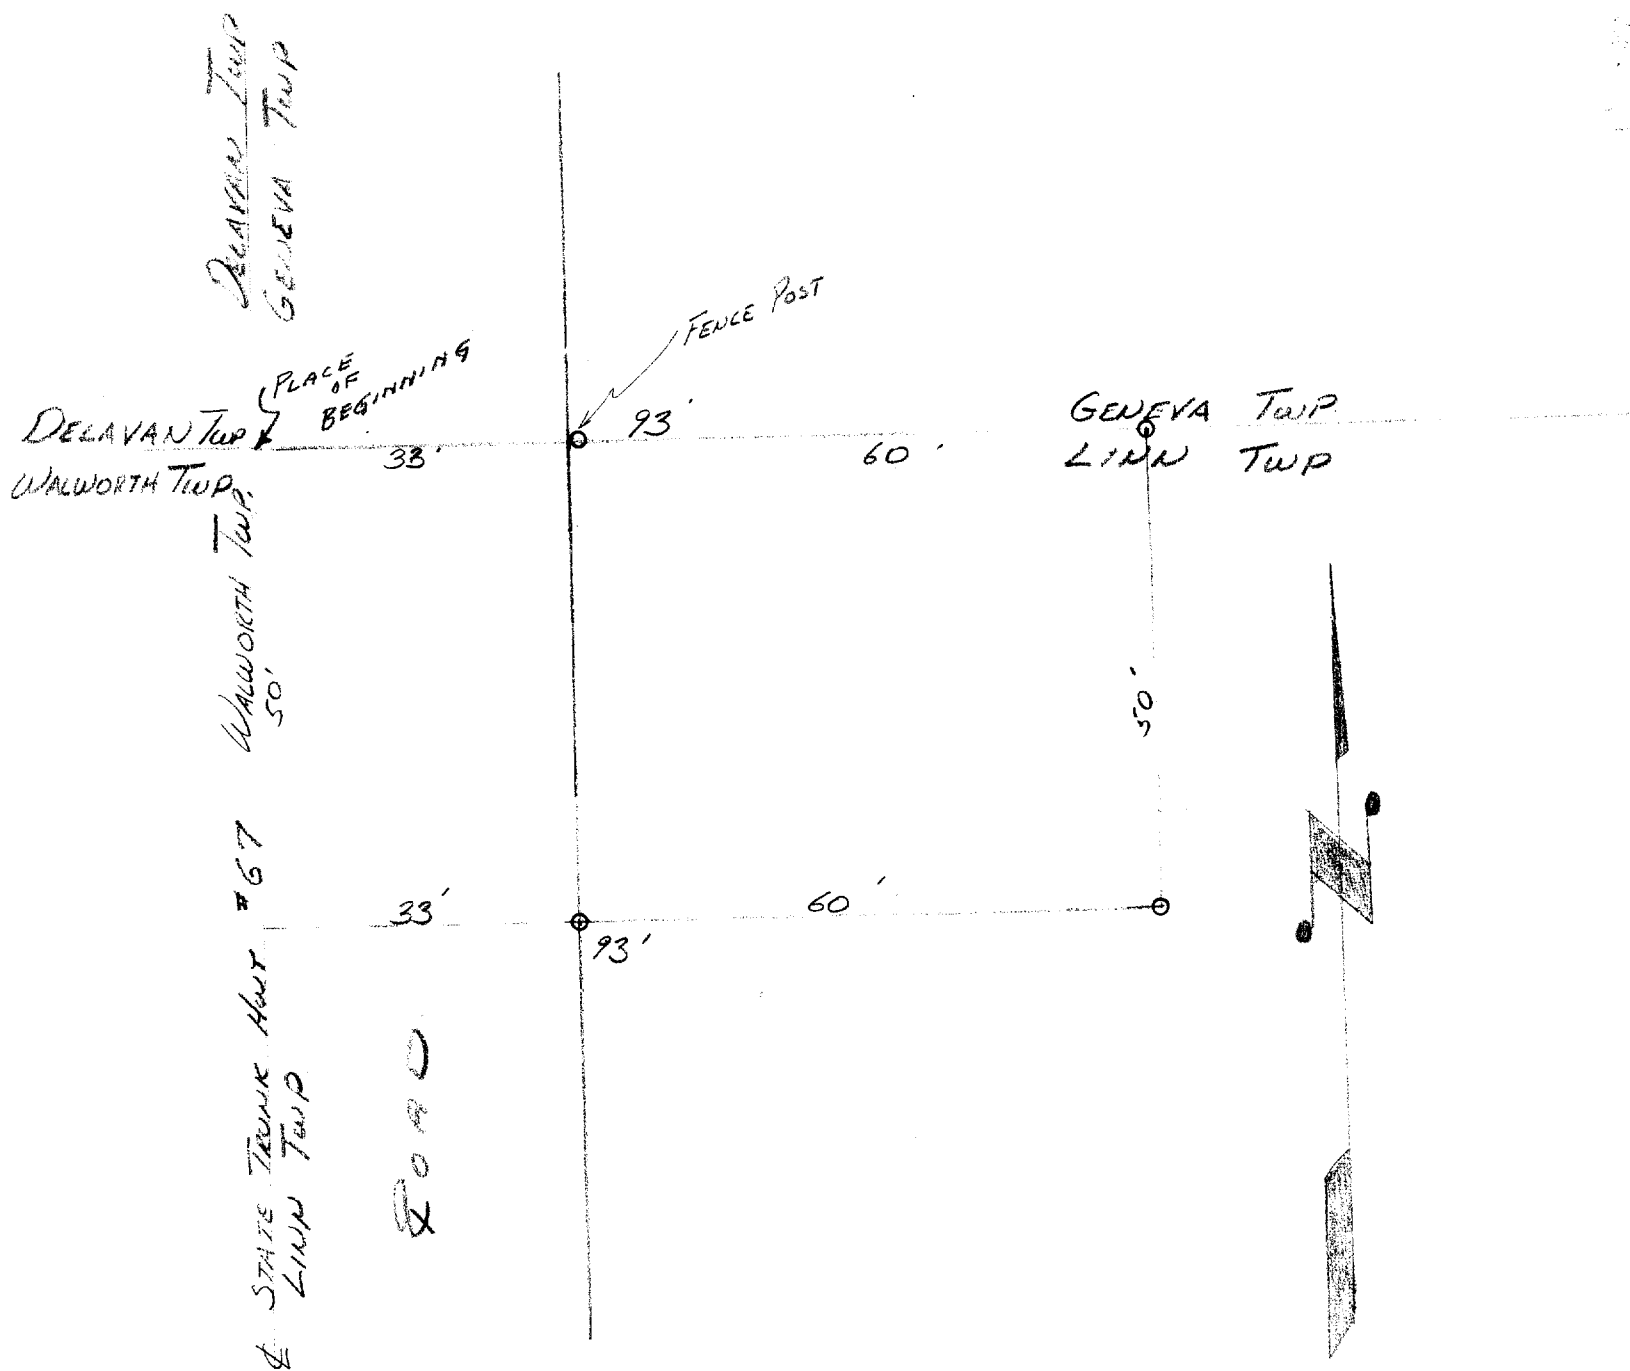

DESCRIPTION: Commencing at the northwest corner of Town 1, north, Range 17 east of the 4th Principal Meridian, (Linn Township), thence East 93.0 feet to an iron stake, thence South 50.0 feet to an iron stake, thence West 93.0 feet to a point in the west line of said township, thence North in the west line of said township 50.0 feet to the place of beginning.

CERTIFICATE: I, hereby certify that I have on this the 8th day of October 1955, surveyed the above described property and state that the above portrayal is an accurate reproduction of said survey.

SIGNED AND SEALED ON THIS THE 12TH DAY OF OCTOBER 1955.

Joseph M. Biagi
Joseph M. Biagi, Professional Engineer.
Elkhorn Wisconsin.

UP 40

96' 9" Bay

11-28B