


PLAT OF SURVEY

OF

LOT 24 OF SUMMER HAVEN LOCATED IN
THE SE $\frac{1}{4}$ OF SECTION 1, T1N R16E, VILLAGE
OF WILLIAMS BAY, WALWORTH COUNTY,
WISCONSIN.

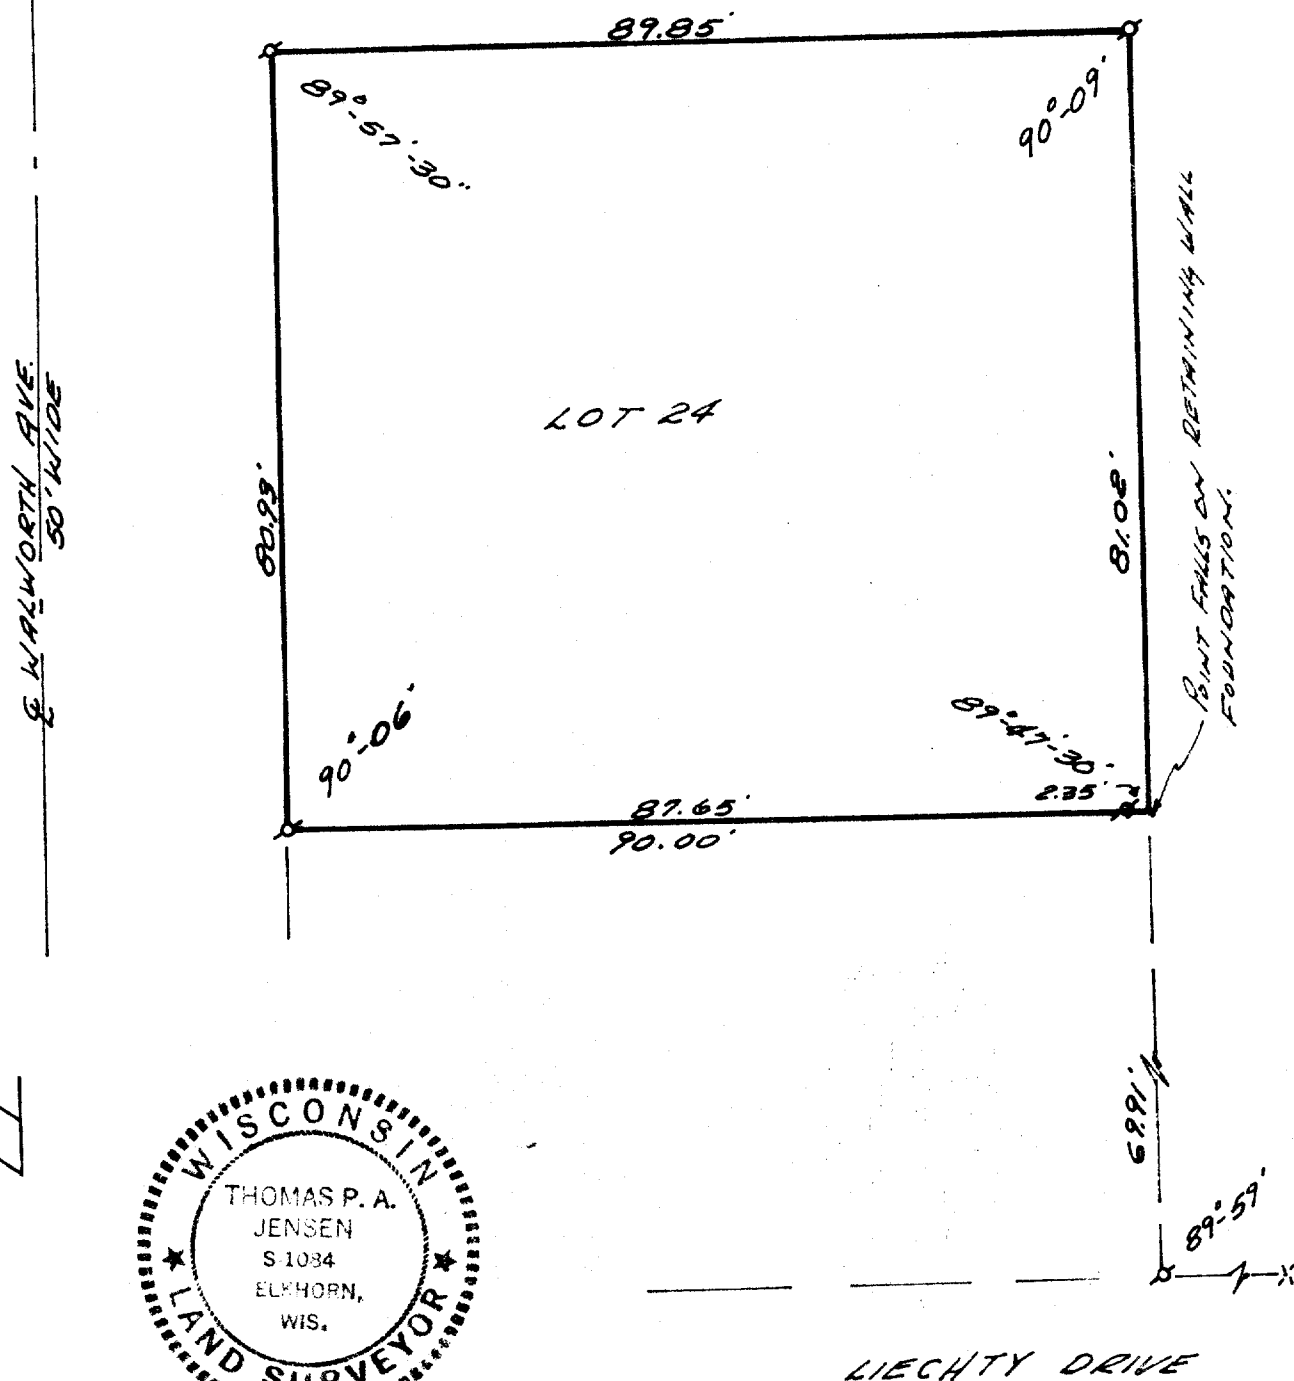

LIECHTY DRIVE

SURVEY AND PLAT BY

JENSEN & JOHNSON, INC.

CIVIL ENGINEERS AND SURVEYORS

Elkhorn, Wisconsin

SURVEYED FOR: GALE JOHNSON

LEGEND

HARRY-WAY CORP.

○ — Iron Pipe FOUND

● — Concrete Monument

Scale 1" = 20'

● — IRON ROD SET

✕ — PK NAIL FOUND

WE CERTIFY: That we have surveyed the above described property and that the plat shown hereon is an accurate survey and a true representation thereof and correctly shows the exterior boundary lines and all divisions of said property.

Date SEPT. 23, 1975

Thomas P. A. Jensen

Wisconsin Registered Land Surveyor, No. S-1034

WSU-24