
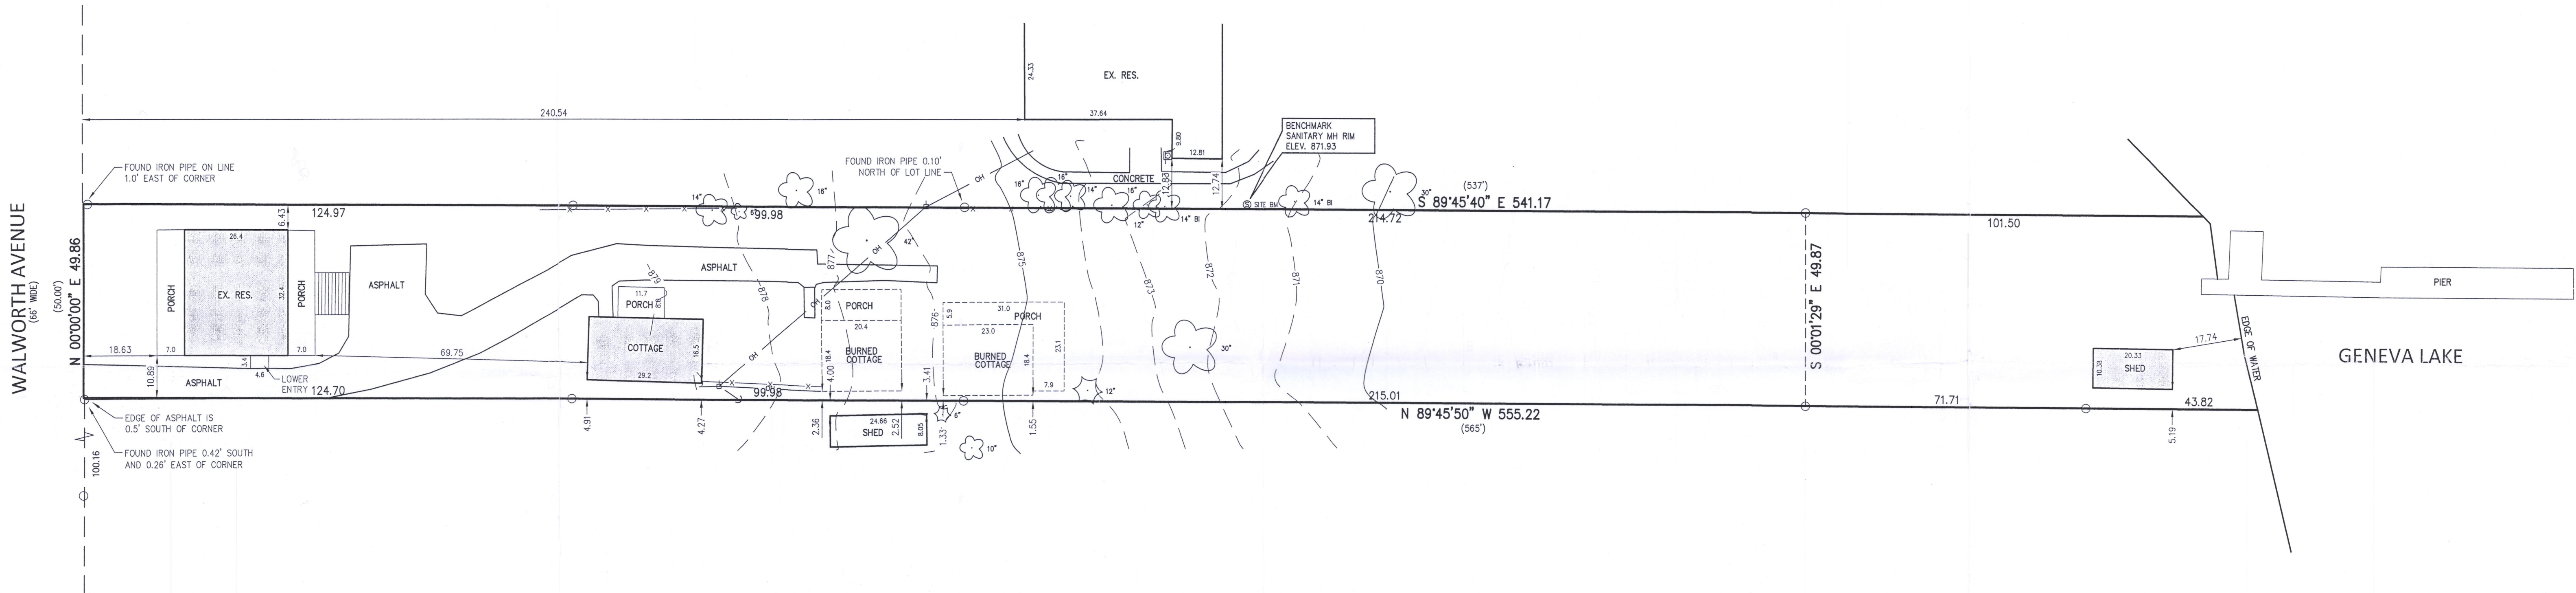


PREPARED FOR
DANIEL & JOCELYN
McGOVERN

PLAT OF SURVEY


Lot 11, Block 7 of the Original Plat of the Village of Williams Bay, Being part of the Northeast ¼ of Section 6, Township 1 North, Range 16 East and part of the Northwest ¼ of Section 1, Township 1 North, Range 17 East, in the Village of Williams Bay, Walworth County, Wisconsin.

PATHFINDER SURVEYING
(a NMB Company)
1458 HORIZON BLVD. STE. 200
RACINE, WI. 53406
WWW.PATHFINDERSURVEYING.NET
262-248-8303

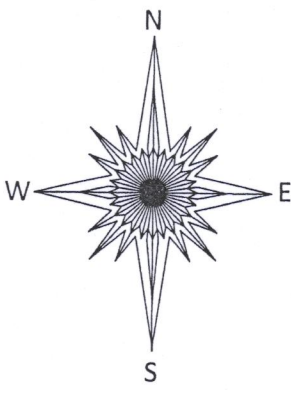

- () RECORDED AS
- POWER POLE
- FOUND IRON PIPE
- OH — OVERHEAD WIRES
- ☼ DECIDUOUS TREE
- ☼ CONIFEROUS TREE
- ↑ GUY WIRE
- X — FENCE
- ⊠ GAS METER

SCALE 1" = 20'
JOB # 2019.0210.01
TAX ID # WOP0094

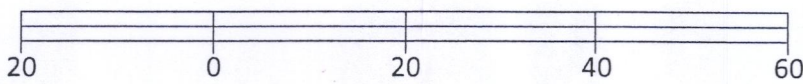


Basis of Bearing of this plat: The US State Plane
Coordinate System South Zone, NAD 83. WISCONS.

I hereby certify that I have surveyed the above- described
property and the above map is a true representation
thereof and shows the size and location of the property, its
exterior boundaries, the location and dimensions of all
structures thereon, fences, apparent easements and roadways
and visible encroachments if any to the best of my knowledge
and belief.

This survey is made for the present owners of the property, and
those who purchase, mortgage, or guarantee the title thereto,
within one year from the date hereof.

Dated this 7th day of October, 2019.

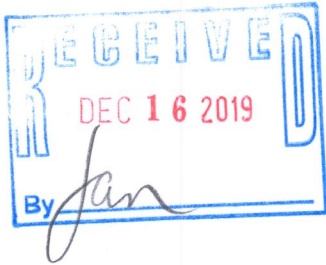

MARK R. MADSEN S - 2271
Wisconsin Professional Land Surveyor

WOP-94 011-2924