
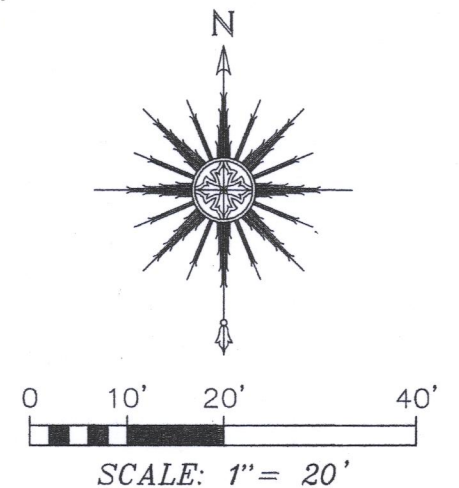
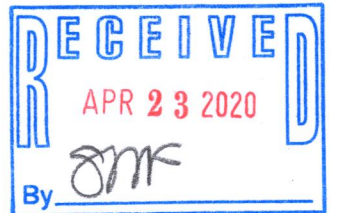


PLAT OF SURVEY
-OF-

LOTS 29 AND 30 IN LOCH VISTA CLUB SUBDIVISION NO. 1, ACCORDING TO THE RECORDED PLAT THEREOF. SAID LAND BEING IN THE VILLAGE OF WILLIAMS BAY, COUNTY OF WALWORTH AND STATE OF WISCONSIN.


SURVEY FOR: JORNDT FAHEY BUILDERS, LLC

SURVEY ADDRESS: 181 CONFERENCE POINT ROAD, WILLIAMS BAY, WI 53191

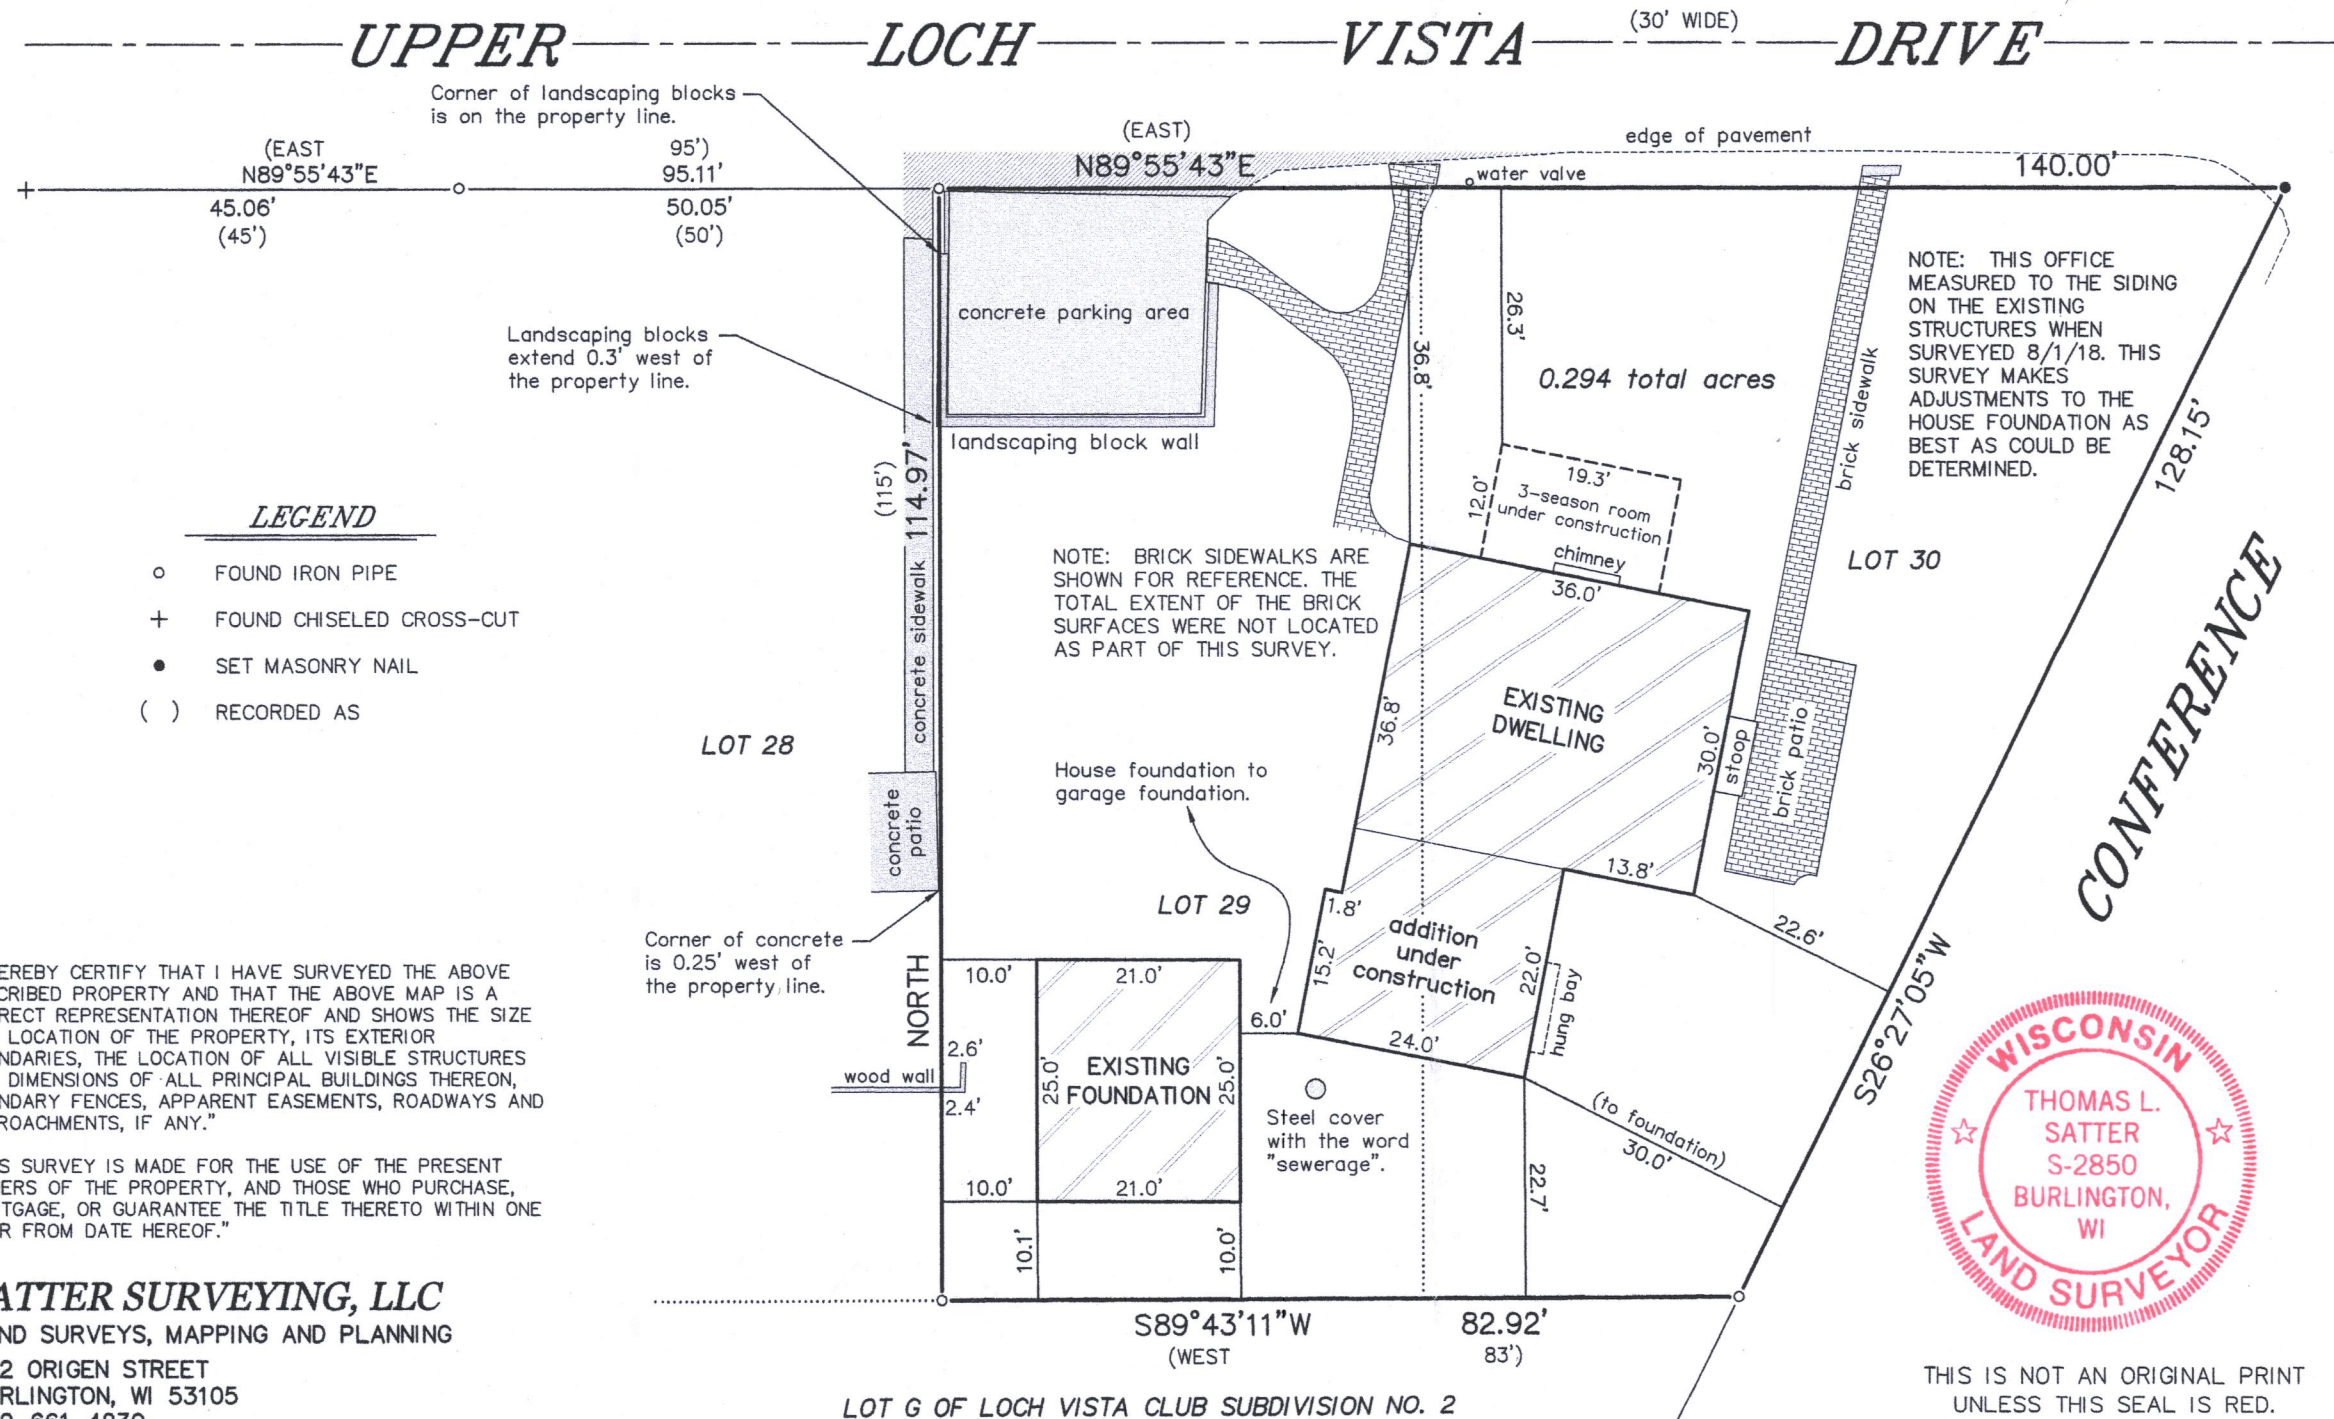

BEARINGS HEREON RELATE TO THE WEST LINE OF LOT 29 OF LOCH VISTA CLUB SUBDIVISION NO. 1. ASSUMED BEARING OF NORTH AS PLATTED (PER RECORDED PLAT LEGAL DESCRIPTION).

NOTE: THIS MAP WAS REVISED THE 12TH DAY OF FEBRUARY, 2020 TO DEPICT THE EXISTING HOUSE ADDITIONS. THIS MAP IS BEING REVISED THIS 15TH DAY OF APRIL, 2020 TO DEPICT THE EXISTING GARAGE FOUNDATION. ALL OTHER PROPERTY DETAILS ARE FROM PREVIOUS SURVEY WORK DATED 8/1/18 AND WERE NOT RE-VERIFIED AS PART OF THIS SURVEY.

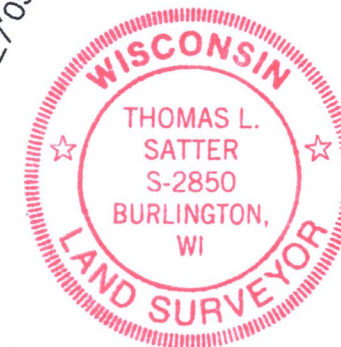

SATTER SURVEYING, LLC
LAND SURVEYS, MAPPING AND PLANNING
272 ORIGEN STREET
BURLINGTON, WI 53105
262-661-4239

Thomas L. Satter

THOMAS L. SATTER S-2850

REVISED: 4/15/20
REVISED: 2/12/20
REVISED: 10/11/19
AUGUST 1, 2018
DATE

071803
JOB NUMBER

THIS IS NOT AN ORIGINAL PRINT
UNLESS THIS SEAL IS RED.

WLV-23

011-2941