
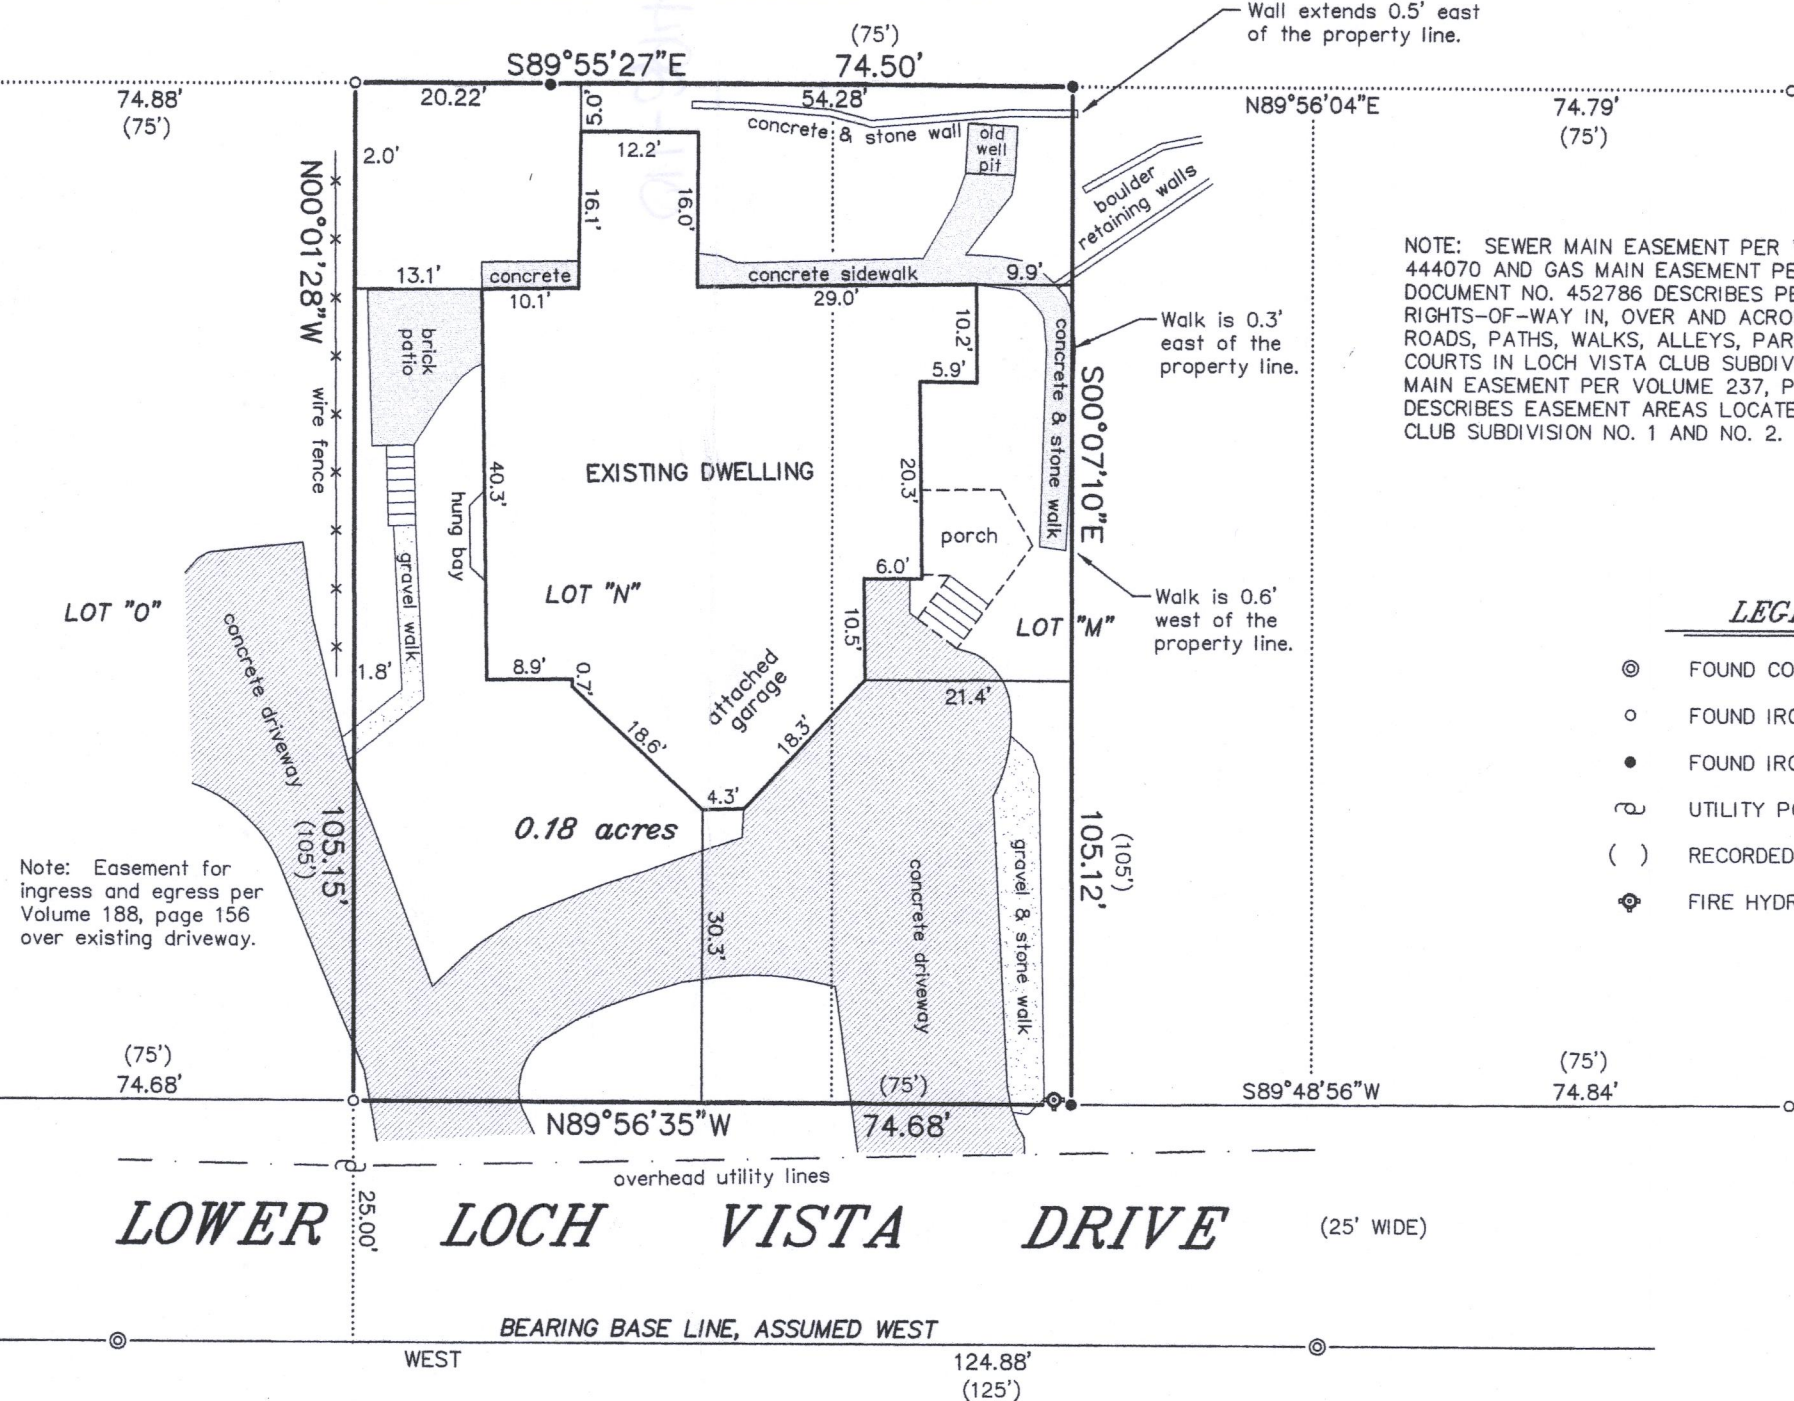


LOCH VISTA CLUB SUBDIVISION NO. 1

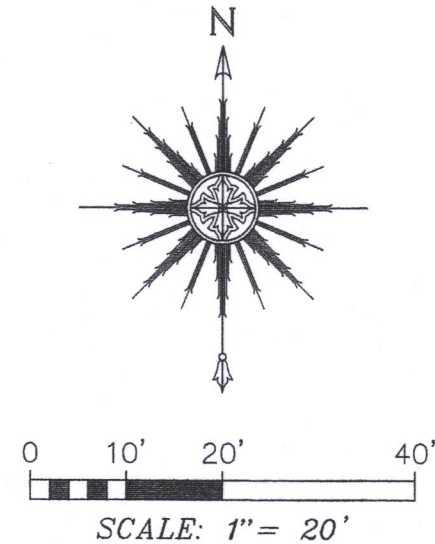

NOTE: SEWER MAIN EASEMENT PER VOLUME 443, PAGE 241, DOC. NO. 444070 AND GAS MAIN EASEMENT PER VOLUME 456, PAGE 232, DOCUMENT NO. 452786 DESCRIBES PERPETUAL EASEMENTS AND RIGHTS-OF-WAY IN, OVER AND ACROSS THE PRIVATE SUBDIVISION ROADS, PATHS, WALKS, ALLEYS, PARKS, PLAYGROUNDS AND TENNIS COURTS IN LOCH VISTA CLUB SUBDIVISION NO. 1 AND NO. 2. WATER MAIN EASEMENT PER VOLUME 237, PAGE 494, DOC. NO. 311352 DESCRIBES EASEMENT AREAS LOCATED IN THE ROADS OF LOCH VISTA CLUB SUBDIVISION NO. 1 AND NO. 2.

LEGEND

- ⊙ FOUND CONCRETE MONUMENT
- FOUND IRON PIPE
- FOUND IRON ROD
- ⚡ UTILITY POLE
- () RECORDED AS
- ⚡ FIRE HYDRANT



"I HEREBY CERTIFY THAT I HAVE SURVEYED THE ABOVE DESCRIBED PROPERTY AND THAT THE ABOVE MAP IS A CORRECT REPRESENTATION THEREOF AND SHOWS THE SIZE AND LOCATION OF THE PROPERTY, ITS EXTERIOR BOUNDARIES, THE LOCATION OF ALL VISIBLE STRUCTURES AND DIMENSIONS OF ALL PRINCIPAL BUILDINGS THEREON, BOUNDARY FENCES, APPARENT EASEMENTS, ROADWAYS AND ENCROACHMENTS, IF ANY."

"THIS SURVEY IS MADE FOR THE USE OF THE PRESENT OWNERS OF THE PROPERTY, AND THOSE WHO PURCHASE, MORTGAGE, OR GUARANTEE THE TITLE THERETO WITHIN ONE YEAR FROM DATE HEREOF."

SATTER SURVEYING, LLC
LAND SURVEYS, MAPPING AND PLANNING
272 ORIGIN STREET
BURLINGTON, WI 53105
262-661-4239

LOT "N" AND THE WEST 1/2 OF LOT "M" IN LOCH VISTA CLUB SUBDIVISION NO. 2 IN THE VILLAGE OF WILLIAMS BAY, ACCORDING TO THE PLAT THEREOF ON RECORD IN THE OFFICE OF THE REGISTER OF DEEDS IN AND FOR WALWORTH COUNTY, WISCONSIN.

SURVEY FOR: ADAM LAW OF RE/MAX PLAZA
SURVEY ADDRESS: 94 LOWER LOCH VISTA DRIVE, WILLIAMS BAY, WI 53191

THIS IS NOT AN ORIGINAL PRINT
UNLESS THIS SEAL IS RED.

Thomas L. Satter
THOMAS L. SATTER S-2850

MARCH 24, 2020
DATE

032001
JOB NUMBER

WLVA-12

011-2944