


GEORGE T. DUNHAM
SURVEYOR & ENGINEER
DELAVAL, WISCONSIN

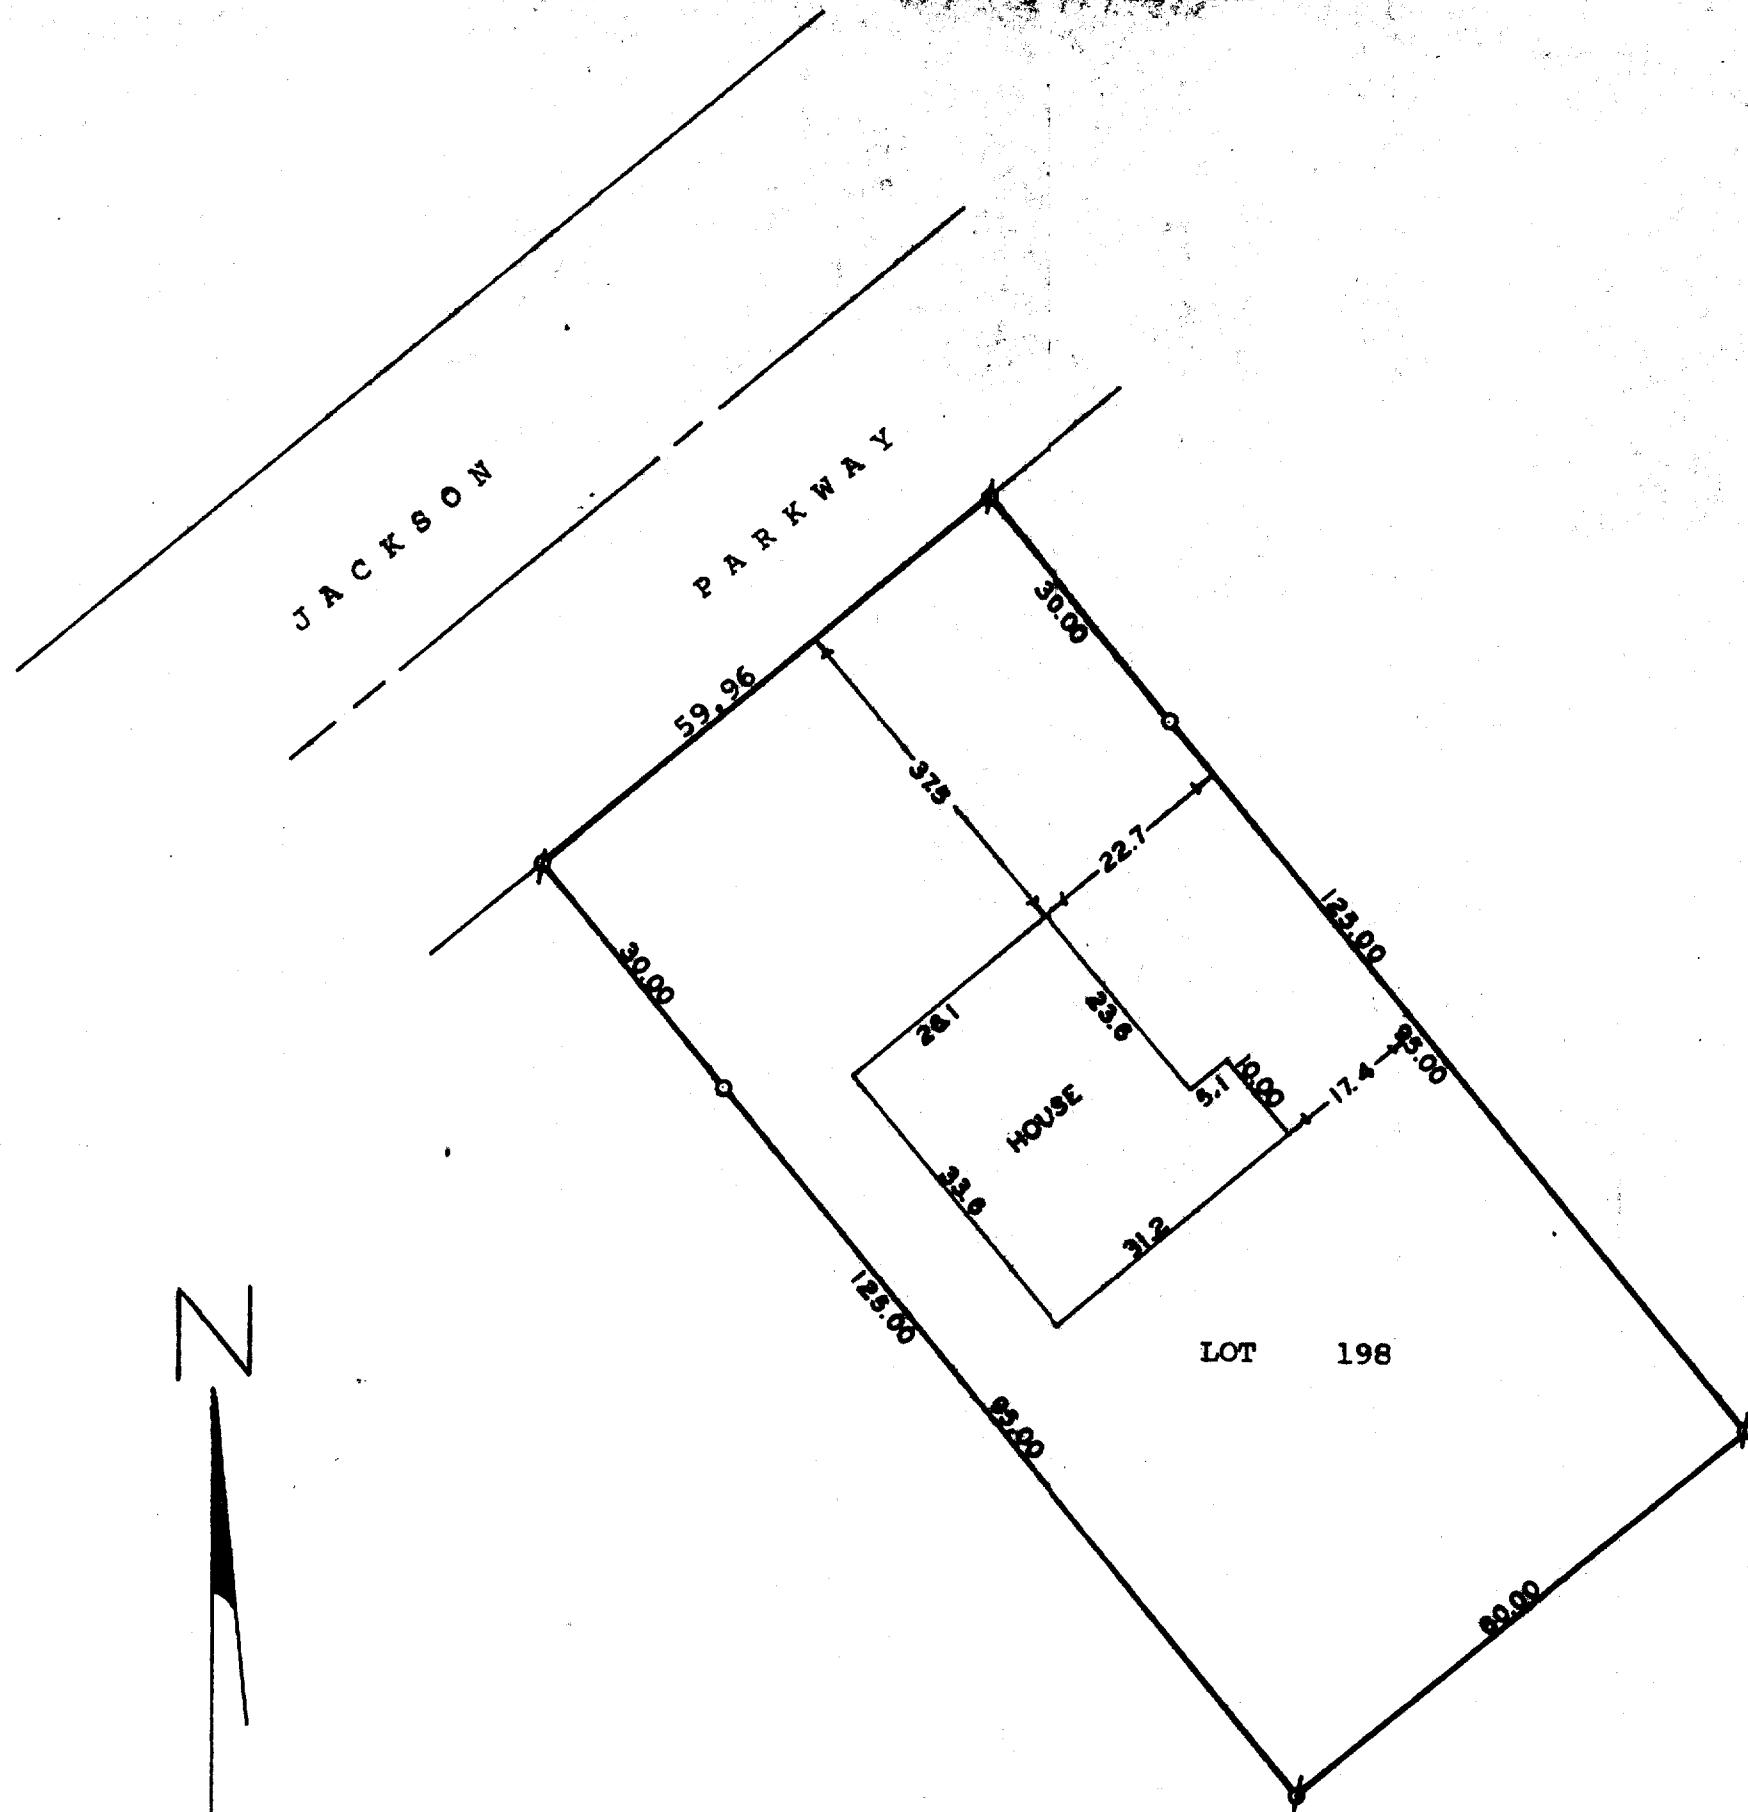

Scale - 1" = 20'
 \otimes = Iron Pipe Found
 \circ = Iron Pipe Set

STATE OF WISCONSIN)
COUNTY OF WALWORTH) SS

I, George T. Dunham, Surveyor, certify that I have surveyed
the property described as follows.

Lot 198 of Cedar Point Park located in the Village of Williams
Bay, Walworth County, Wisconsin,
and the above map is a true representation thereof and shows the size and
location of the property, its exterior boundaries, the location and dimen-
sions of all structures thereon, fences, apparent easements and roadways
and visible encroachments, if any.

This survey is made for the exclusive use of the present owners of the property,
and also those who purchase, mortgage, or guarantee the title thereto within
one (1) year from date hereof, and as to them I warrant the accuracy of said
survey and map.

September 15, 1975

George T. Dunham
George T. Dunham, Surveyor

