
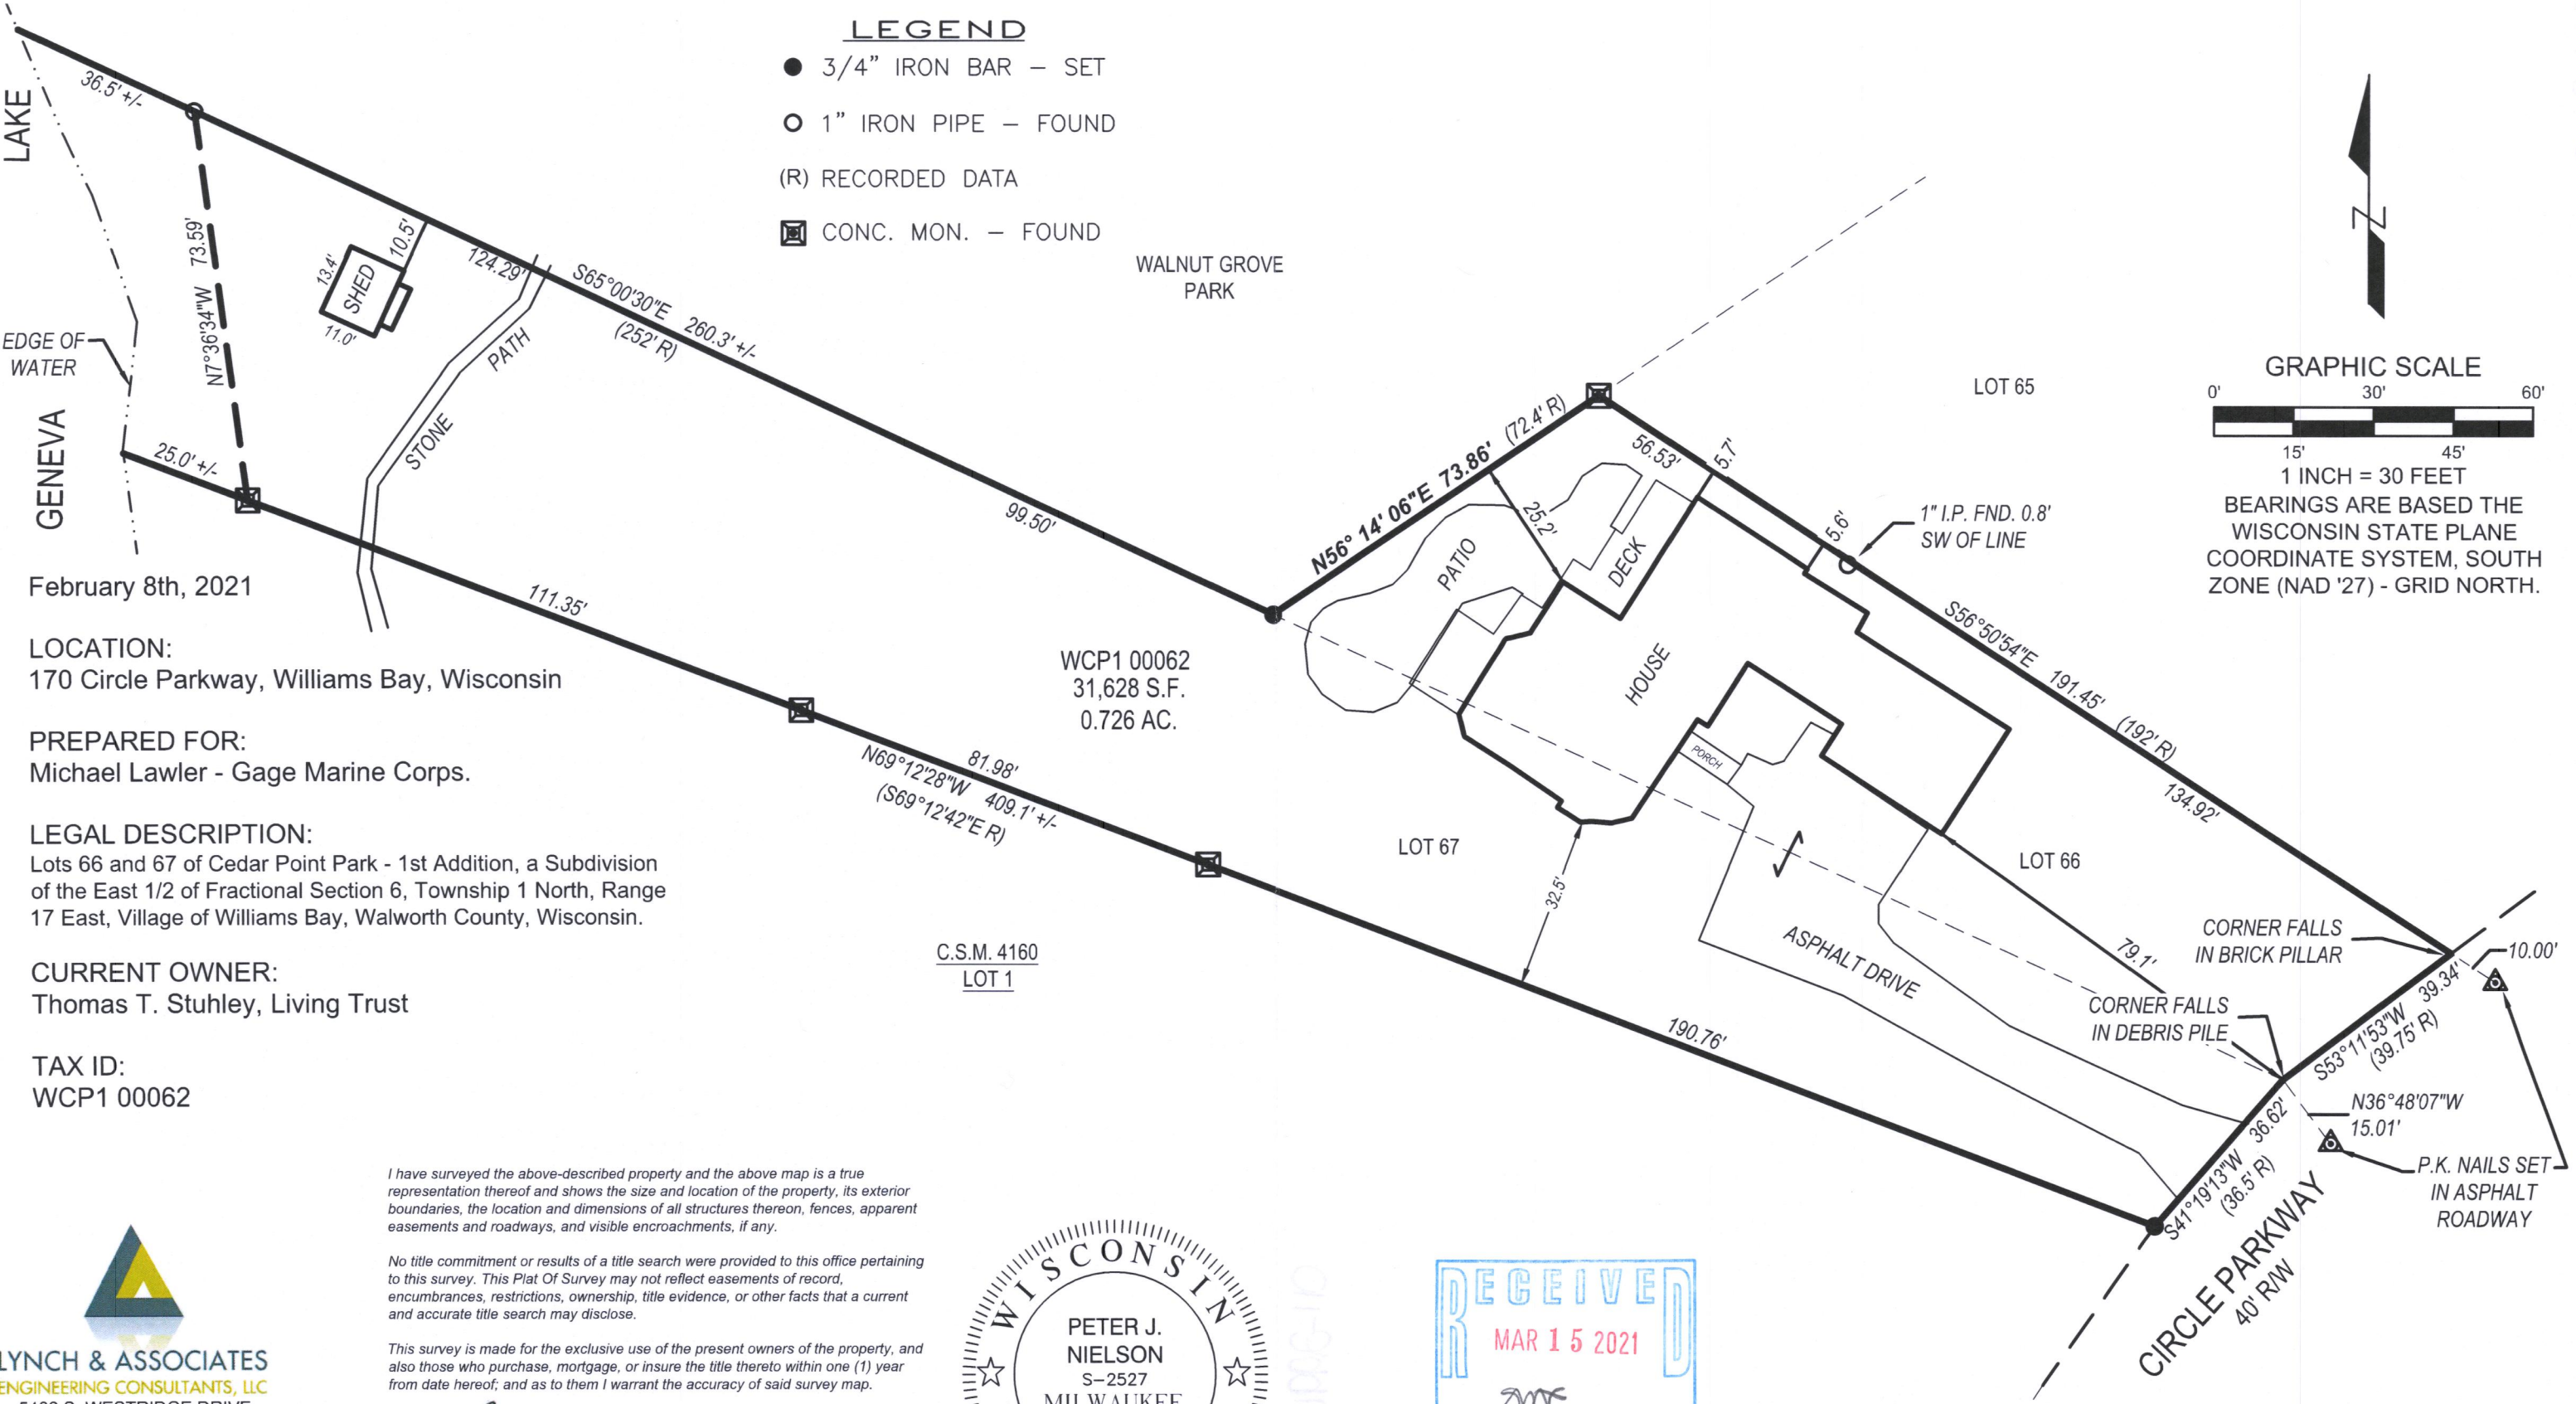


PLAT OF SURVEY

Survey No. 20-5155

LEGEND

- 3/4" IRON BAR - SET
- 1" IRON PIPE - FOUND
- (R) RECORDED DATA
- ▣ CONC. MON. - FOUND

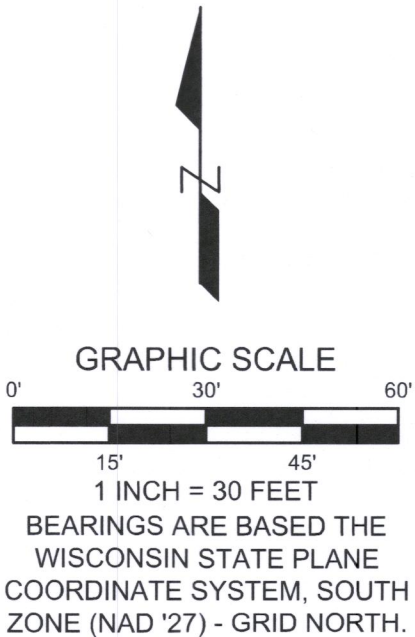

February 8th, 2021

LOCATION:
170 Circle Parkway, Williams Bay, Wisconsin

PREPARED FOR:
Michael Lawler - Gage Marine Corps.

LEGAL DESCRIPTION:
Lots 66 and 67 of Cedar Point Park - 1st Addition, a Subdivision of the East 1/2 of Fractional Section 6, Township 1 North, Range 17 East, Village of Williams Bay, Walworth County, Wisconsin.

CURRENT OWNER:
Thomas T. Stuhley, Living Trust

TAX ID:
WCP1 00062


I have surveyed the above-described property and the above map is a true representation thereof and shows the size and location of the property, its exterior boundaries, the location and dimensions of all structures thereon, fences, apparent easements and roadways, and visible encroachments, if any.

No title commitment or results of a title search were provided to this office pertaining to this survey. This Plat Of Survey may not reflect easements of record, encumbrances, restrictions, ownership, title evidence, or other facts that a current and accurate title search may disclose.

This survey is made for the exclusive use of the present owners of the property, and also those who purchase, mortgage, or insure the title thereto within one (1) year from date hereof; and as to them I warrant the accuracy of said survey map.

Peter J. Nielson

PETER J. NIELSON, PROFESSIONAL LAND SURVEYOR, S-2527

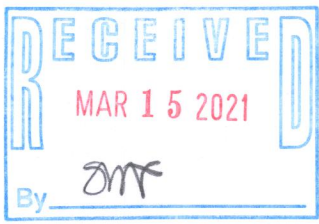


LYNCH & ASSOCIATES
ENGINEERING CONSULTANTS, LLC
5482 S. WESTRIDGE DRIVE
NEW BERLIN, WI 53151

440 MILWAUKEE AVENUE
BURLINGTON, WI 53185

(262) 402-5040

WCP1-602 011-2996