


DUNHAM & RASMUSSEN
SURVEYING & ENGINEERING
DELAVAN, WISCONSIN

NORTHWEST CORNER OF LOT 123

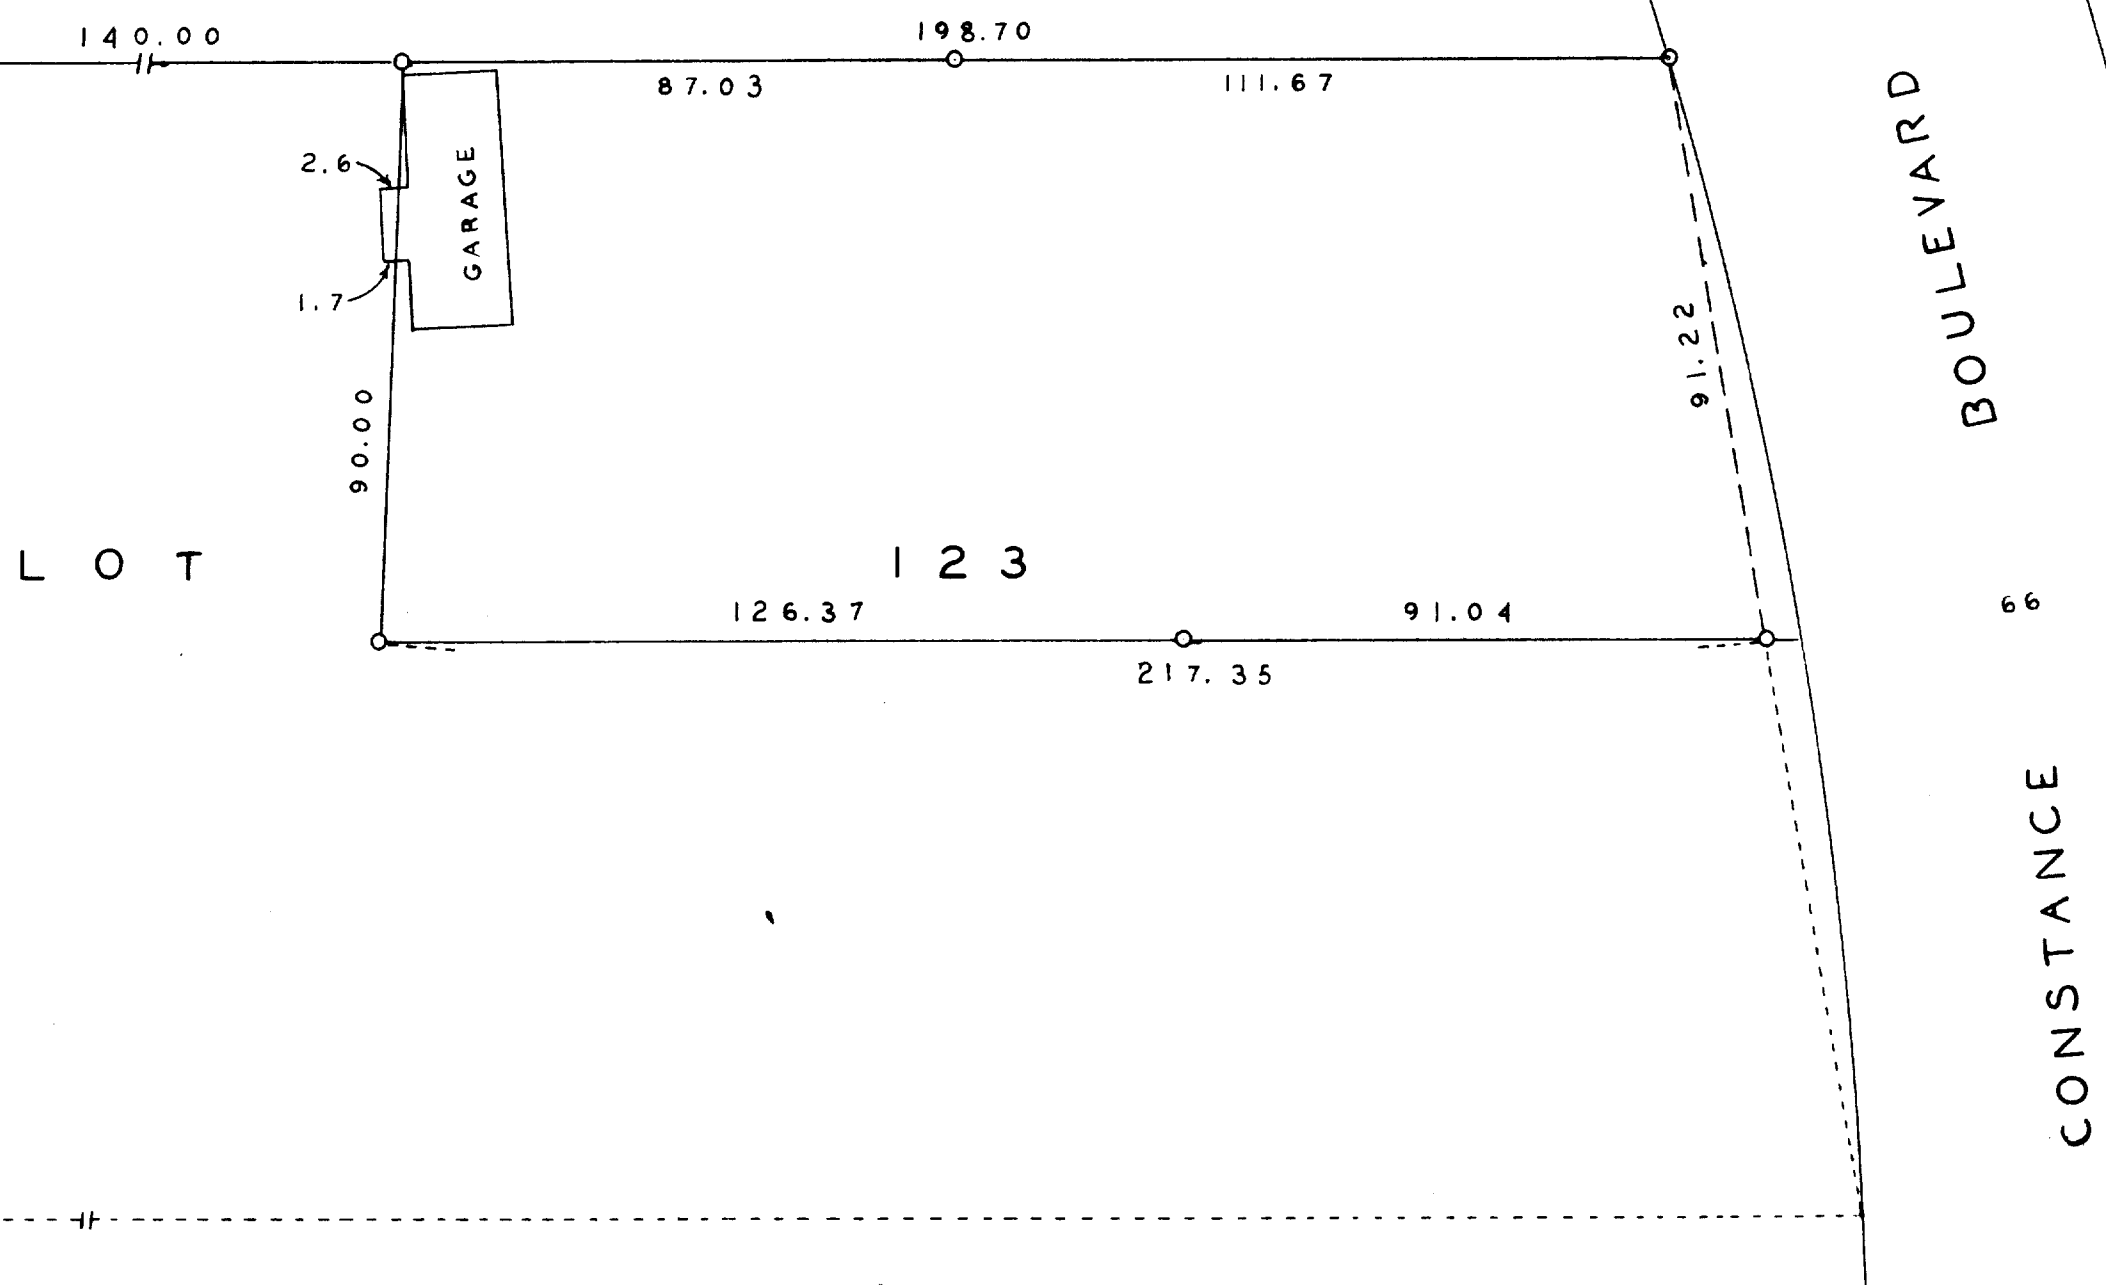

N

SCALE 1" = 30'
O = IRON PIPE

Plat of survey of the north 1/2 of lot 123 Grand Terrace
except the west 140 feet thereof, Village of Williams Bay,
Walworth County, Wisconsin.

June 9, 1960

George T. Dunham
George T. Dunham, Surveyor