

HAROLD H. KOLB

REGISTERED PROFESSIONAL LAND SURVEYOR
LAKE GENEVA, WISCONSIN

UP-56

UP-57

UP-58

PLAT OF

HOUSE LOCATION ON A PARCEL OF LAND
LOCATED IN THE EAST 1/2 OF THE
SOUTHEAST 1/4 OF SECTION 1, T 1 N,
R 16 E, AND PART OF LOT 11, SUMMER
HAVEN SUBDIVISION, VILLAGE OF WILLIAMS
BAY, WALWORTH COUNTY, WISCONSIN.

NOTE: PLAT IS DRAWN FROM EXISTING
RECORDS.

OWNER: CARL NOVAK


LOT 11 SUMMER HAVEN SUBDIVISION



SCALE: 1"= 20'

LEGEND

- φ — IRON PIPE FOUND
- — IRON PIPE PLACED
- — CONCRETE MONUMENT
- x — SPIKE

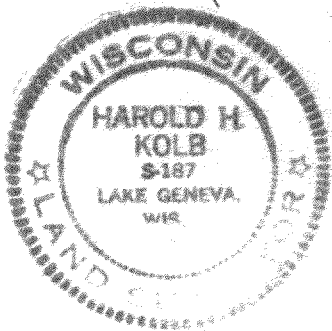

Harold H. Kolb

HAROLD H. KOLB
WISCONSIN REGISTERED LAND SURVEYOR, S-187
DATE Oct. 21, 1975

11-301