


# PLAT OF SURVEY

A PARCEL OF LAND LOCATED IN THE NORTHEAST 1/4 OF THE SOUTHEAST 1/4 OF SECTION 1 IN TOWNSHIP 1 NORTH, RANGE 16 EAST, IN THE VILLAGE OF WILLIAMS BAY, WALWORTH COUNTY, WISCONSIN.


MORE PARTICULARLY DESCRIBED AS:  
 LOT 5 AND 6 OF THE SUMMER HAVEN ON LAKE GENEVA SUBDIVISION  
 PER DOCUMENT NO. P263298 RECORDED IN WALWORTH COUNTY REGISTER OF DEEDS.

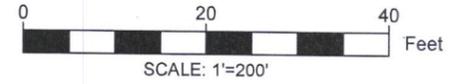

**LEGEND**

- FOUND 1" IRON PIPE
- SET 1" IRON PIPE
- EXISTING BUILDING
- EXISTING DECK
- EXISTING CONCRETE
- EXISTING BRICK PAVERS
- xc — EXISTING WIRE FENCE

CONFERENCE POINT DRIVE (SNAKE DRIVE) 30' R/W

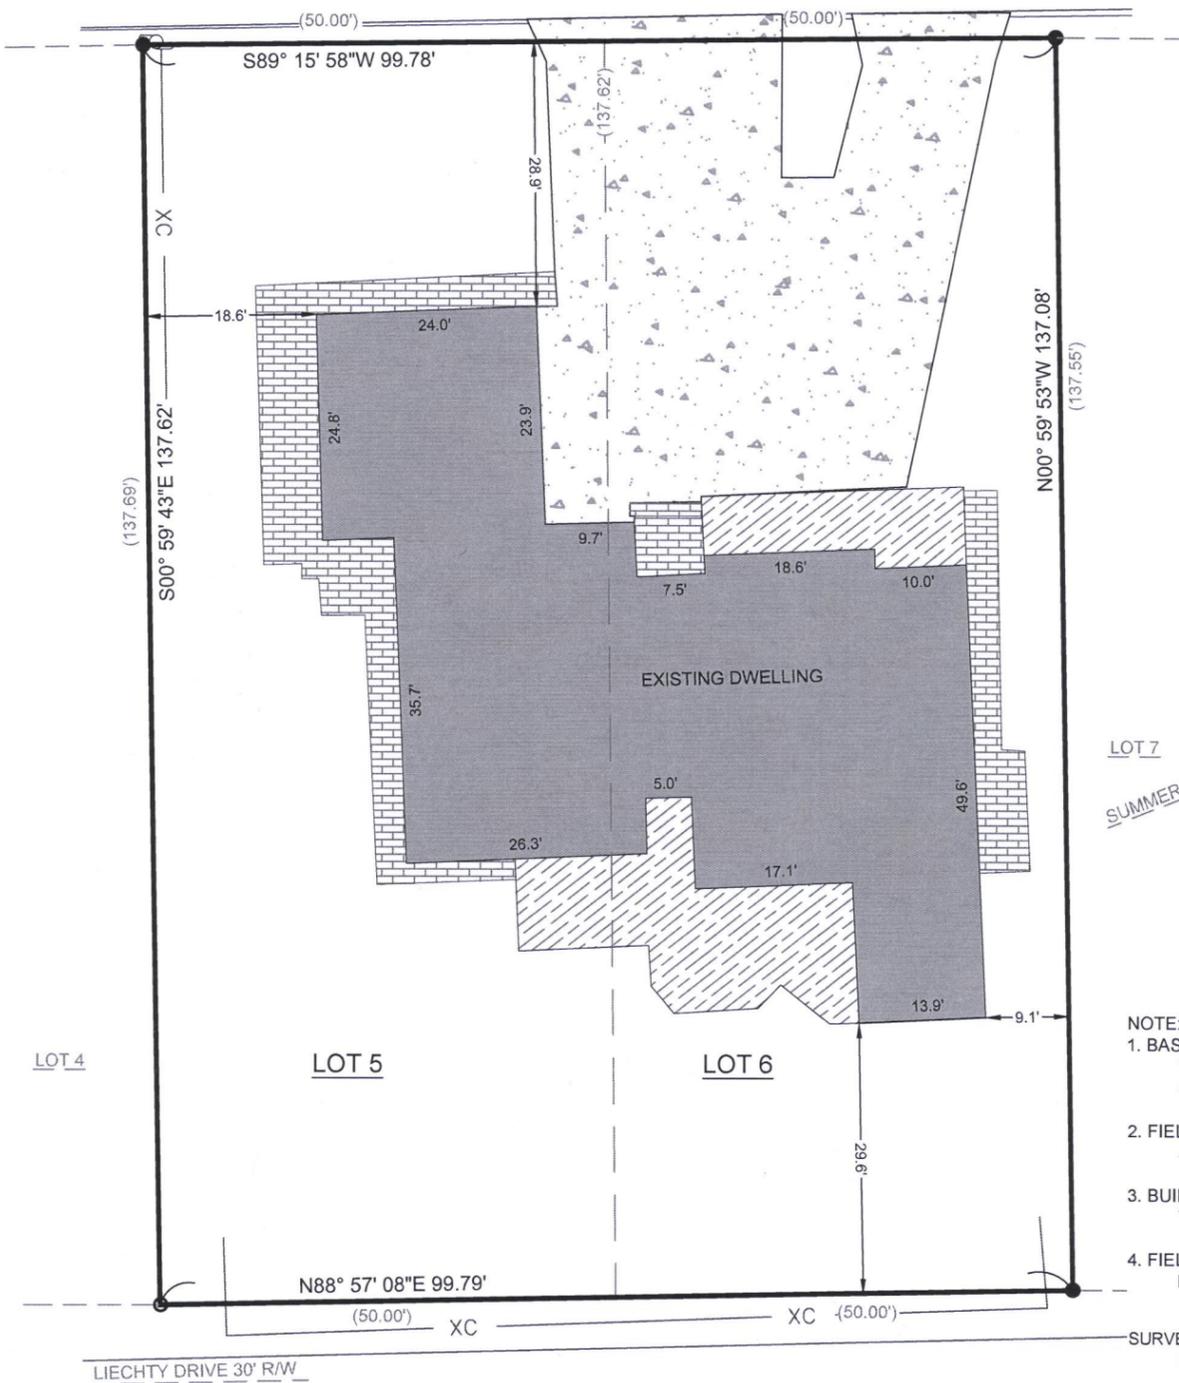

LOT 7  
 SUMMER HAVEN ON GENEVA LAKE

- NOTE:**
1. BASIS OF BEARING:  
THE WISCONSIN STATE PLANE COORDINATE SYSTEM, NAD-83, SOUTH ZONE.
  2. FIELD WORK COMPLETED:  
JULY 12, 2021
  3. BUILDING SURVEYED TO:  
THE EXTERIOR OF SIDING.
  4. FIELD CREW CHIEF:  
RAYMOND MCARDLE

SURVEY ORDERED BY:  
DOMINIC PAOLELLA

PROPERTY ADDRESS:  
99 CONFERENCE POINT ROAD  
WILLIAMS BAY WI, 53191

SURVEYOR:  
PAUL H. VAN HENKELUM, PLS  
CARDINAL ENGINEERING LLC



"I HEREBY CERTIFY THAT I HAVE SURVEYED THE ABOVE DESCRIBED PROPERTY AND THE MAP IS A TRUE AND CORRECT REPRESENTATION OF ITS EXTERIOR BOUNDARIES AND SHOWS THE SIZE AND LOCATION OF ALL VISIBLE STRUCTURES, APPARENT EASEMENTS AND ENCROACHMENTS, IF ANY."

*Paul H. Van Henkelum*  
 PAUL H VAN HENKELUM, PLS #1931      DATE *7/20/2021*



CARDINAL ENGINEERING LLC  
 DESIGNING IN TRUE DIRECTIONS

PO BOX 281 - 1200 LA SALLE ST.  
 LAKE GENEVA, WI 53147  
 262-757-8776  
 CARDINALENGINEERINGWI.COM

DATE: 07/16/2021    JOB No. 21449  
 SHEET 1 OF 1    LWG

WSU-5

011-3023