

# FARRIS, HANSEN & ASSOCIATES, INC.

ENGINEERING — ARCHITECTURE — SURVEYING  
7 RIDGWAY COURT — P.O. BOX 437 — ELKHORN, WISCONSIN 53121  
PHONE: (262) 723-2098 FAX: (262) 723-5886


## PLAT OF SURVEY — AS BUILT

LOT 29 OF BAILEY ESTATES  
LOCATED IN PART OF THE NW 1/4 OF THE NW 1/4  
OF SECTION 36, TOWN 2 NORTH, RANGE 16 EAST,  
VILLAGE OF WILLIAMS BAY, WALWORTH COUNTY, WISCONSIN

— WORK ORDERED BY —  
GERSTAD BUILDERS  
2703 BUSH TERRACE  
McHENRY, IL 60051

TAX ID: WBAIL 00029  
PROPERTY ADDRESS:  
435 ASHLEY DRIVE  
WILLIAMS BAY, WI 53191

BEARINGS MEASURED RELATIVE TO N. LINE NW  
1/4 SECTION 36 (ASSIGNED N 90°00'00" E)  
ROTATE BEARINGS -01°01'12" FOR WISCONSIN  
STATE PLANE COORDINATE SYSTEM, SOUTH  
ZONE BEARINGS

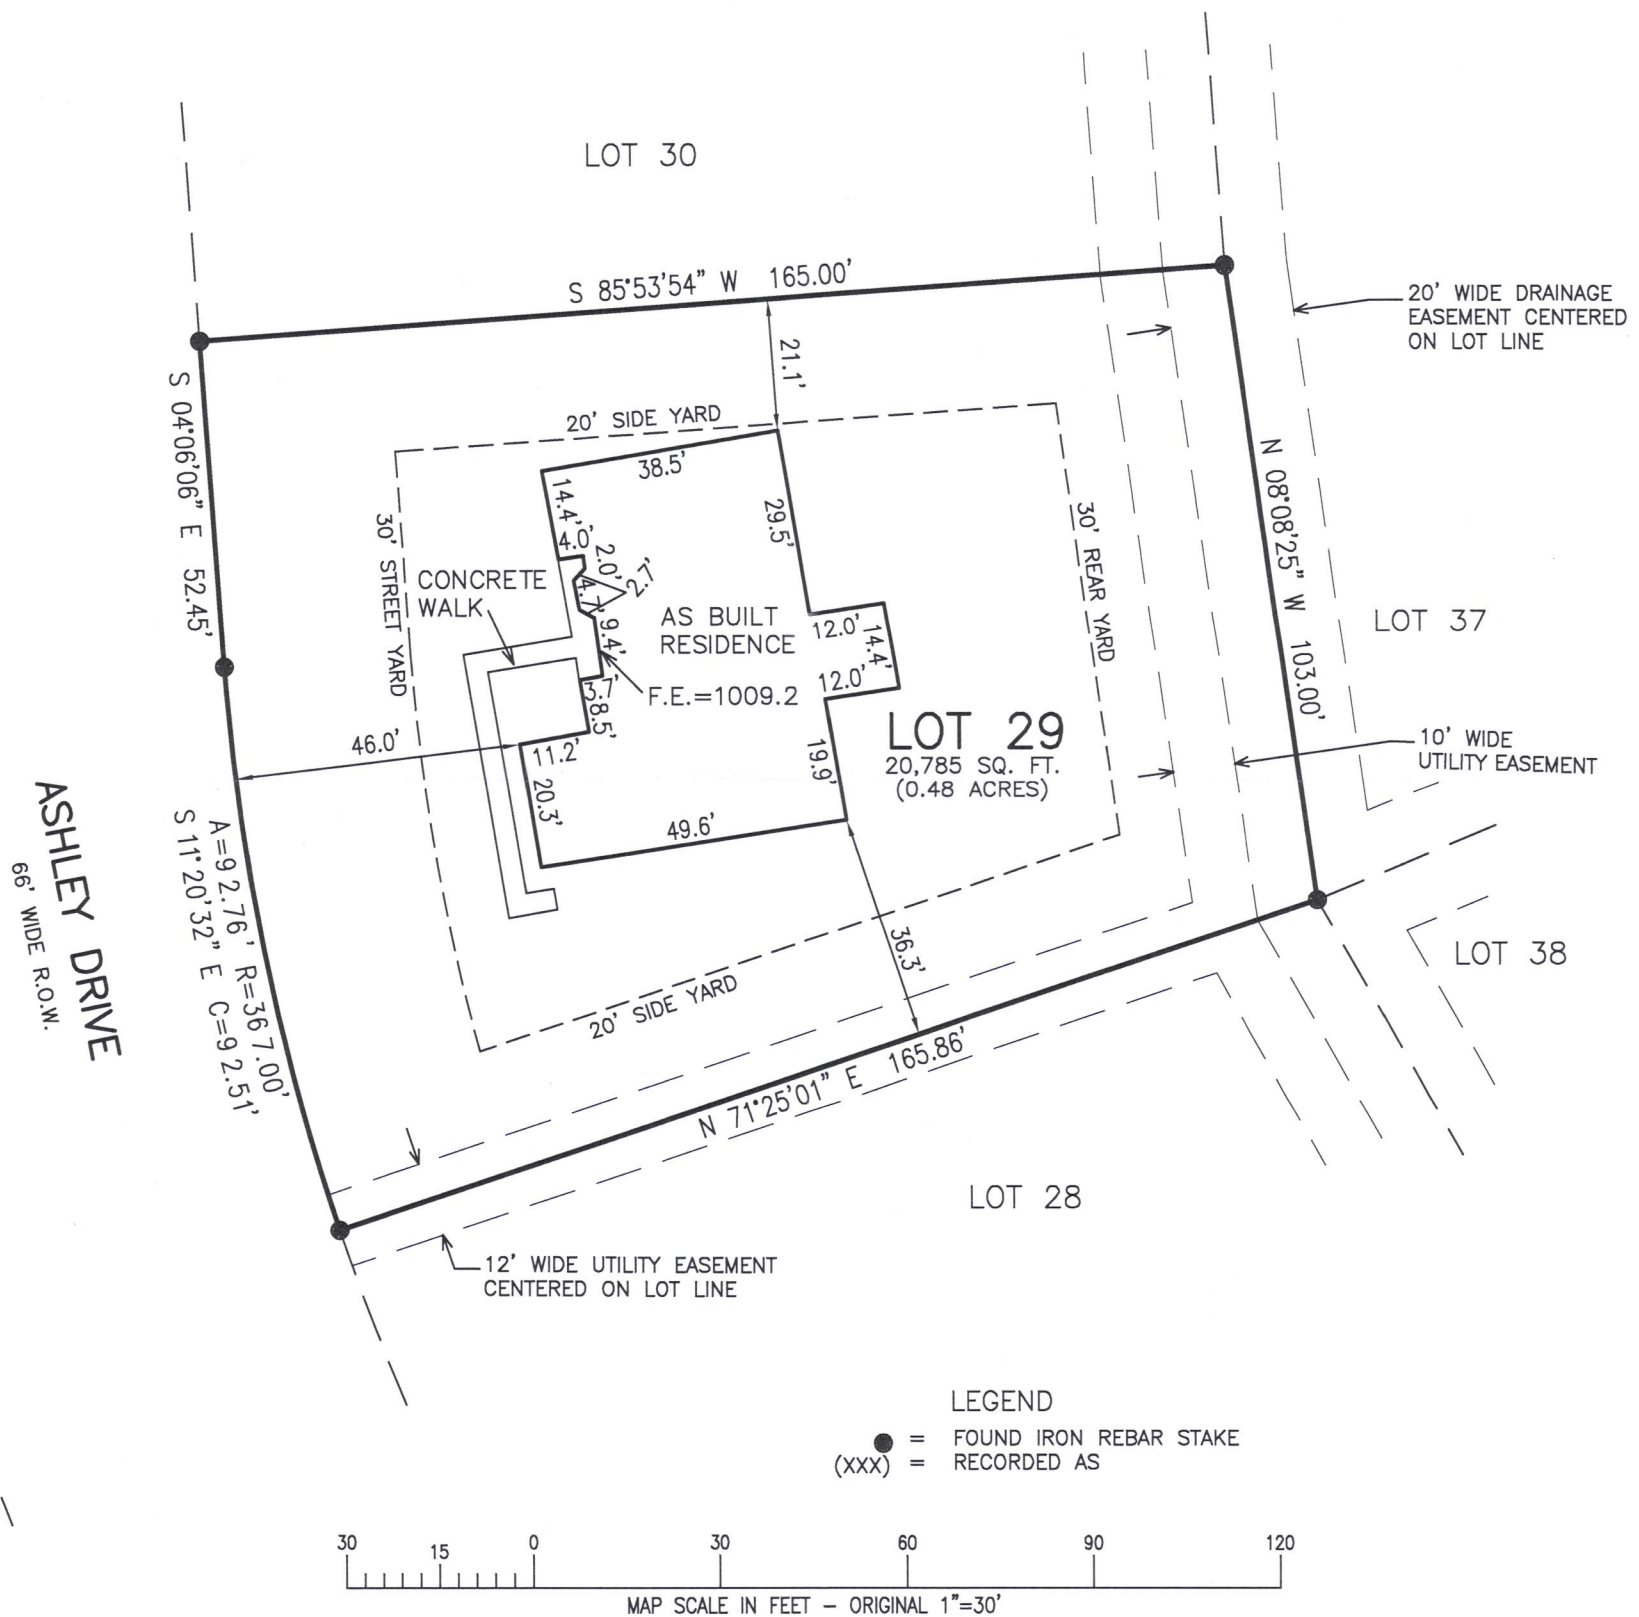

NOTE: COPIES OF THIS MAP TO WHICH THE FOLLOWING CERTIFICATE WILL APPLY SHOW THE SURVEYOR'S ORIGINAL SEAL AND SIGNATURE IN RED INK. COPIES BY ANY OTHER MEANS MAY HAVE ALTERATIONS WHICH DO NOT REPRESENT THE SURVEYOR'S WORK PRODUCT.

I HEREBY CERTIFY THAT THE ABOVE DESCRIBED PROPERTY HAS BEEN SURVEYED UNDER MY DIRECTION AND THAT THE ABOVE MAP IS A TRUE REPRESENTATION THEREOF AND SHOWS THE SIZE AND LOCATION OF THE PROPERTY AND ITS EXTERIOR BOUNDARIES. THIS SURVEY IS MADE FOR THE USE OF THE PRESENT OWNERS OF THE PROPERTY, AND ALSO THOSE WHO PURCHASE, MORTGAGE, OR GUARANTEE THE TITLE THERETO WITHIN ONE YEAR FROM THE DATE HEREOF.


DATED: 12/21/2005

12/28/2017 REVISED TO SHOW  
SIZE AND LOCATION OF PROPOSED  
RESIDENCE.

5/24/2018 REVISED TO SHOW  
AS-BUILT RESIDENCE

BRIAN M. CARLSON P.L.S. 2039

PROJECT: 3249.29  
DATE: 12/21/2005  
SHEET 1 OF 1

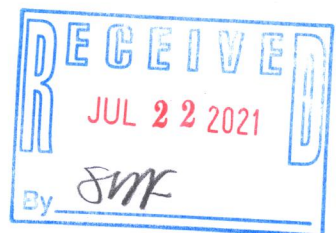

WBAIL-29

011-3055