

HAROLD H. KOLB

REGISTERED PROFESSIONAL LAND SURVEYOR
LAKE GENEVA, WISCONSIN



LINCOLN PARKWAY - 50' WIDE



SCALE: 1" = 40'

LEGEND

- φ — IRON PIPE FOUND
- — IRON PIPE PLACED
- — CONCRETE MONUMENT
- x — SPIKE

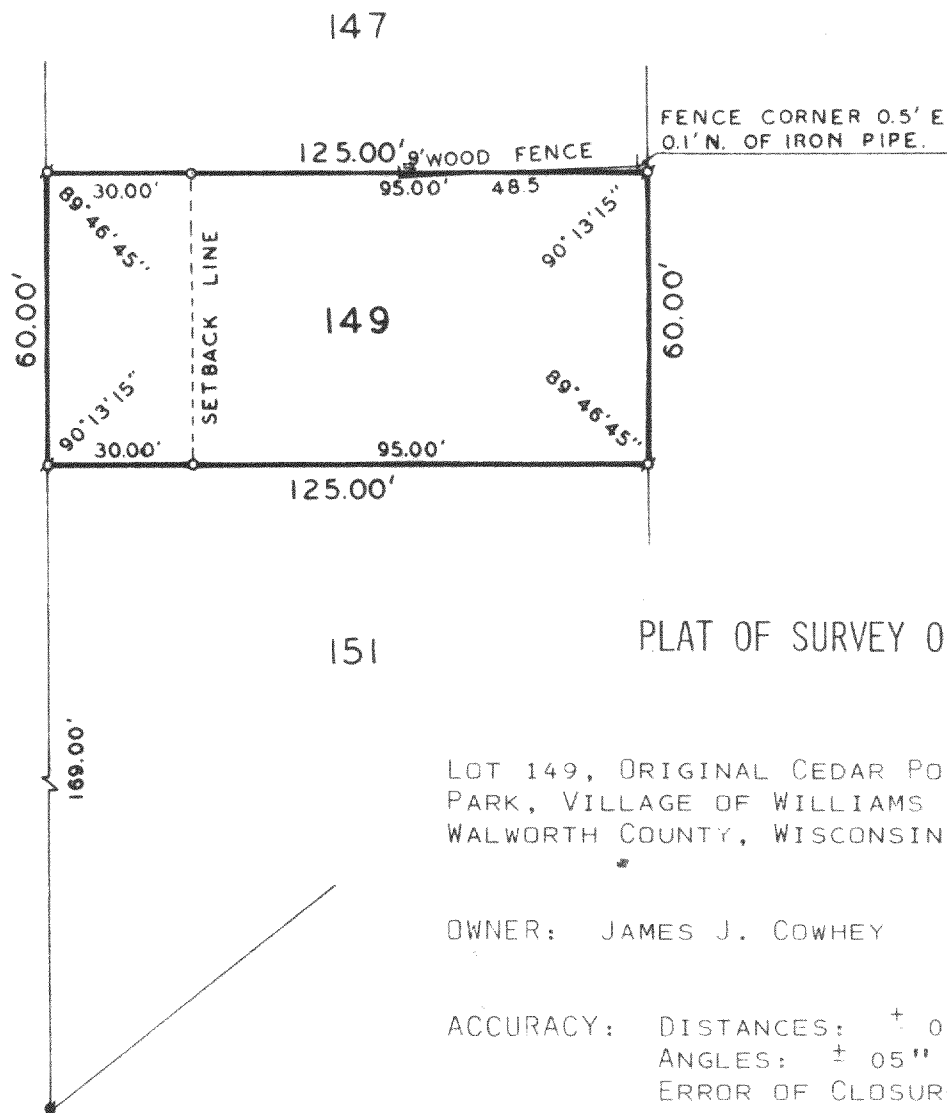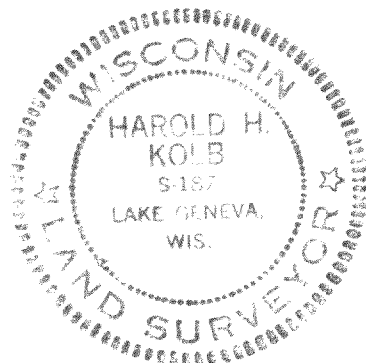

PLAT OF SURVEY OF

LOT 149, ORIGINAL CEDAR POINT
PARK, VILLAGE OF WILLIAMS BAY,
WALWORTH COUNTY, WISCONSIN.


OWNER: JAMES J. COWHEY

ACCURACY: DISTANCES: $\pm 0.01'$
ANGLES: $\pm 05''$
ERROR OF CLOSURE:
LESS THAN ONE PART
IN 3,000

I, HAROLD H. KOLB, DO HEREBY CERTIFY THAT I HAVE
SURVEYED THE PROPERTY HEREON DESCRIBED ACCORDING
TO THE OFFICIAL RECORDS, AND THAT THE PLAT HEREON
IS A CORRECT REPRESENTATION OF THE LOT LINES.

Harold H. Kolb
HAROLD H. KOLB
WISCONSIN REGISTERED LAND SURVEYOR, S-187
DATE Feb. 27, 1976

11-308

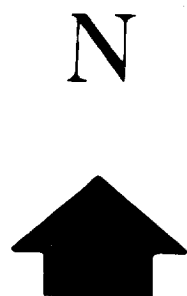

LINCOLN PARKWAY · 50' W

E

60.00'

90° 13' 15"

30.00'

LOT
VILL
COUN

OWNE
ACCU

NOTE

wcp-122