


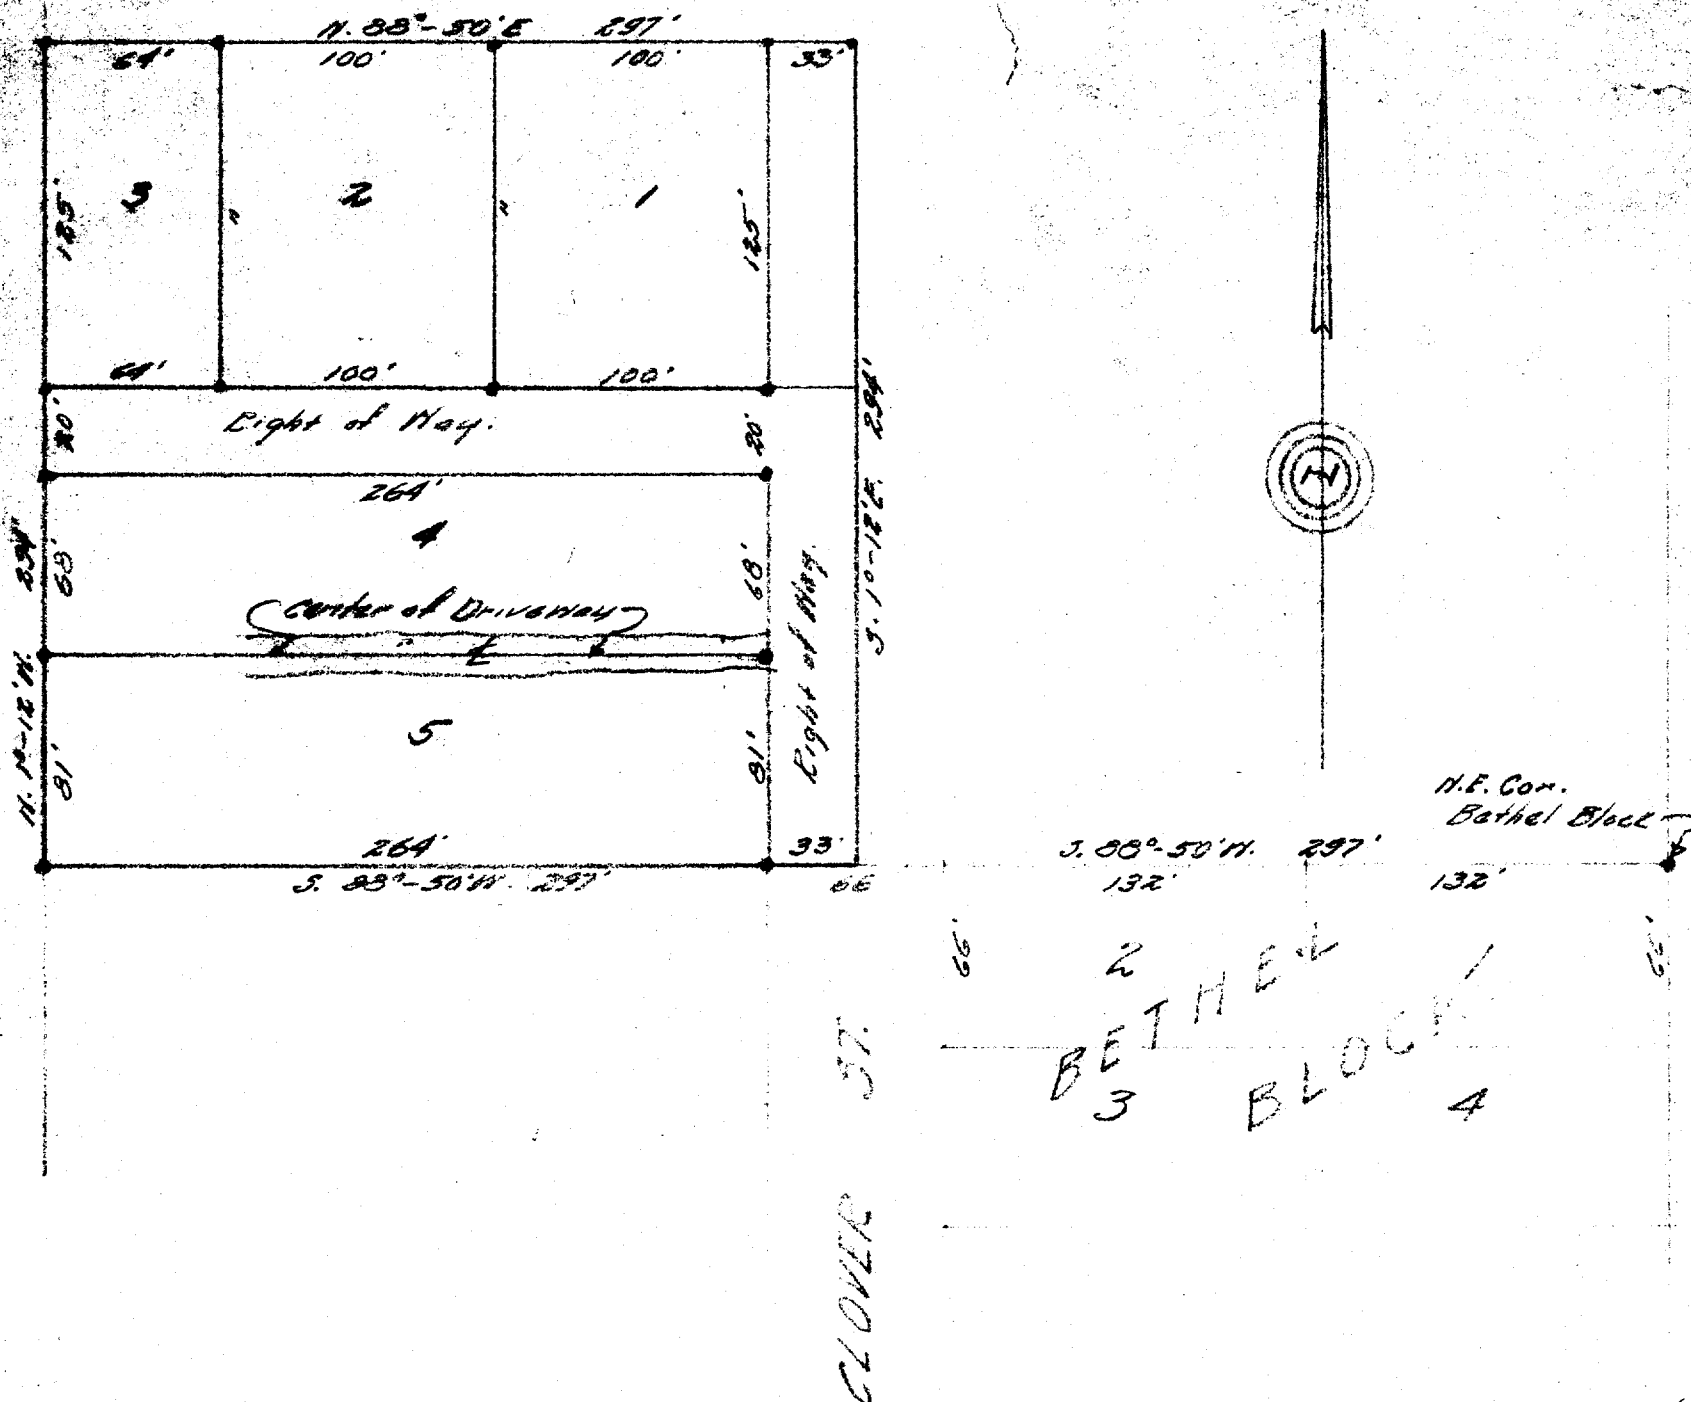

DESCRIPTION: Tract #3

Commencing at an iron stake that is 530 feet S. 88°30' E. of and 169 feet N. 1°12' W. of the N.E. corner of Bethel Block Subdivision of a portion of the Village of Williams Bay, Walworth County, Wisconsin, thence S. 88°30' E. 34 feet to an iron stake, thence N. 1°12' W. 125 feet to an iron stake, thence N. 88°30' E. 68 feet to an iron stake, thence E. 1°12' E. to an iron stake the place of beginning. Also a right of way in, along and across the following described property, the centerline of which is described as follows to wit: A strip of land 33 feet in width commencing at a point that is 313.5 feet S. 88°30' E. of the aforesaid corner of Bethel Block, thence N. 1°12' W. 169 feet, A strip of land 20 feet in width, commencing at a point that is 330 feet, S. 88°30' W. of and N. 1°12' W., 169 feet of the aforesaid corner of Bethel Block, thence S. 88°30' W., 264 feet.

DESCRIPTION: Tract #4

Commencing at an iron stake that is 330 feet S. 88°30' E. of and N. 1°12' W. 31 feet of the N.E. corner of Bethel Block Subdivision of a portion of the Village of Williams Bay, Walworth County, Wisconsin, thence S. 88°30' E. 264 feet to an iron stake, thence N. 1°12' W., 68 feet to an iron stake, thence N. 88°30' E., 34 feet to an iron stake, thence S. 1°12' W., 64 feet to an iron stake the place of beginning. Also a right of way in along and across the following described property, the centerline of which is described as follows to wit: A strip of land 33 feet in width commencing at a point that is 313.5 feet S. 88°30' E. of the aforesaid corner of Bethel Block, thence N. 1°12' W. 169 feet, A strip of land 20 feet in width, commencing at a point that is 330 feet, S. 88°30' W. of and N. 1°12' W., 169 feet of the aforesaid corner of Bethel Block, thence S. 88°30' W., 264 feet.

Certificate:

I, hereby certify that I have on this the 6th day of February 1946, surveyed the above described property according to the official records on file in the Office of the Recorder of Deeds in and for Walworth County, Wisconsin, and find that the measurements and bearings of the boundary lines of said property as taken at the site on this day, substantially agree with those shown on the plat above and given in the above descriptions, and that no encroachments exist.

SIGNED AND SEALED THIS 8TH DAY OF FEBRUARY 1946.

Joseph M. Biagi
Joseph M. Biagi, Professional Engineer
Elkhorn, Wisconsin.