


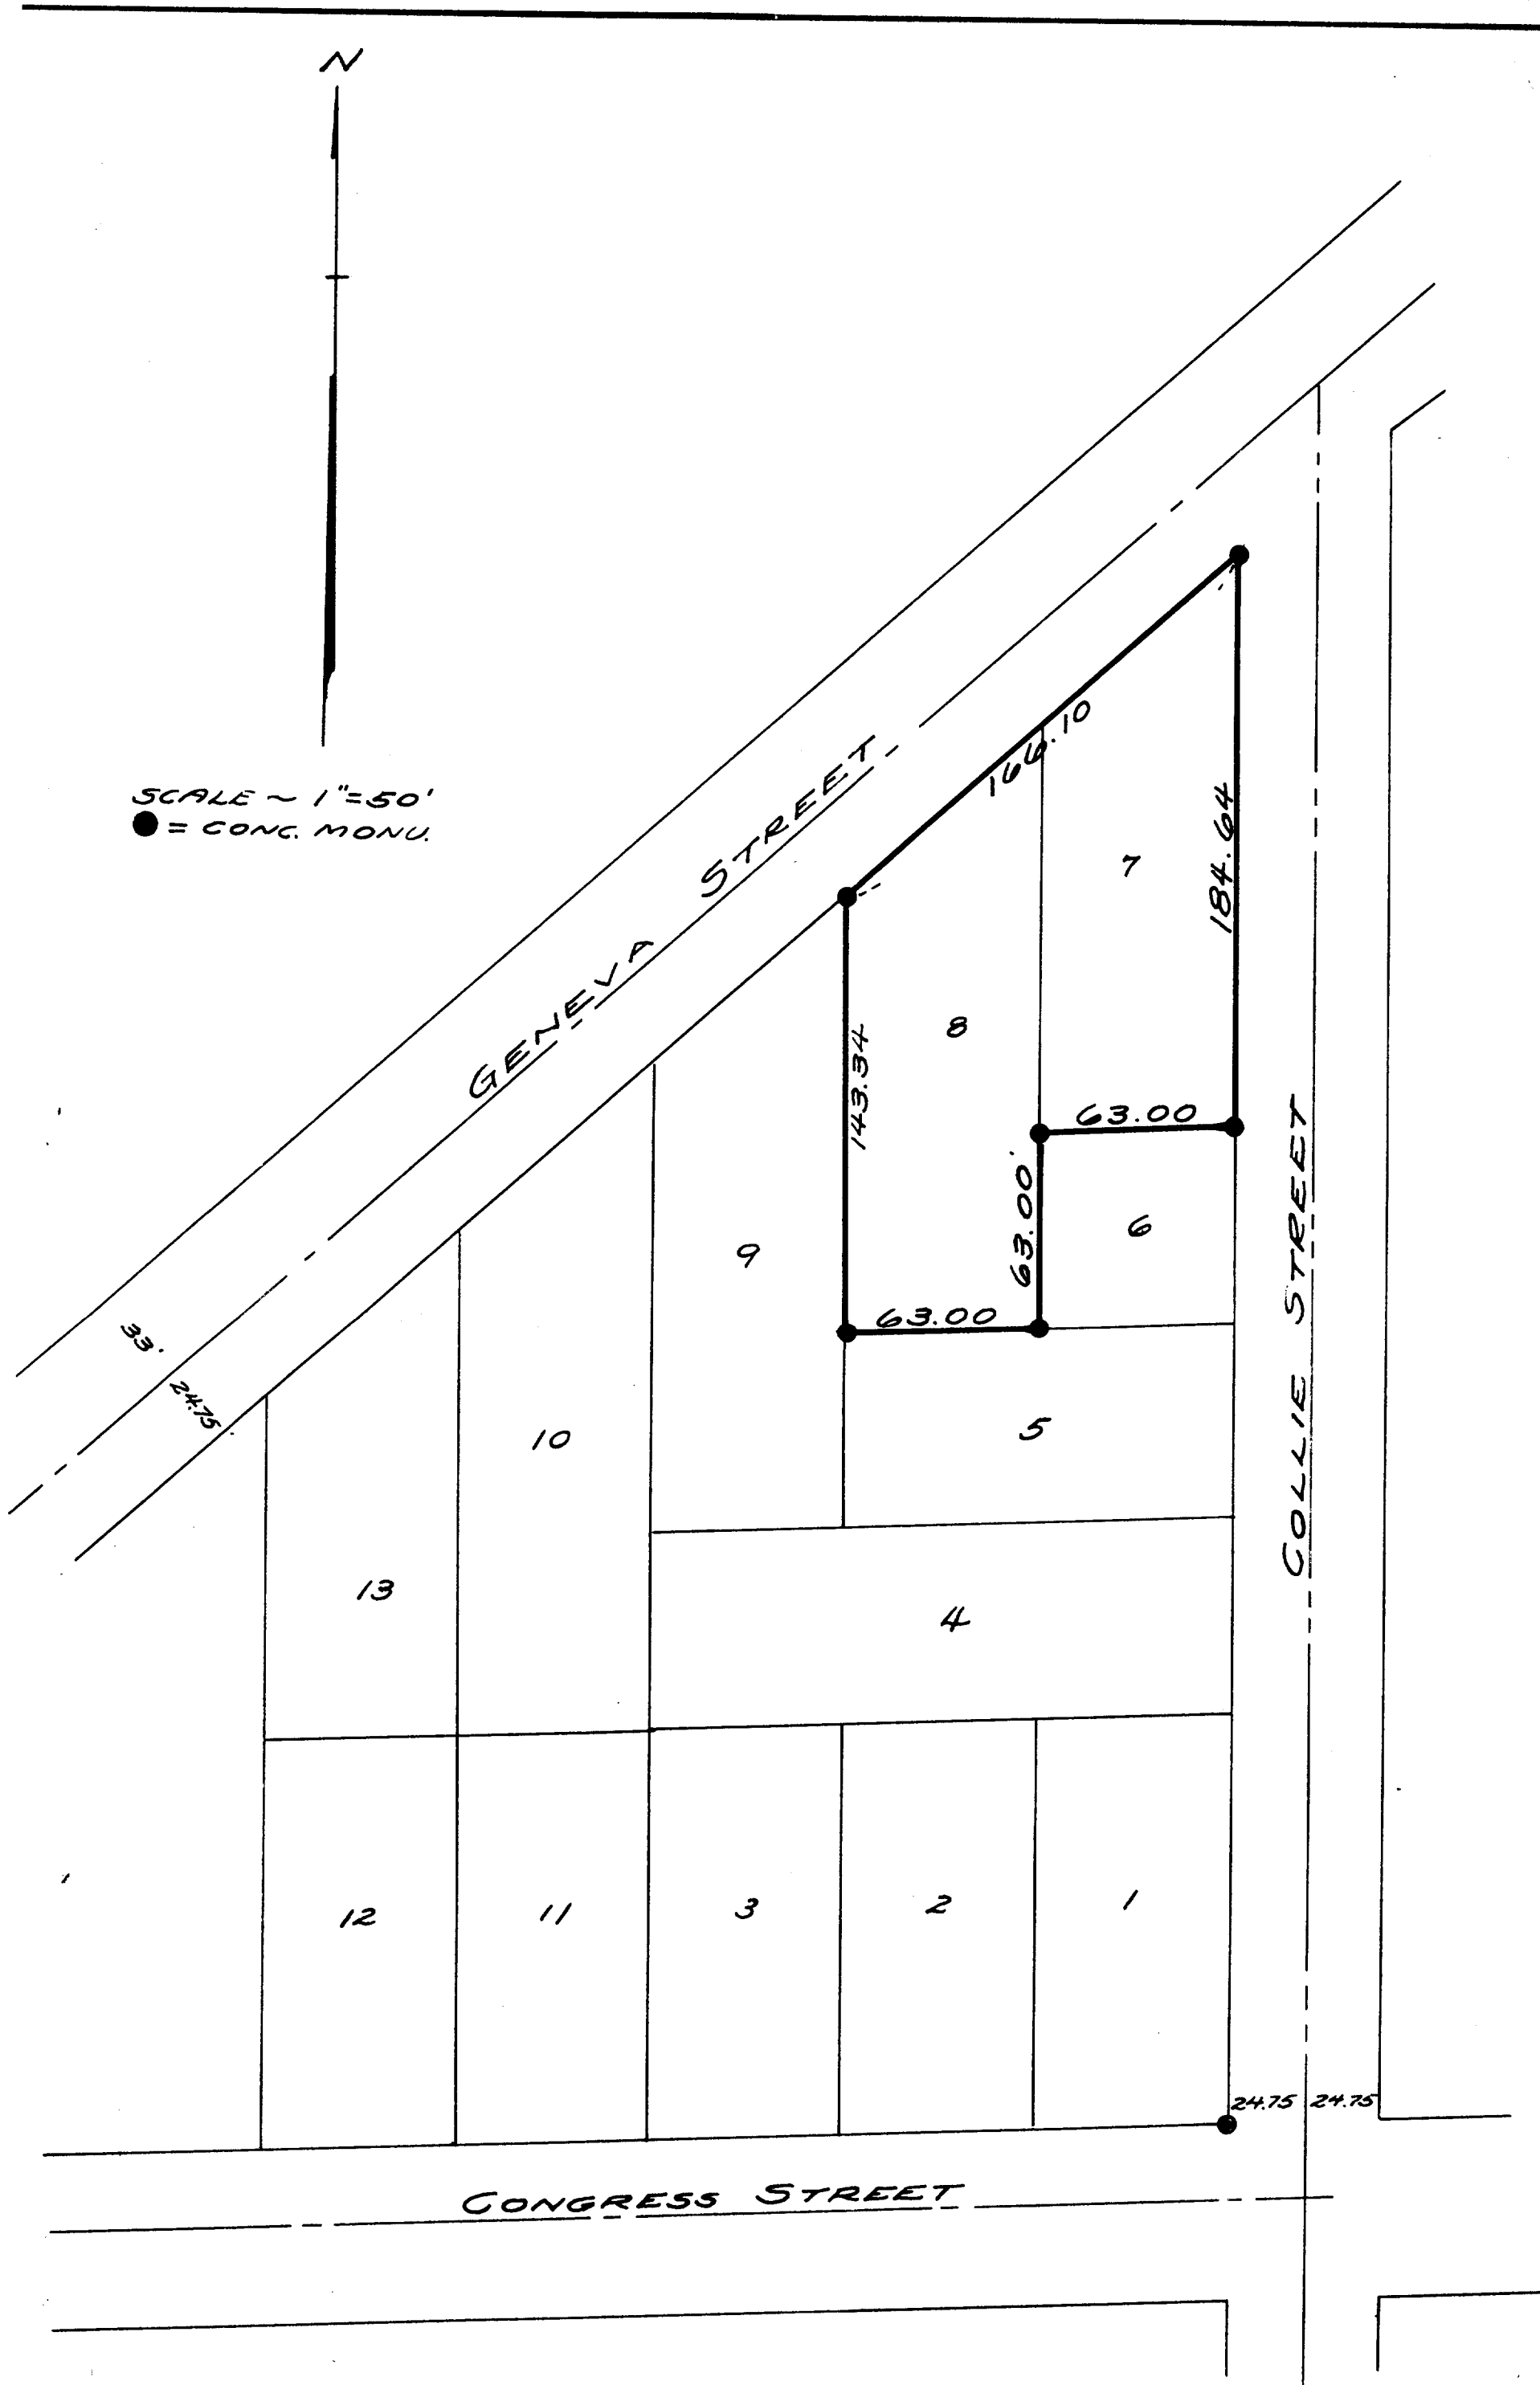

I HEREBY CERTIFY THAT I HAVE SURVEYED LOTS 7 AND 8 OF  
MADISON'S ADDITION TO THE VILLAGE OF WILLIAMS BAY, AND THAT  
THE ABOVE PLAT IS A CORRECT REPRESENTATION THEREOF.

DECEMBER 10, 1946

wma-6,7

11-30 J

H. E. Johnson  
SURVEYOR