

PLAT OF SURVEY AND TOPOGRAPHIC MAPPING LOT 16 OF LOCH VISTA CLUB SUBDIVISION NO. 1



LOCATED IN PART OF THE SE 1/4 AND SW 1/4 OF THE SE 1/4 OF SECTION 1, TOWN 1 NORTH, RANGE 16 EAST,
VILLAGE OF WILLIAMS BAY, WALWORTH COUNTY, WISCONSIN

BENCH MARK—
CHISELED "X" ON
HYDRANT FLANGE BOLT
ELEVATION=942.86'

UPPER LOCH VISTA DRIVE
{30' WIDE R.O.W.}


MANHOLE
RIM=944.3

CORNER OF CONCRETE
RETAINING WALL ON
BOUNDARY

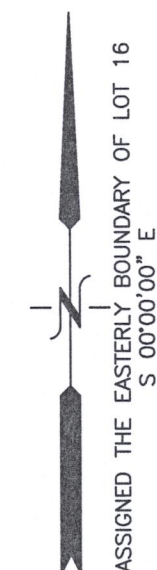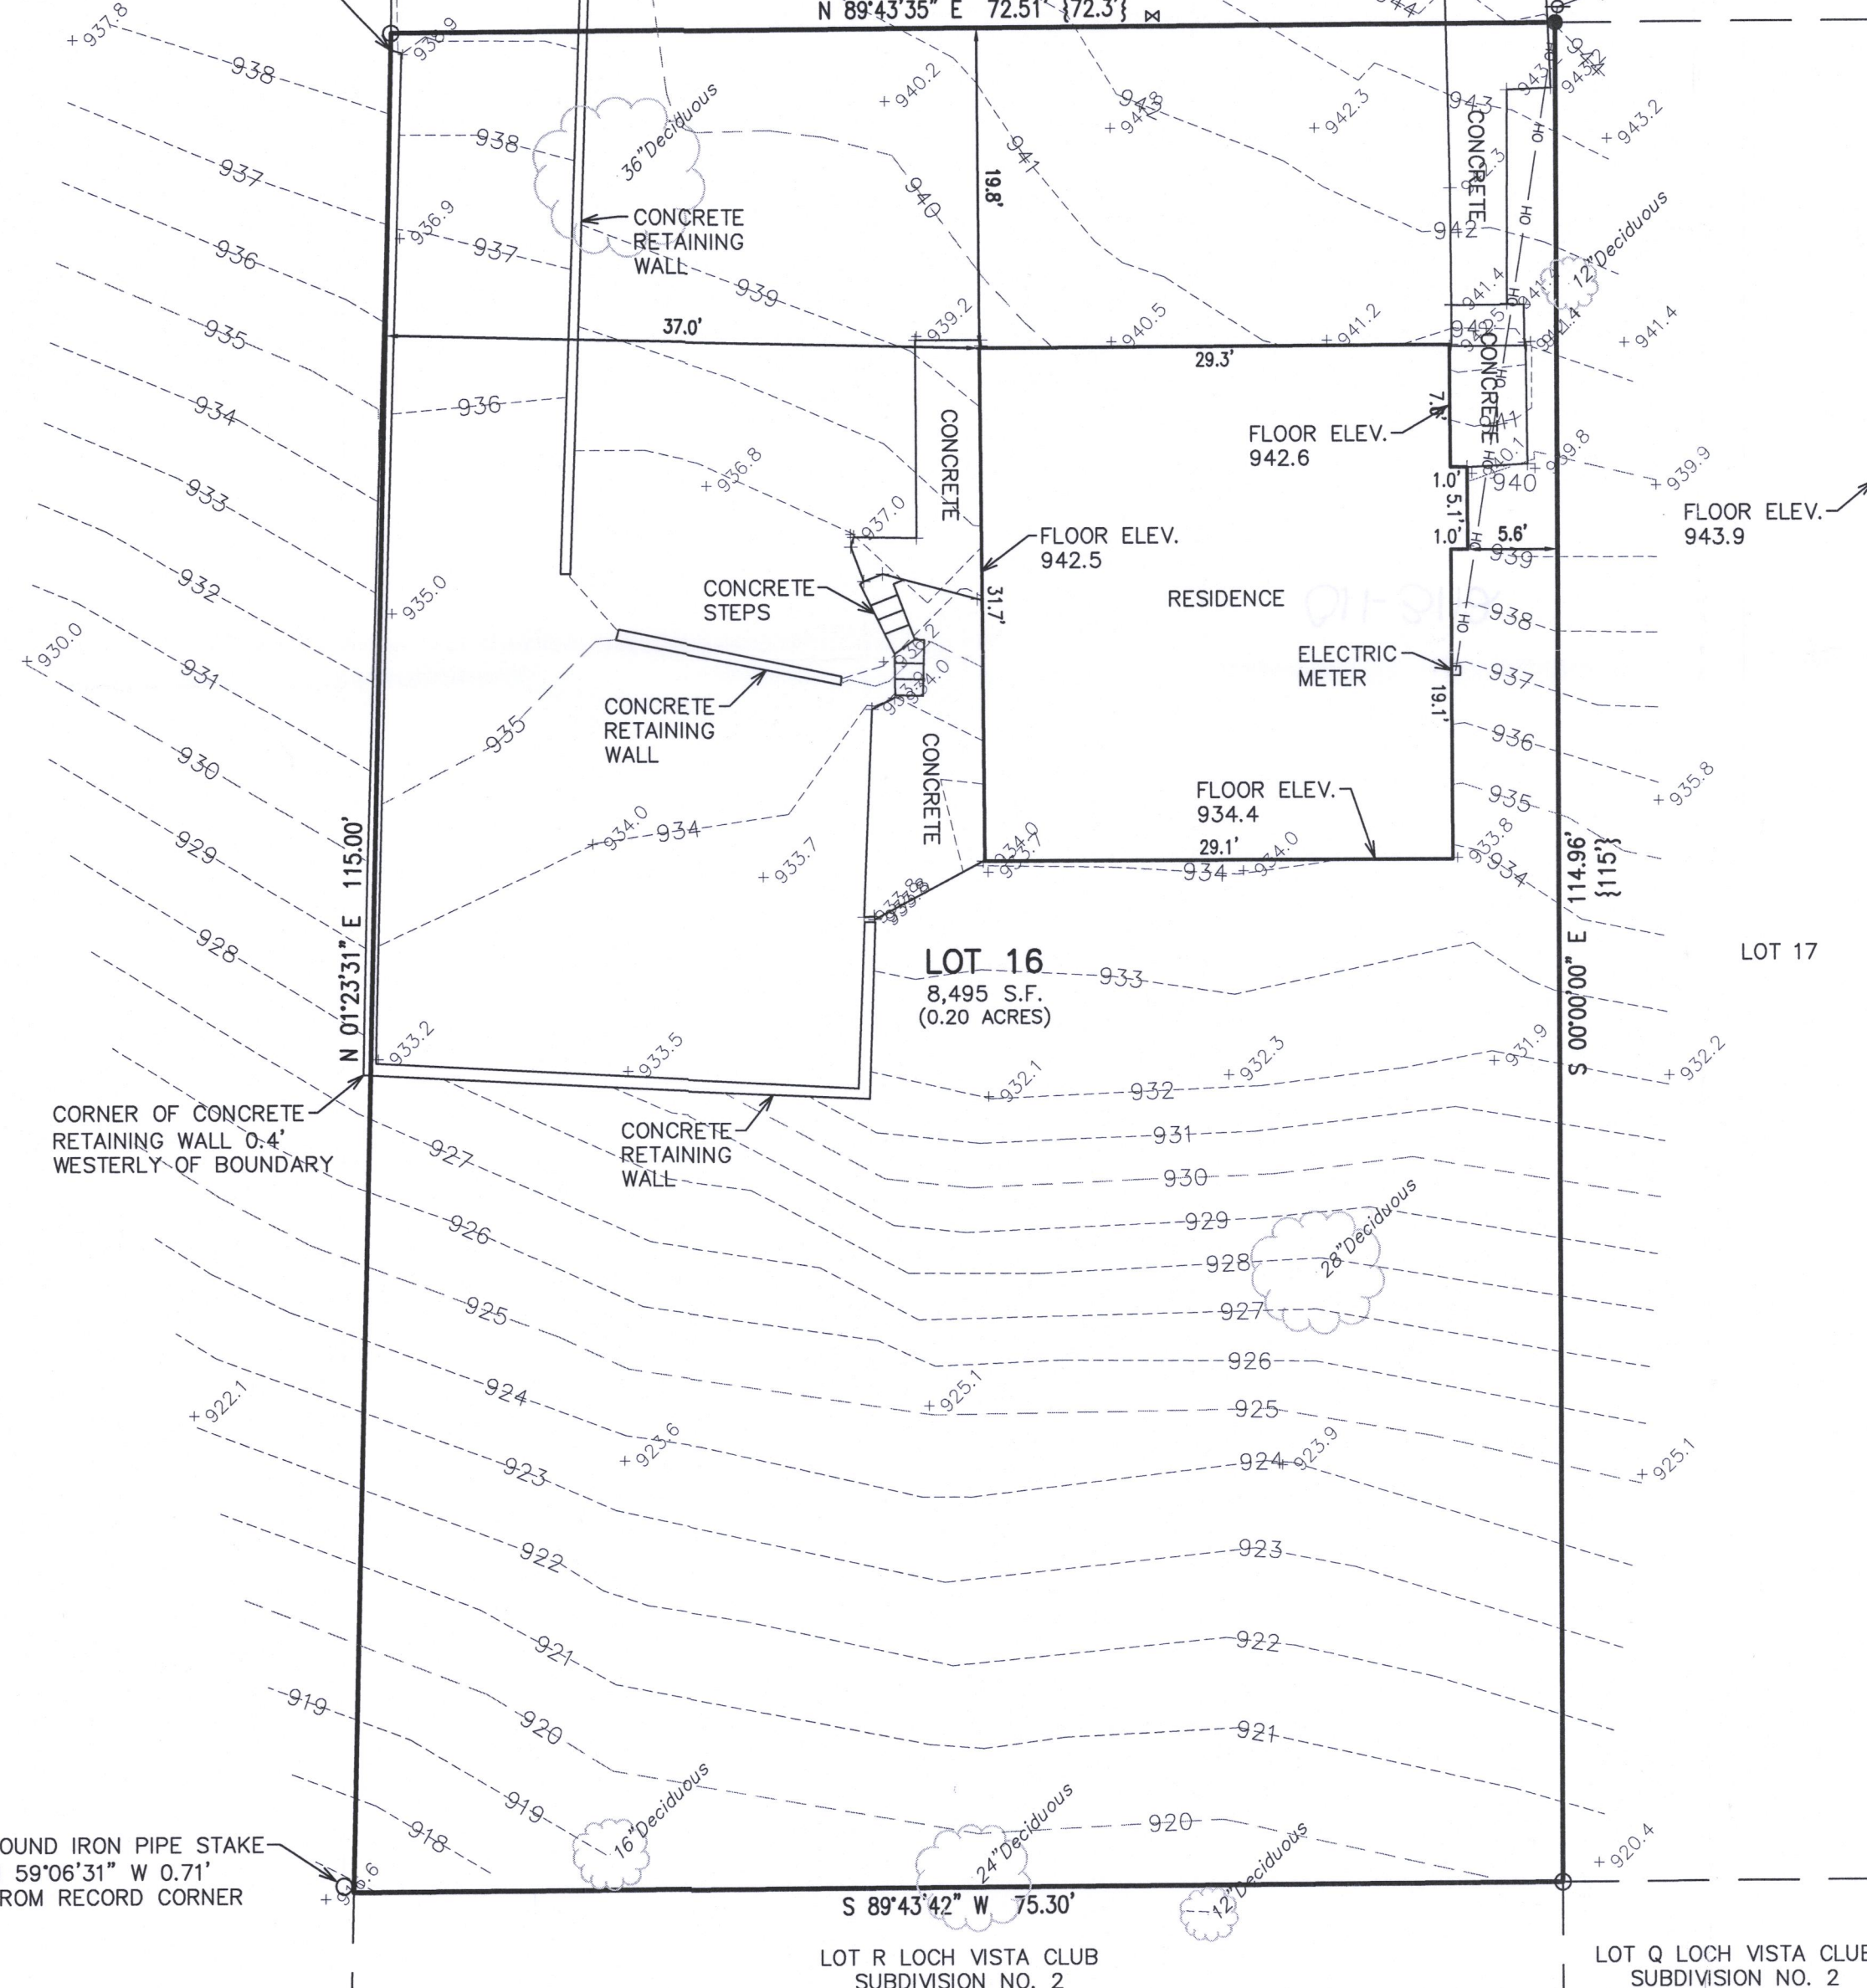

LEGEND

- = FOUND IRON PIPE STAKE
- = FOUND IRON REBAR STAKE
- ⊕ = UTILITY POLE LOCATED
- OH — = OVERHEAD WIRES
- ⋈ = WATER VALVE LOCATED
- {XXX} = RECORDED AS

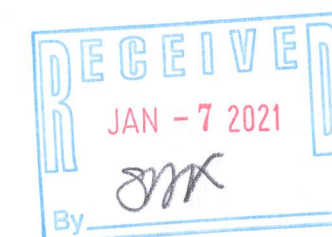

NOTE: COPIES OF THIS MAP TO WHICH THE FOLLOWING CERTIFICATE WILL APPLY SHOW THE SURVEYOR'S ORIGINAL SEAL AND SIGNATURE IN RED INK. COPIES BY ANY OTHER MEANS MAY HAVE ALTERATIONS WHICH DO NOT REPRESENT THE SURVEYOR'S WORK PRODUCT.

I HEREBY CERTIFY THAT THE ABOVE DESCRIBED PROPERTY HAS BEEN SURVEYED UNDER MY DIRECTION AND THAT THE ABOVE MAP IS A TRUE REPRESENTATION THEREOF AND SHOWS THE SIZE AND LOCATION OF THE PROPERTY AND ITS EXTERIOR BOUNDARIES. THIS SURVEY IS MADE FOR THE USE OF THE PRESENT OWNERS OF THE PROPERTY, AND ALSO THOSE WHO PURCHASE, MORTGAGE, OR GUARANTEE THE TITLE THERETO WITHIN ONE YEAR FROM THE DATE HEREOF.

DATED: 11/4/2021

Christopher A. Hodges
CHRISTOPHER A. HODGES P.L.S. 2760



TOPOGRAPHIC SURVEY
111 UPPER LOCH VISTA DRIVE
WILLIAMS BAY, WISCONSIN

WORK ORDERED BY —
JIM REPSOLD
1100 HINMAN AVENUE
EVANSTON, IL 60202

FARRIS, HANSEN & ASSOCIATES, INC.
ENGINEERING — ARCHITECTURE — SURVEYING
7 RIDGWAY COURT P.O. BOX 437
ELKHORN, WISCONSIN 53121
OFFICE: (262) 723-2098 FAX: (262) 723-5886

REVISIONS

PROJECT NO.
10577
DATE:
11/04/2021
SHEET NO.
1 OF 1