


ENGINEERING — ARCHITECTURE — SURVEYING
7 RIDGWAY COURT — P.O. BOX 437 — ELKHORN, WISCONSIN 53121
PHONE: (262) 723-2098 FAX: (262) 723-5886

LOT 168 OF BAILEY ESTATES, A SUBDIVISION
LOCATED IN PART OF THE SW 1/4 OF THE NW 1/4
OF SECTION 36, TOWN 2 NORTH, RANGE 16 EAST,
VILLAGE OF WILLIAMS BAY, WALWORTH COUNTY, WISCONSIN

— WORK ORDERED BY —
GERSTAD BUILDERS
2703 BUSH TERRACE
MC HENRY, IL 60051

BEARINGS MEASURED RELATIVE TO
NORTH LINE NW 1/4 SECTION 36
(ASSIGNED N_{190°00'00"} E)

ROTATE BEARINGS -01°01'12" FOR
WISCONSIN STATE PLANE COORDINATE
SYSTEM, SOUTH ZONE BEARINGS

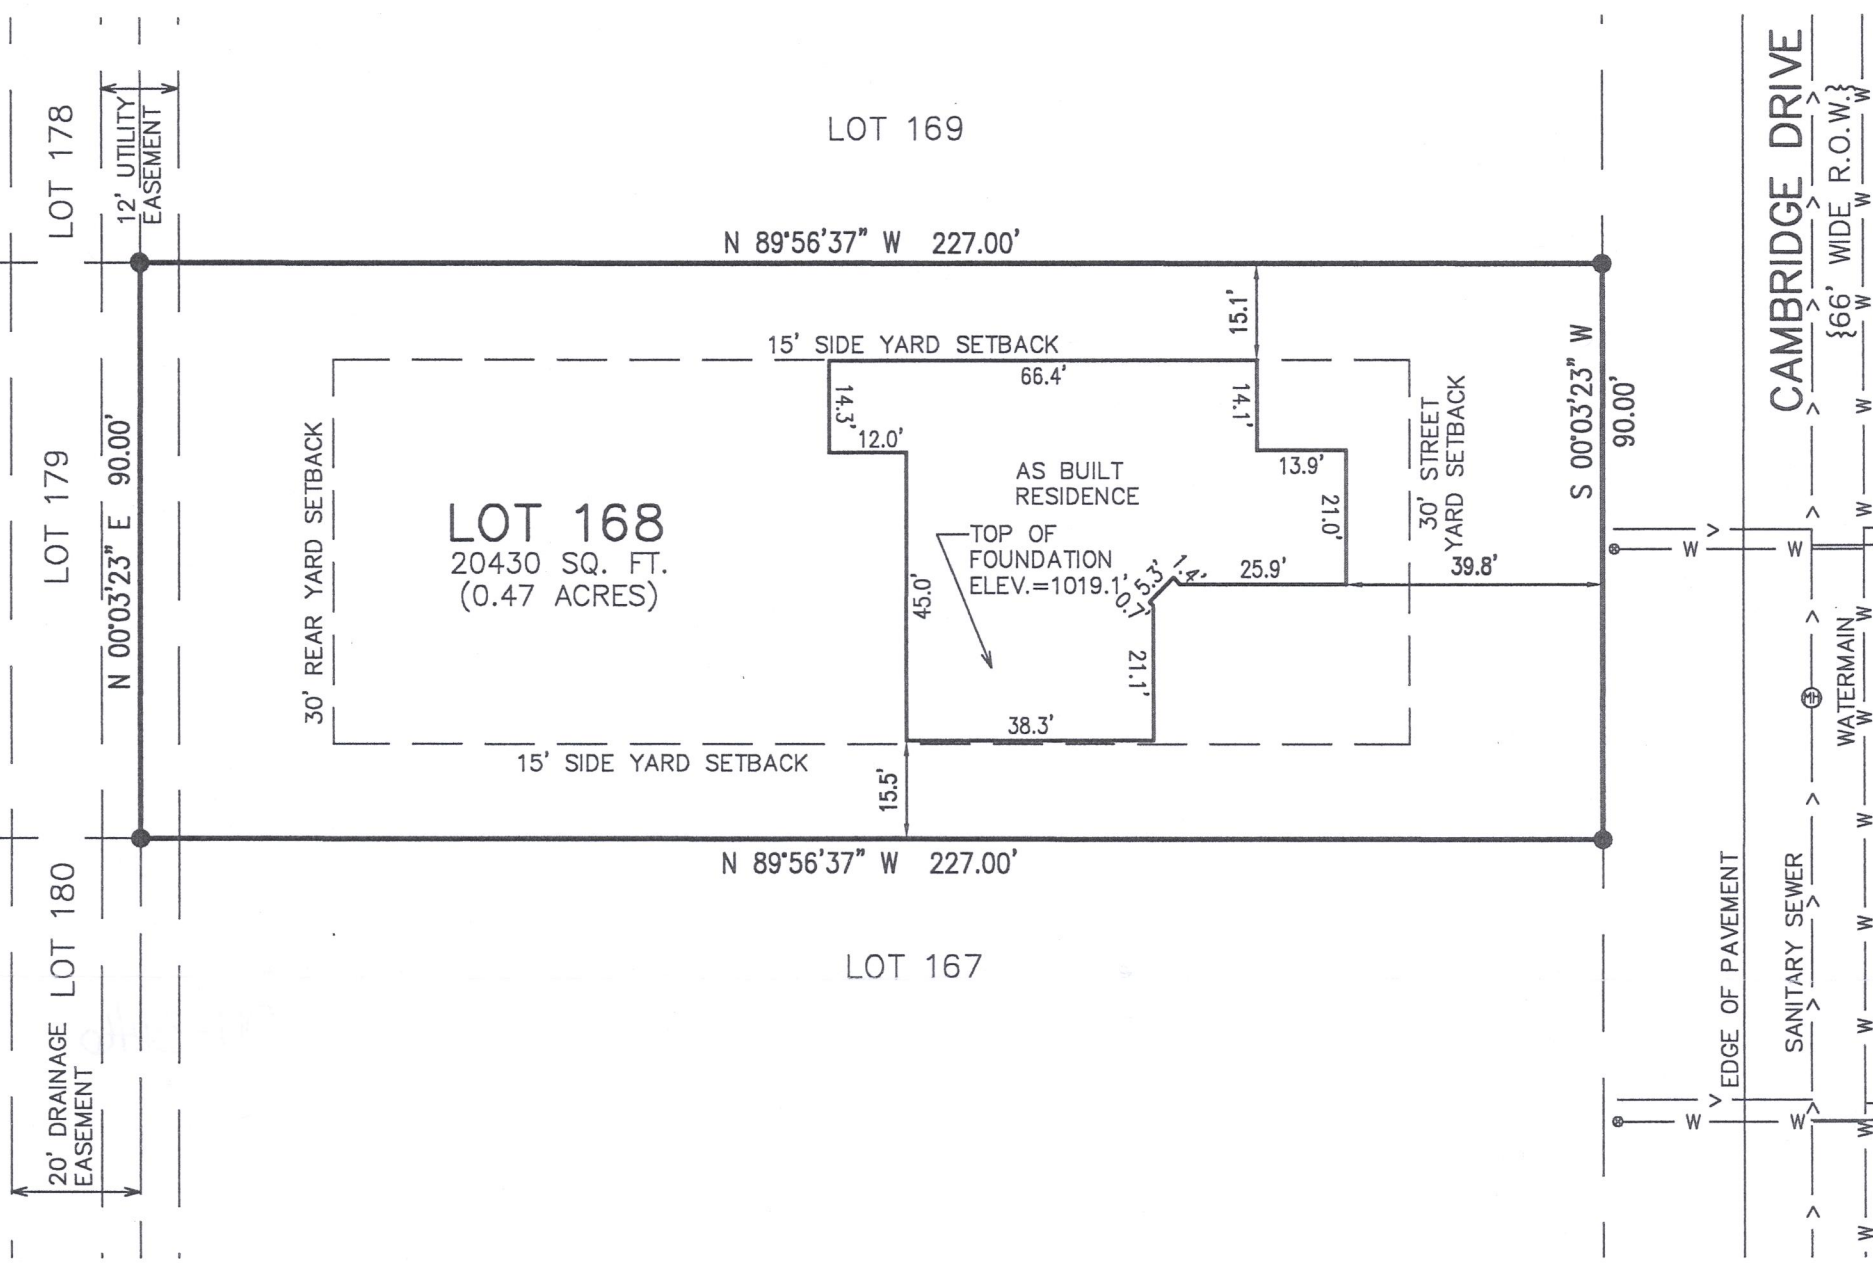

MAP SCALE IN FEET - ORIGINAL 1"=30'

- = FOUND IRON REBAR STAKE
- Ⓜ = SANITARY SEWER MANHOLE
- ⊗ = WATER VALVE

RECEIVED
JUL - 7 2022
By SMK

DATED: 17/07/2018

REVISED 04/15/2022 TO
SHOW SIZE AND LOCATION
OF AS BUILT FOUNDATION


CHRISTOPHER A. HODGES P.L.S. 2760



PROJECT: 3249.168
DATE: 11/07/2018
SHEET 1 OF 1

WPBAL-168

011-3146