


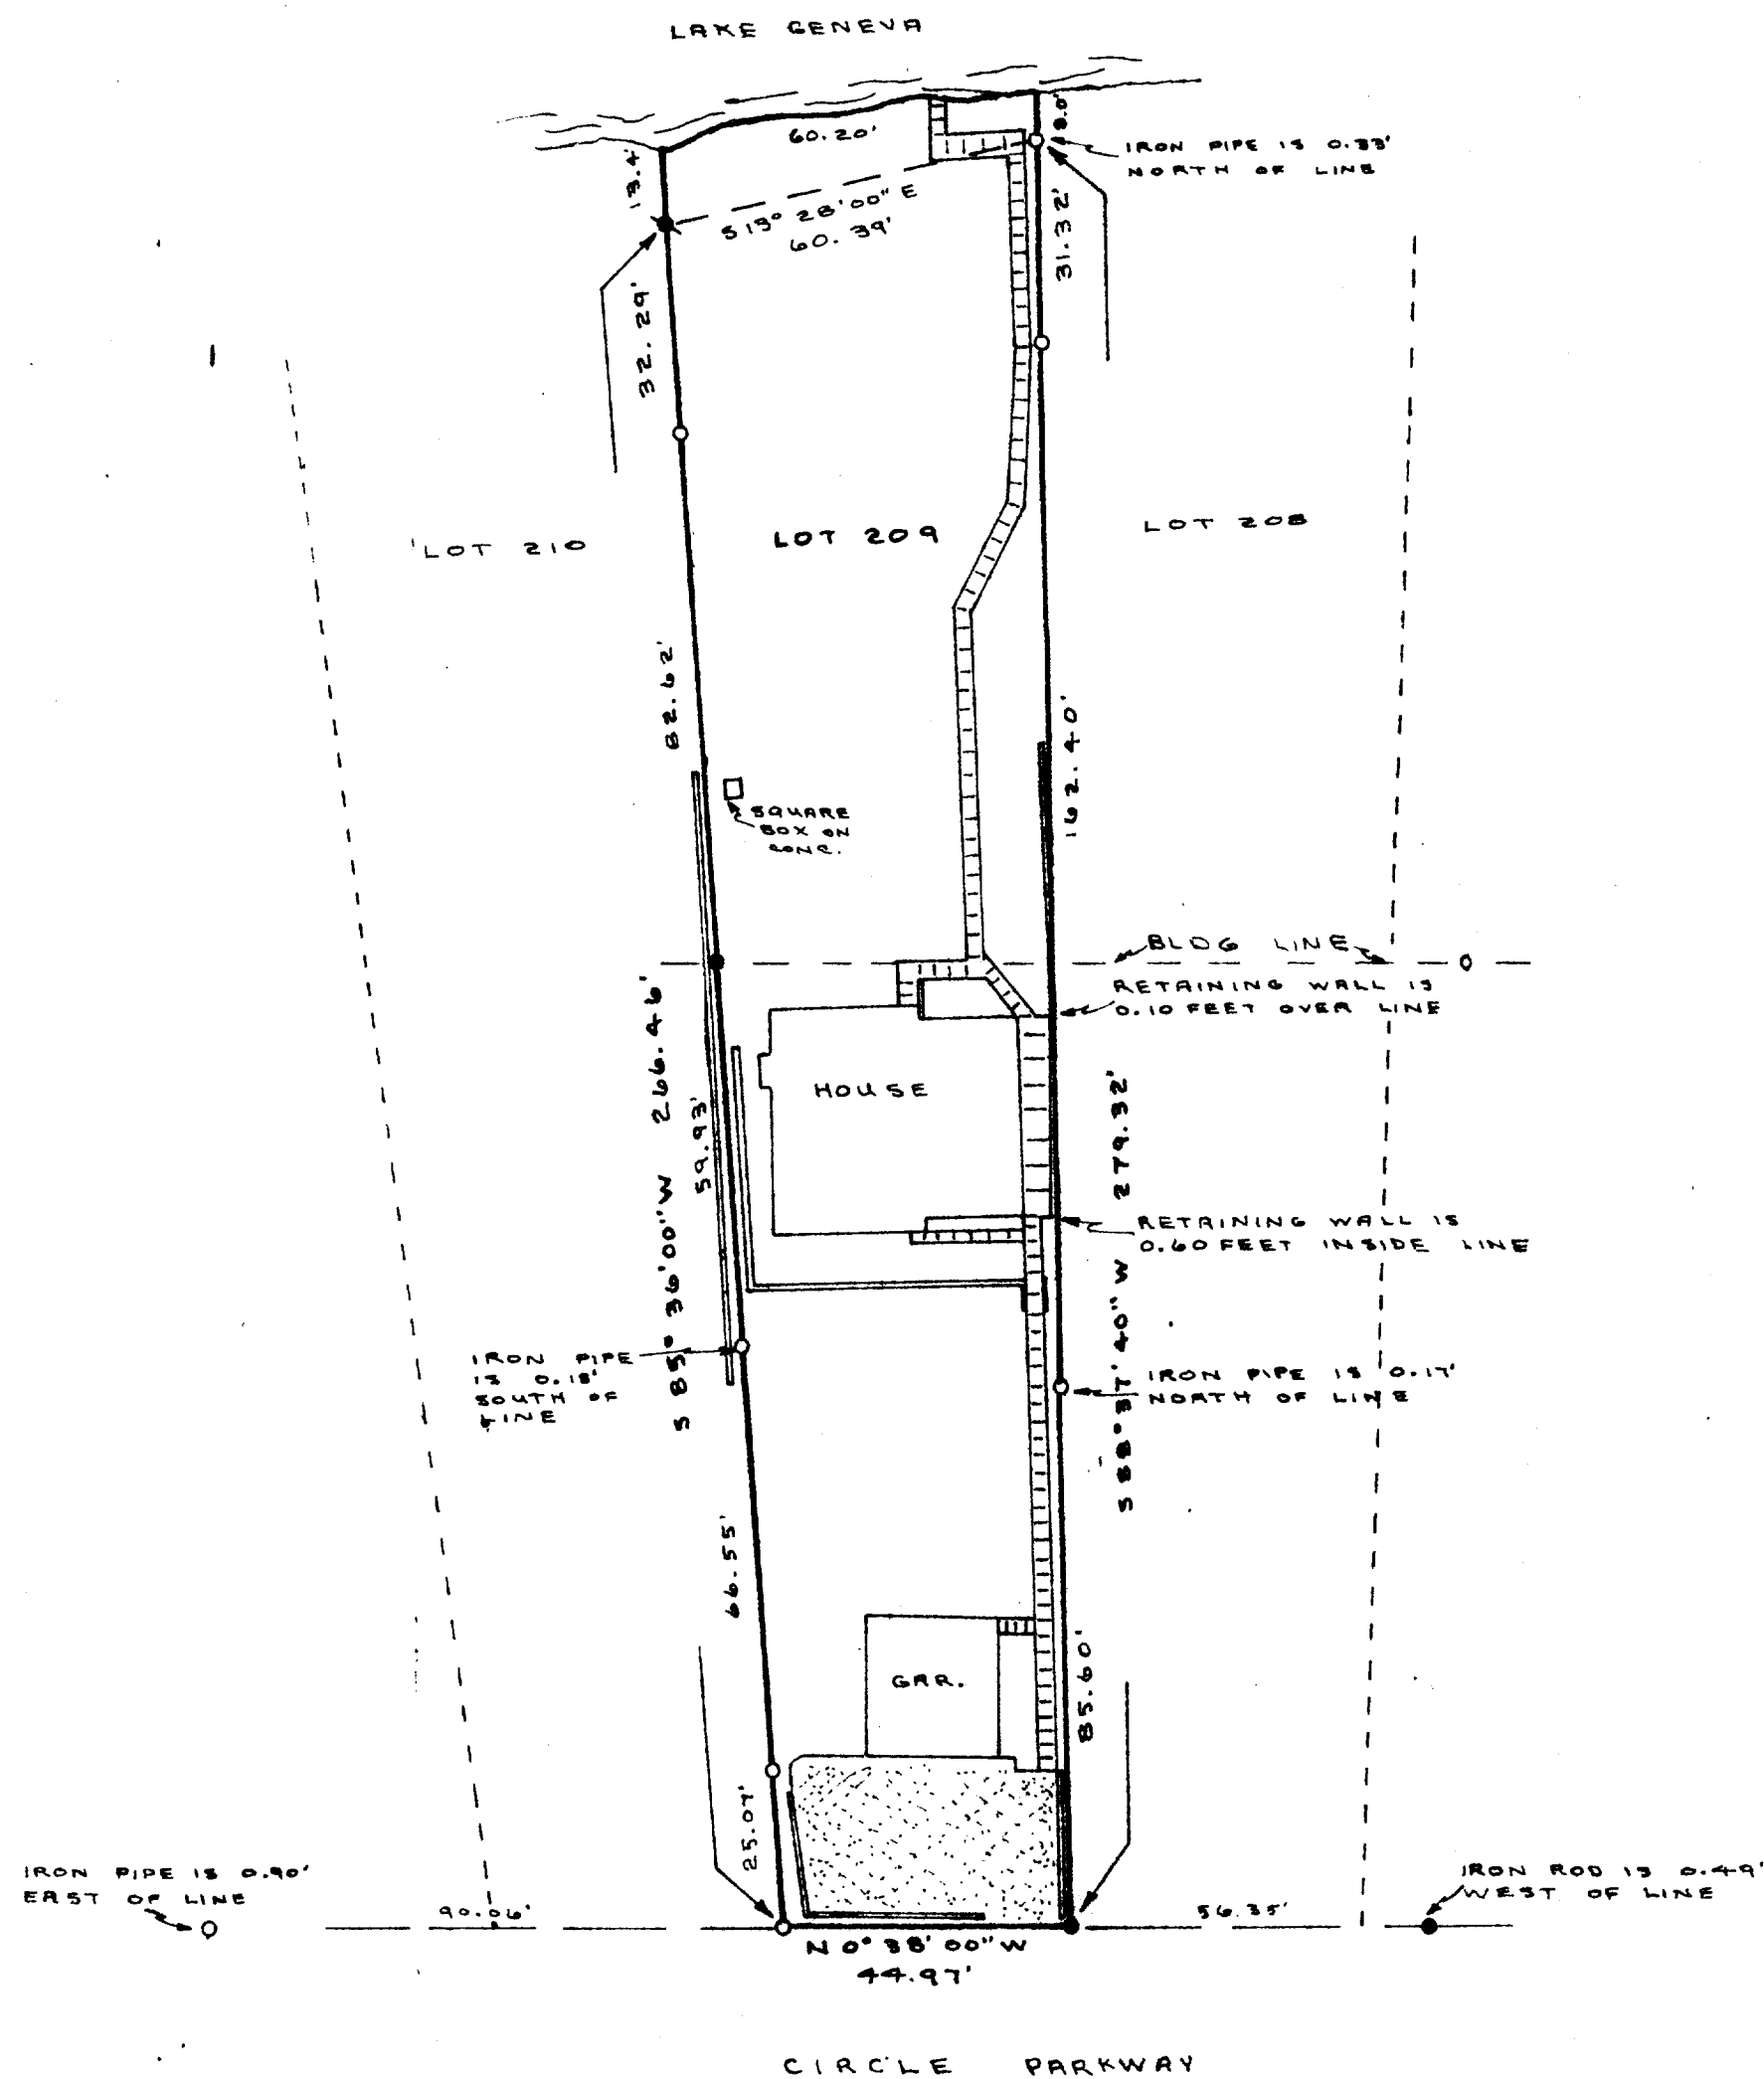

SOUTH LINE OF LOT 209 IN THIRD ADDITION TO CEDAR POINT PARK, VILLAGE OF WILLIAMS BAY ASSUMED $S85^{\circ}36'00''W$

SCALE 1" = 30'

- FOUND IRON PIPE 1" DI.
- FOUND IRON ROD 3/8" DI.
- ⊙ SET IRON ROD 3/4" DI. X 24" LONG
- III SIDEWALKS & STEPS
- RETAINING WALLS
- ⊙ BLACK TOP PARKING

THE PROPERTY DESCRIBED BELOW HAS BEEN SURVEYED UNDER MY DIRECTION AND THE ABOVE MAP IS A TRUE REPRESENTATION THEREOF AND SHOWS THE SIZE AND LOCATION OF THE PROPERTY, ITS EXTERIOR BOUNDARIES AND THE LOCATION OF ALL STRUCTURES THEREON TO THE BEST OF MY KNOWLEDGE AND ABILITY


DATED THIS 9TH DAY OF July, 1976

Thomas P. A. Jensen
THOMAS P. A. JENSEN

REGISTERED LAND SURVEYOR NO. 5-1084

OWNER: HELEN F. RONGSTED

0.340 ACRES

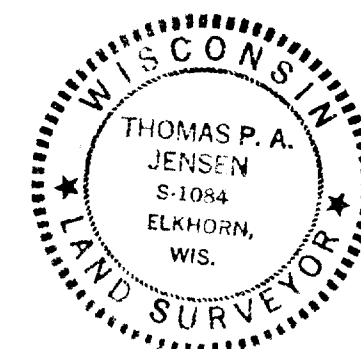

PLAT OF SURVEY OF

LOT 209 IN THIRD ADDITION TO CEDAR POINT PARK, LOCATED IN THE SOUTH EAST 1/4 OF SECTION 6, TOWN 1 NORTH, RANGE 17 EAST, VILLAGE OF WILLIAMS BAY, WALWORTH COUNTY, WISCONSIN.

Thomas P. A. Jensen
SURVEYOR

SCALE 1" = 30'

DATE JULY 8, 1976