


LOT 8, EXCEPT THE WESTERLY 10 FEET, GLENNWOOD ESTATES SUBDIVISION, BEING PART OF THE SE 1/4 OF THE SE 1/4 OF SECTION 1, TOWNSHIP 1 NORTH, RANGE 16 EAST, OF THE 4TH P.M., VILLAGE OF WILLIAMS BAY, WALWORTH COUNTY, WISCONSIN.

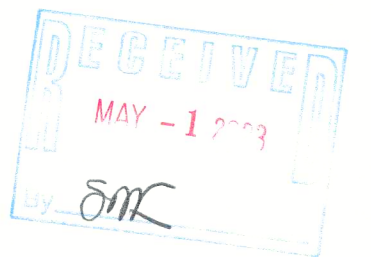

I hereby certify that I have supervised the survey of the property described above and to the best of my knowledge and belief, the plat drawn hereon complies with Chapter A-E 7 of the State of Wisconsin Administrative Code, Minimum Standards for Property Surveys and correctly represents said survey and its location.

Given under my hand and seal this 21st day of April, 2023 at Beloit, Wisconsin.

Last day of field work April 13th, 2023

WISCONSIN
★ ★
KRISTIN J. BELONGIA
S-2943
ELKHORN
WIS.
LAND SURVEYOR

- Existing Transformer
- Existing Electric Meter
- Existing Telephone Pedestal
- Existing Water Valve
- Existing Gas Meter
- Existing Air Conditioner
- Deciduous Tree
- Existing Tree Stump
- Existing Mailbox

