

LOCATION: 22 Lackey Dr, Williams Bay, WI 53191


PREPARED FOR: Michael Baglio

PROPERTY DESCRIPTION:

Lots 53 and 54 Lackey Brothers Subdivision being a part of the NE ¼ of the SE ¼ of Section 1, Township 1, Range 16 East, located in the Village of Williams Bay, Walworth County, Wisconsin.

CURRENT OWNER: Thomas & Colleen M Lamantia

TAX ID: WLB 00052(Lot 53) & WLB 00053(Lot 54)

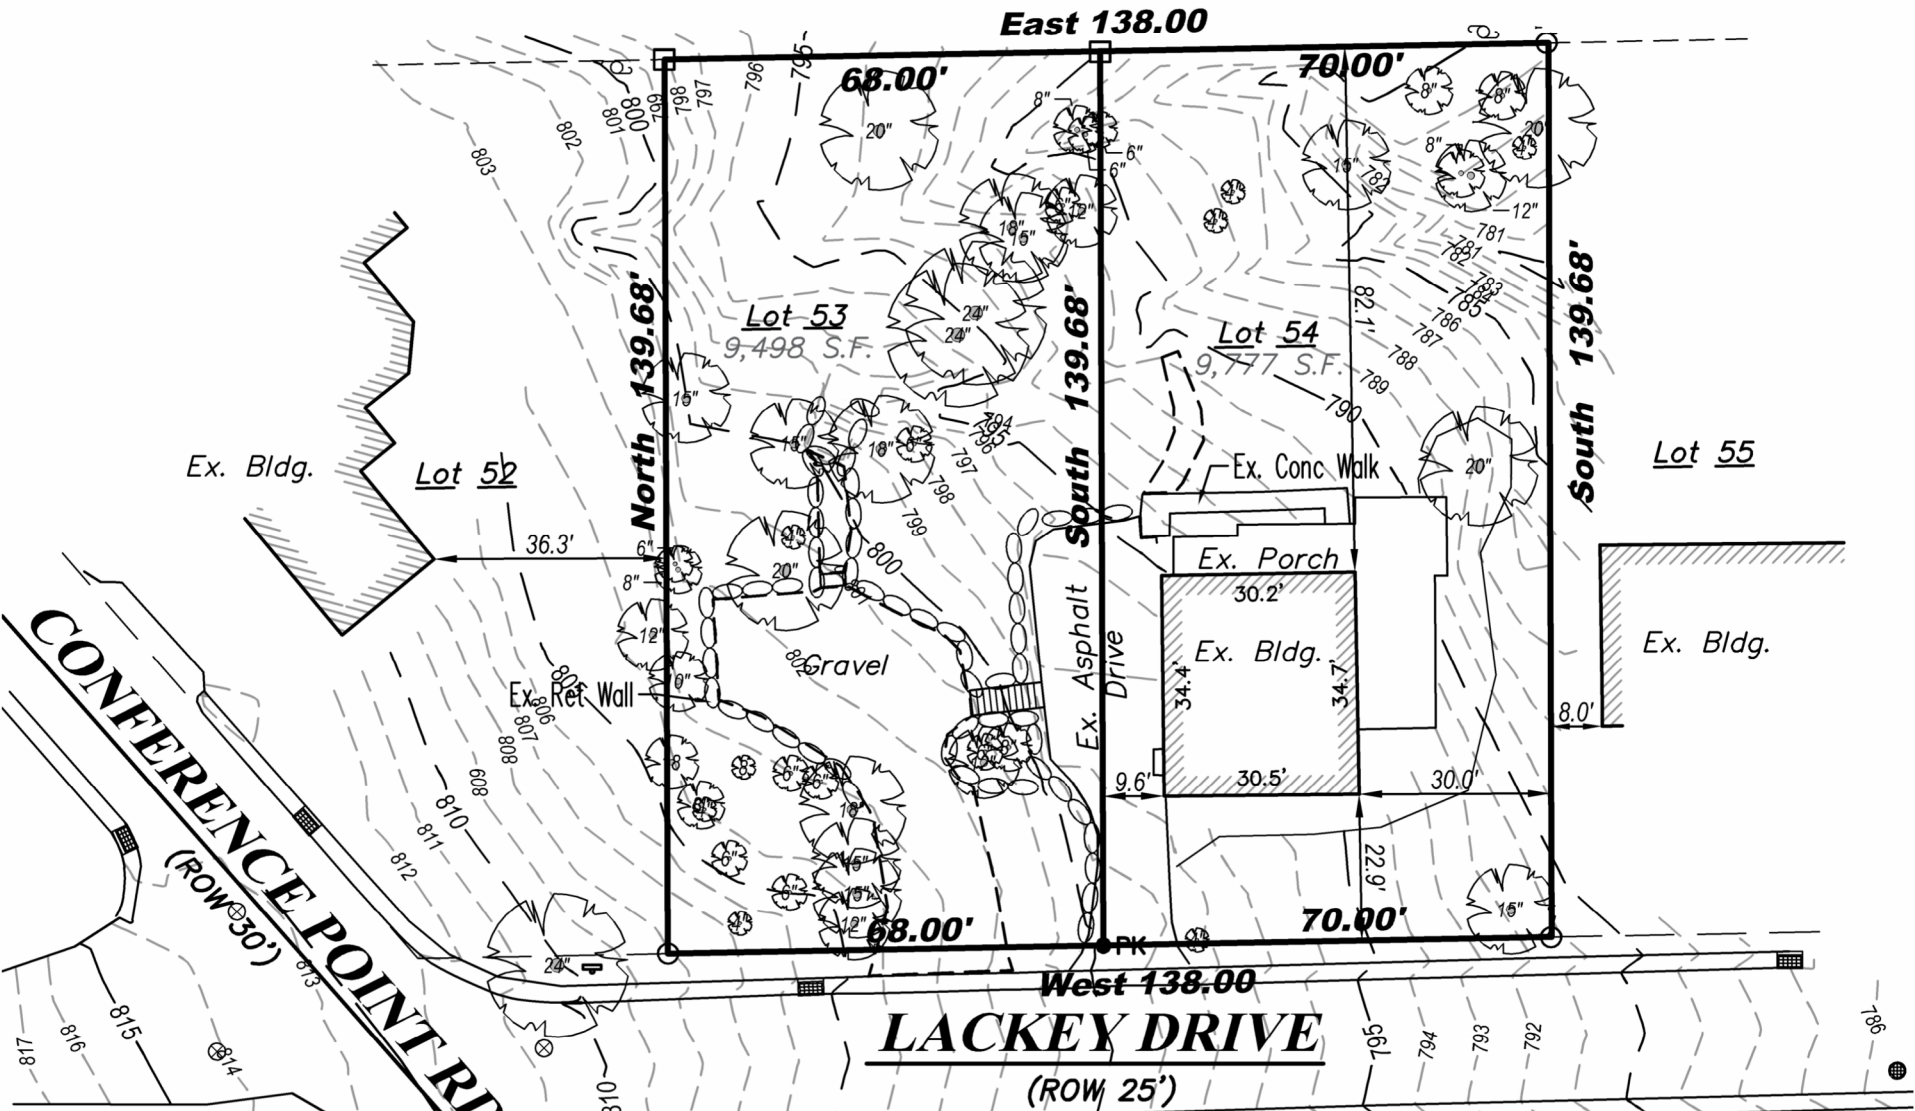


Legend:

- Found Iron Rod
- Found 1" Iron Pipe
- Utility Pole
- Water Main Valve
- Storm Inlet - Curb
- Storm Inlet - Beehive
- Sign
- Deciduous Tree
- Found PK Nail



LYNCH & ASSOCIATES
ENGINEERING CONSULTANTS, LLC

5482 S. WESTRIDGE DRIVE
NEW BERLIN, WI 53151
440 MILWAUKEE AVENUE
BURLINGTON, WI 53105
(262) 402-5040

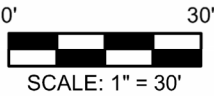

I certify that I have surveyed the above-described property and in my professional opinion this map is a true representation thereof and is made in accordance with the records of the register of deeds as nearly as practical and that this survey complies with Wisconsin Administrative code AE-7 except for those items waived, if any, and is bound by Wisconsin State Statute 893.37 that defines statute of limitations in regard to surveys. This survey was prepared for the exclusive use of the client and present owners of the property.

No title policy has been provided to the surveyor regarding the property identified on this map. Therefore this plat of survey does not guarantee the existence, size and location of any easements, encumbrances, restrictions or other facts that could otherwise be disclosed in an ALTA/NSPS survey.

Rick R. Hillmann, Professional Land Surveyor, S-3005

DRAWING BY:
FIELD WORK BY: