


FARRIS, HANSEN & ASSOCIATES, INC.

ENGINEERING — ARCHITECTURE — SURVEYING
7 RIDGWAY COURT — P.O. BOX 437 — ELKHORN, WISCONSIN 53121
PHONE: (262) 723-2098 e-mail: office@farrishansen.com

PLAT OF SURVEY—BOUNDARY DETERMINATION VS FENCE LOCATION

LOT 104 OF LAKEWOOD TRAILS NORTH SUBDIVISION
LOCATED IN PART OF THE NW 1/4 OF THE NW 1/4 OF SECTION 1, TOWN 1 NORTH,
RANGE 16 EAST, VILLAGE OF WILLIAMS BAY, WALWORTH COUNTY, WISCONSIN

— WORK ORDERED BY —
LAKEWOOD TRAILS HOMEOWNERS ASSOC.
P.O. BOX 441
WILLIAMS BAY, WI 53191

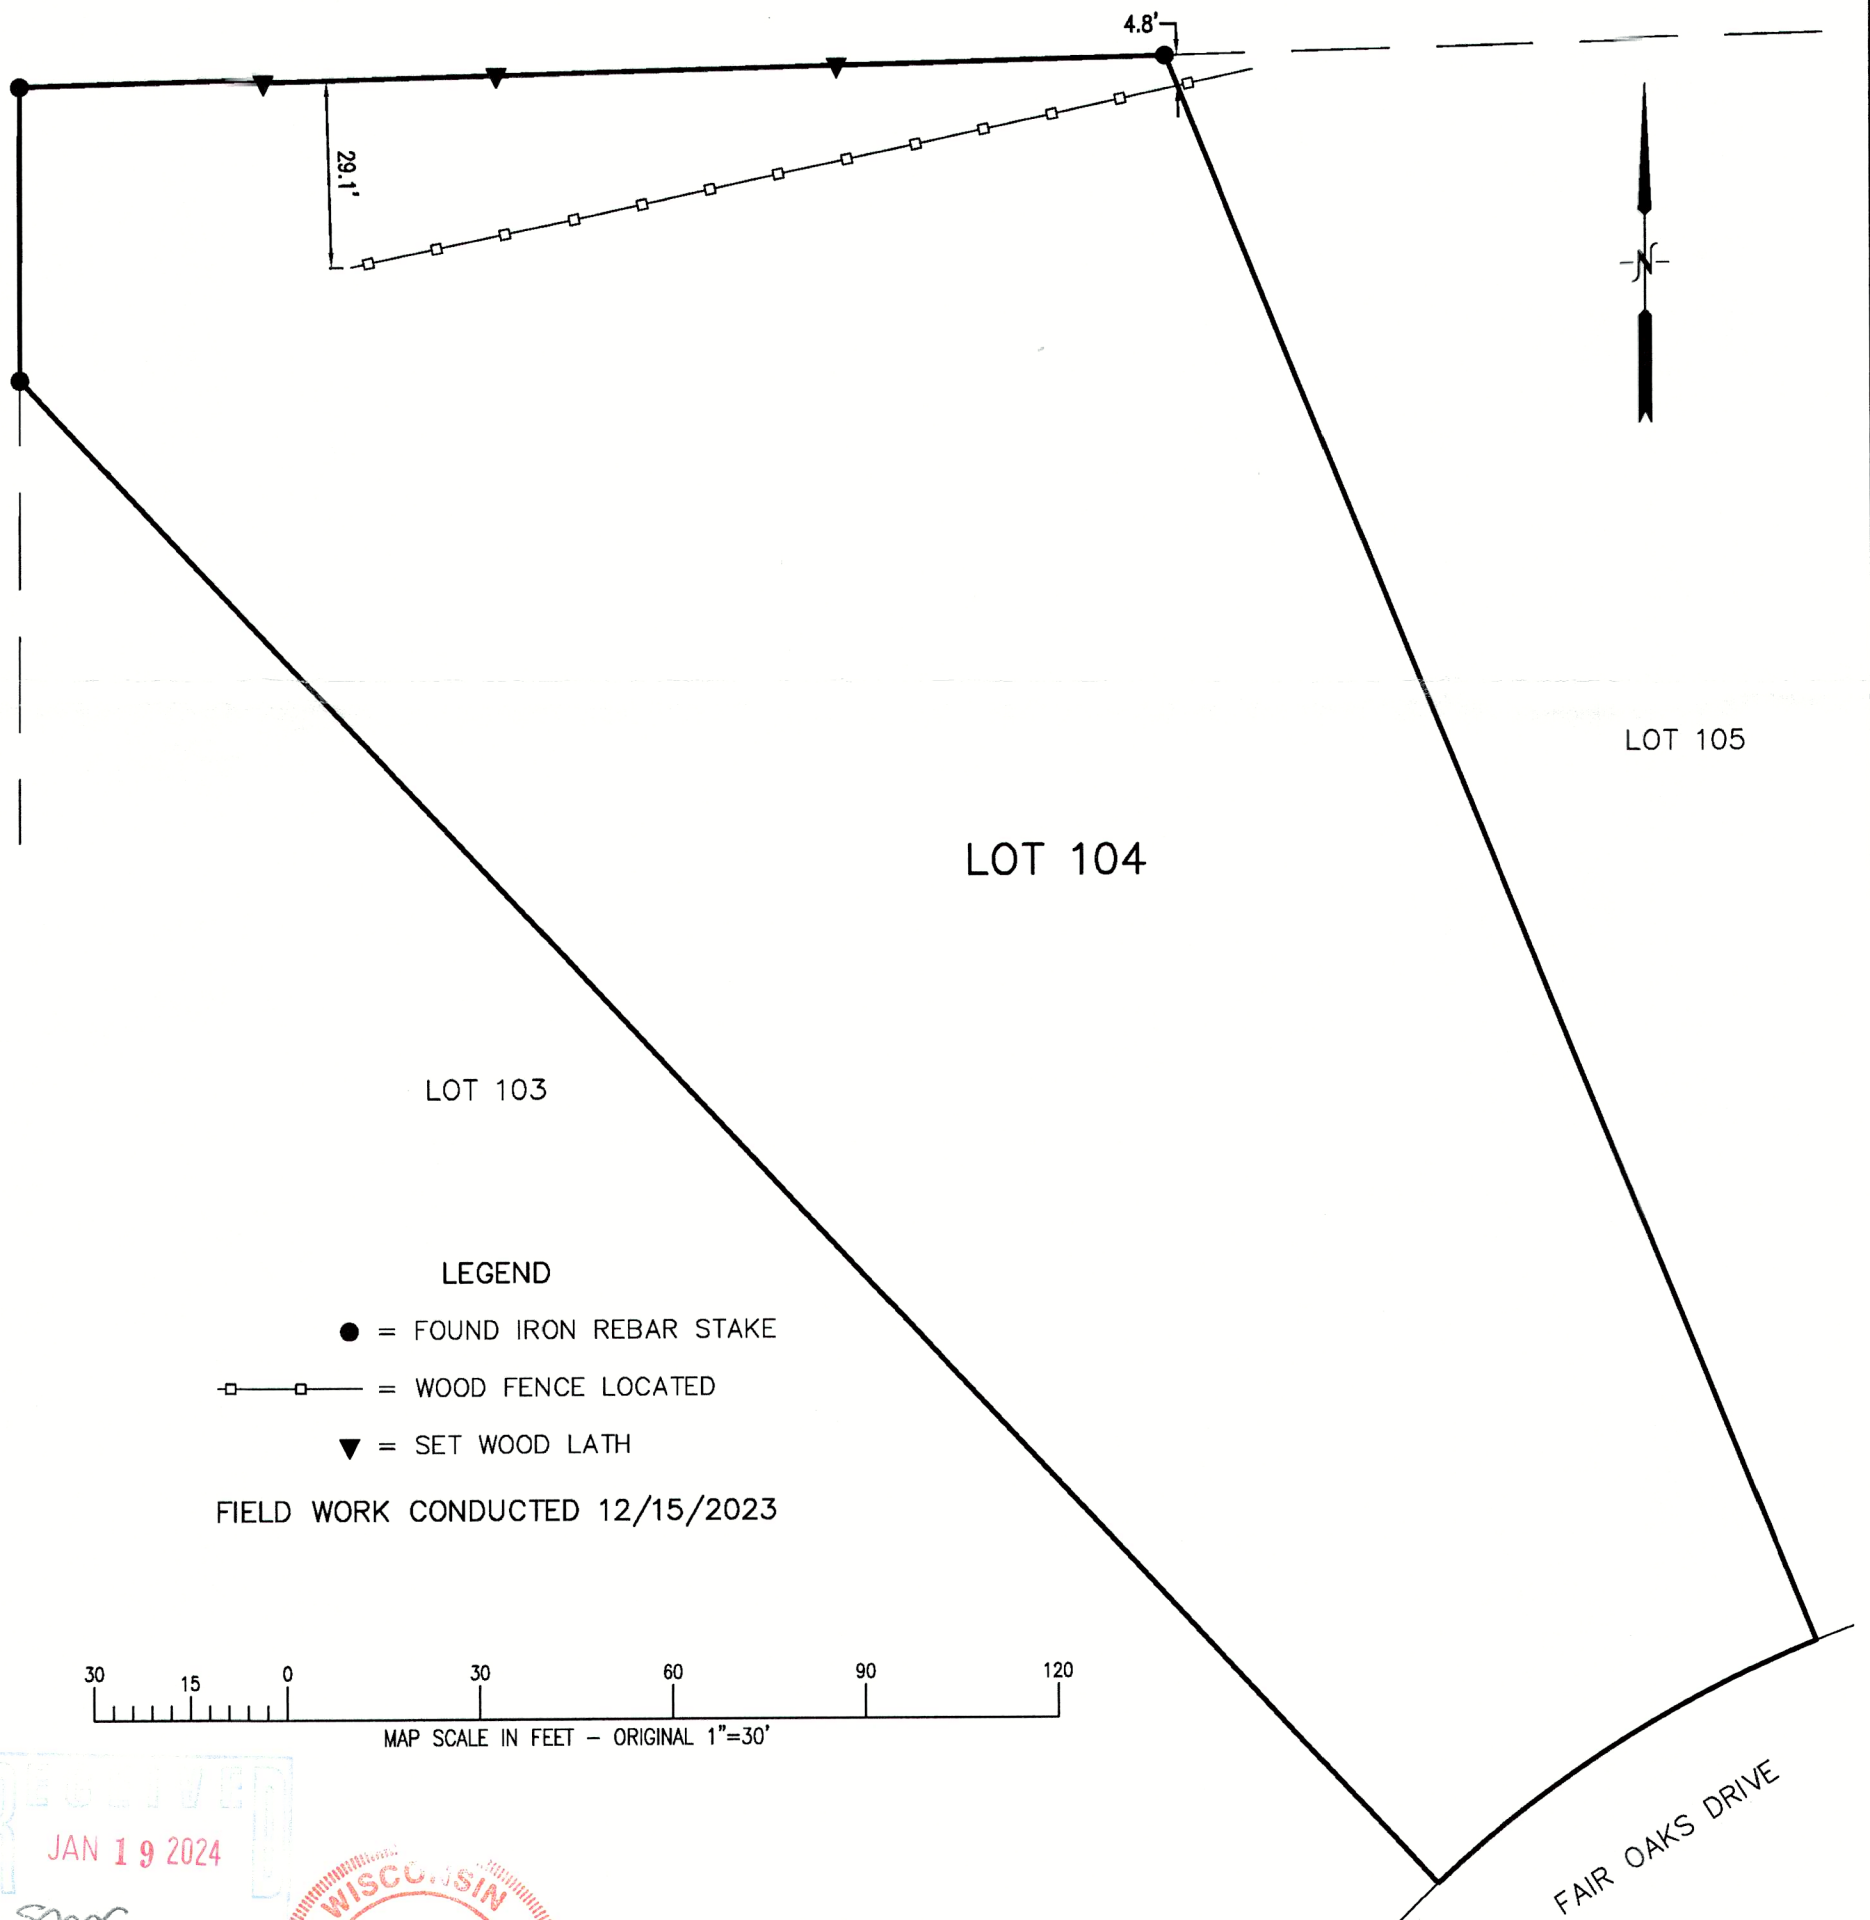


LEGEND

- = FOUND IRON REBAR STAKE
- = WOOD FENCE LOCATED
- ▼ = SET WOOD LATH

FIELD WORK CONDUCTED 12/15/2023

30 15 0 30 60 90 120
MAP SCALE IN FEET — ORIGINAL 1"=30'

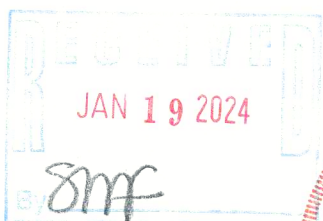

DATED: 1/17/2024

Christopher A. Hodges
CHRISTOPHER A. HODGES P.L.S. 2760

PROJECT: 3836.01.104.23
DATE: 01/04/2024
SHEET: 1 OF 1

WLAKN-4

011-3243