


LOCATION: 38 Oak Birch Dr Williams Bay , Wisconsin
PREPARED FOR: David G. and Margaret M. Cambria
PROPERTY DESCRIPTION: Per Document No. 1014467
Lot 2 of the plat of first addition to Cedar Point Park,
Village of Williams Bay, Walworth County, Wisconsin.
CURRENT OWNER: David Kenzer
TAX ID: WCP1 0002

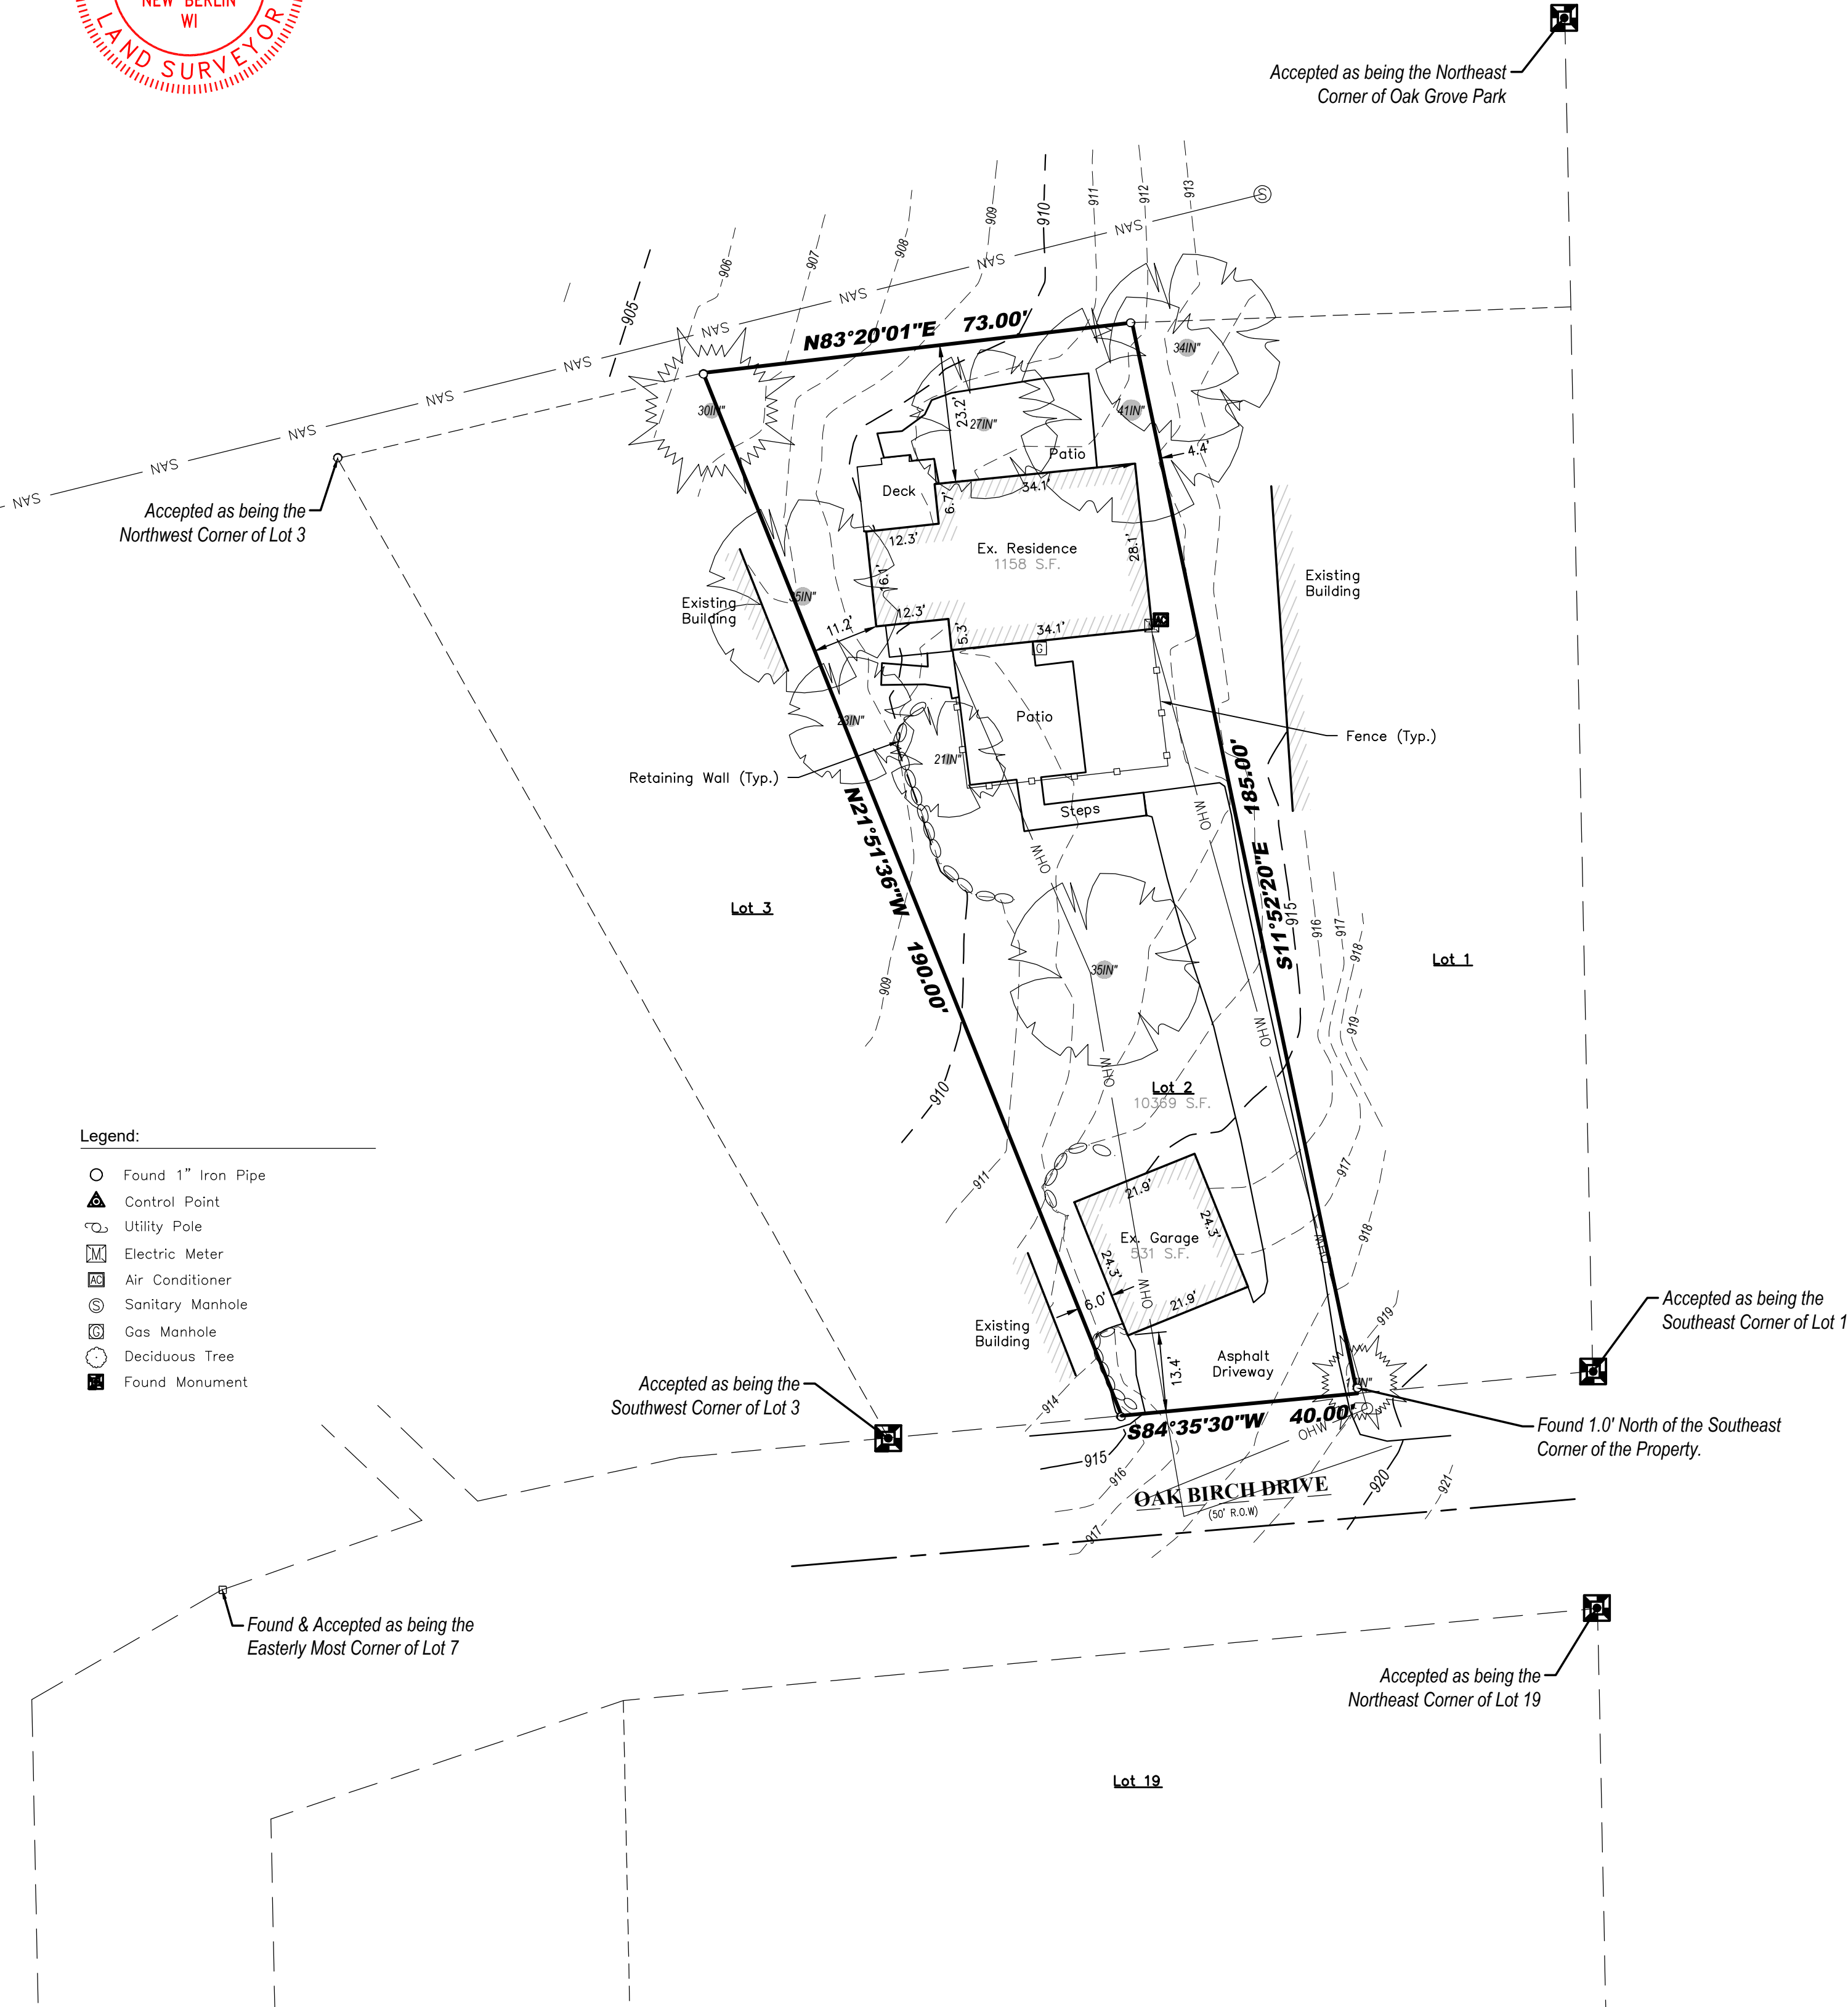


Legend:

- Found 1" Iron Pipe
- ▲ Control Point
- Utility Pole
- Ⓜ Electric Meter
- Ⓐ Air Conditioner
- Ⓢ Sanitary Manhole
- Ⓒ Gas Manhole
- Deciduous Tree
- Found Monument

I certify that I have surveyed the above-described property and in my professional opinion this map is a true representation thereof and is made in accordance with the records of the register of deeds as nearly as practical and that this survey complies with Wisconsin Administrative code AE-7 except for those items waived, if any, and is bound by Wisconsin State Statute 893.37 that defines statute of limitations in regard to surveys. This survey was prepared for the exclusive use of the client and present owners of the property.

No title policy has been provided to the surveyor regarding the property identified on this map. Therefore this plat of survey does not guarantee the existence, size and location of any easements, encumbrances, restrictions or other facts that could otherwise be disclosed in an ALTA/NSPS survey.

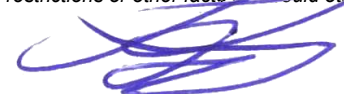
Rick R. Hillmann, Professional Land Surveyor, S-3005

DRAWING BY: MRO
FIELD WORK BY: LG