

# Plat of Survey


of

## **Lot 107 of Cedar Point Park.**

a subdivision recorded October 4, 1926 in Vol. 8 of Plats of Walworth County on Page 101 as Document Number 259206 and located in Government Lot 2 in the Southeast 1/4 of Section 6, Town 1 North, Range 17 East, Village of Williams Bay Walworth County, Wisconsin.

Surveyed for: **Michael Palermo**

294 Anthony Street  
Glen Ellyn, Illinois. 6013

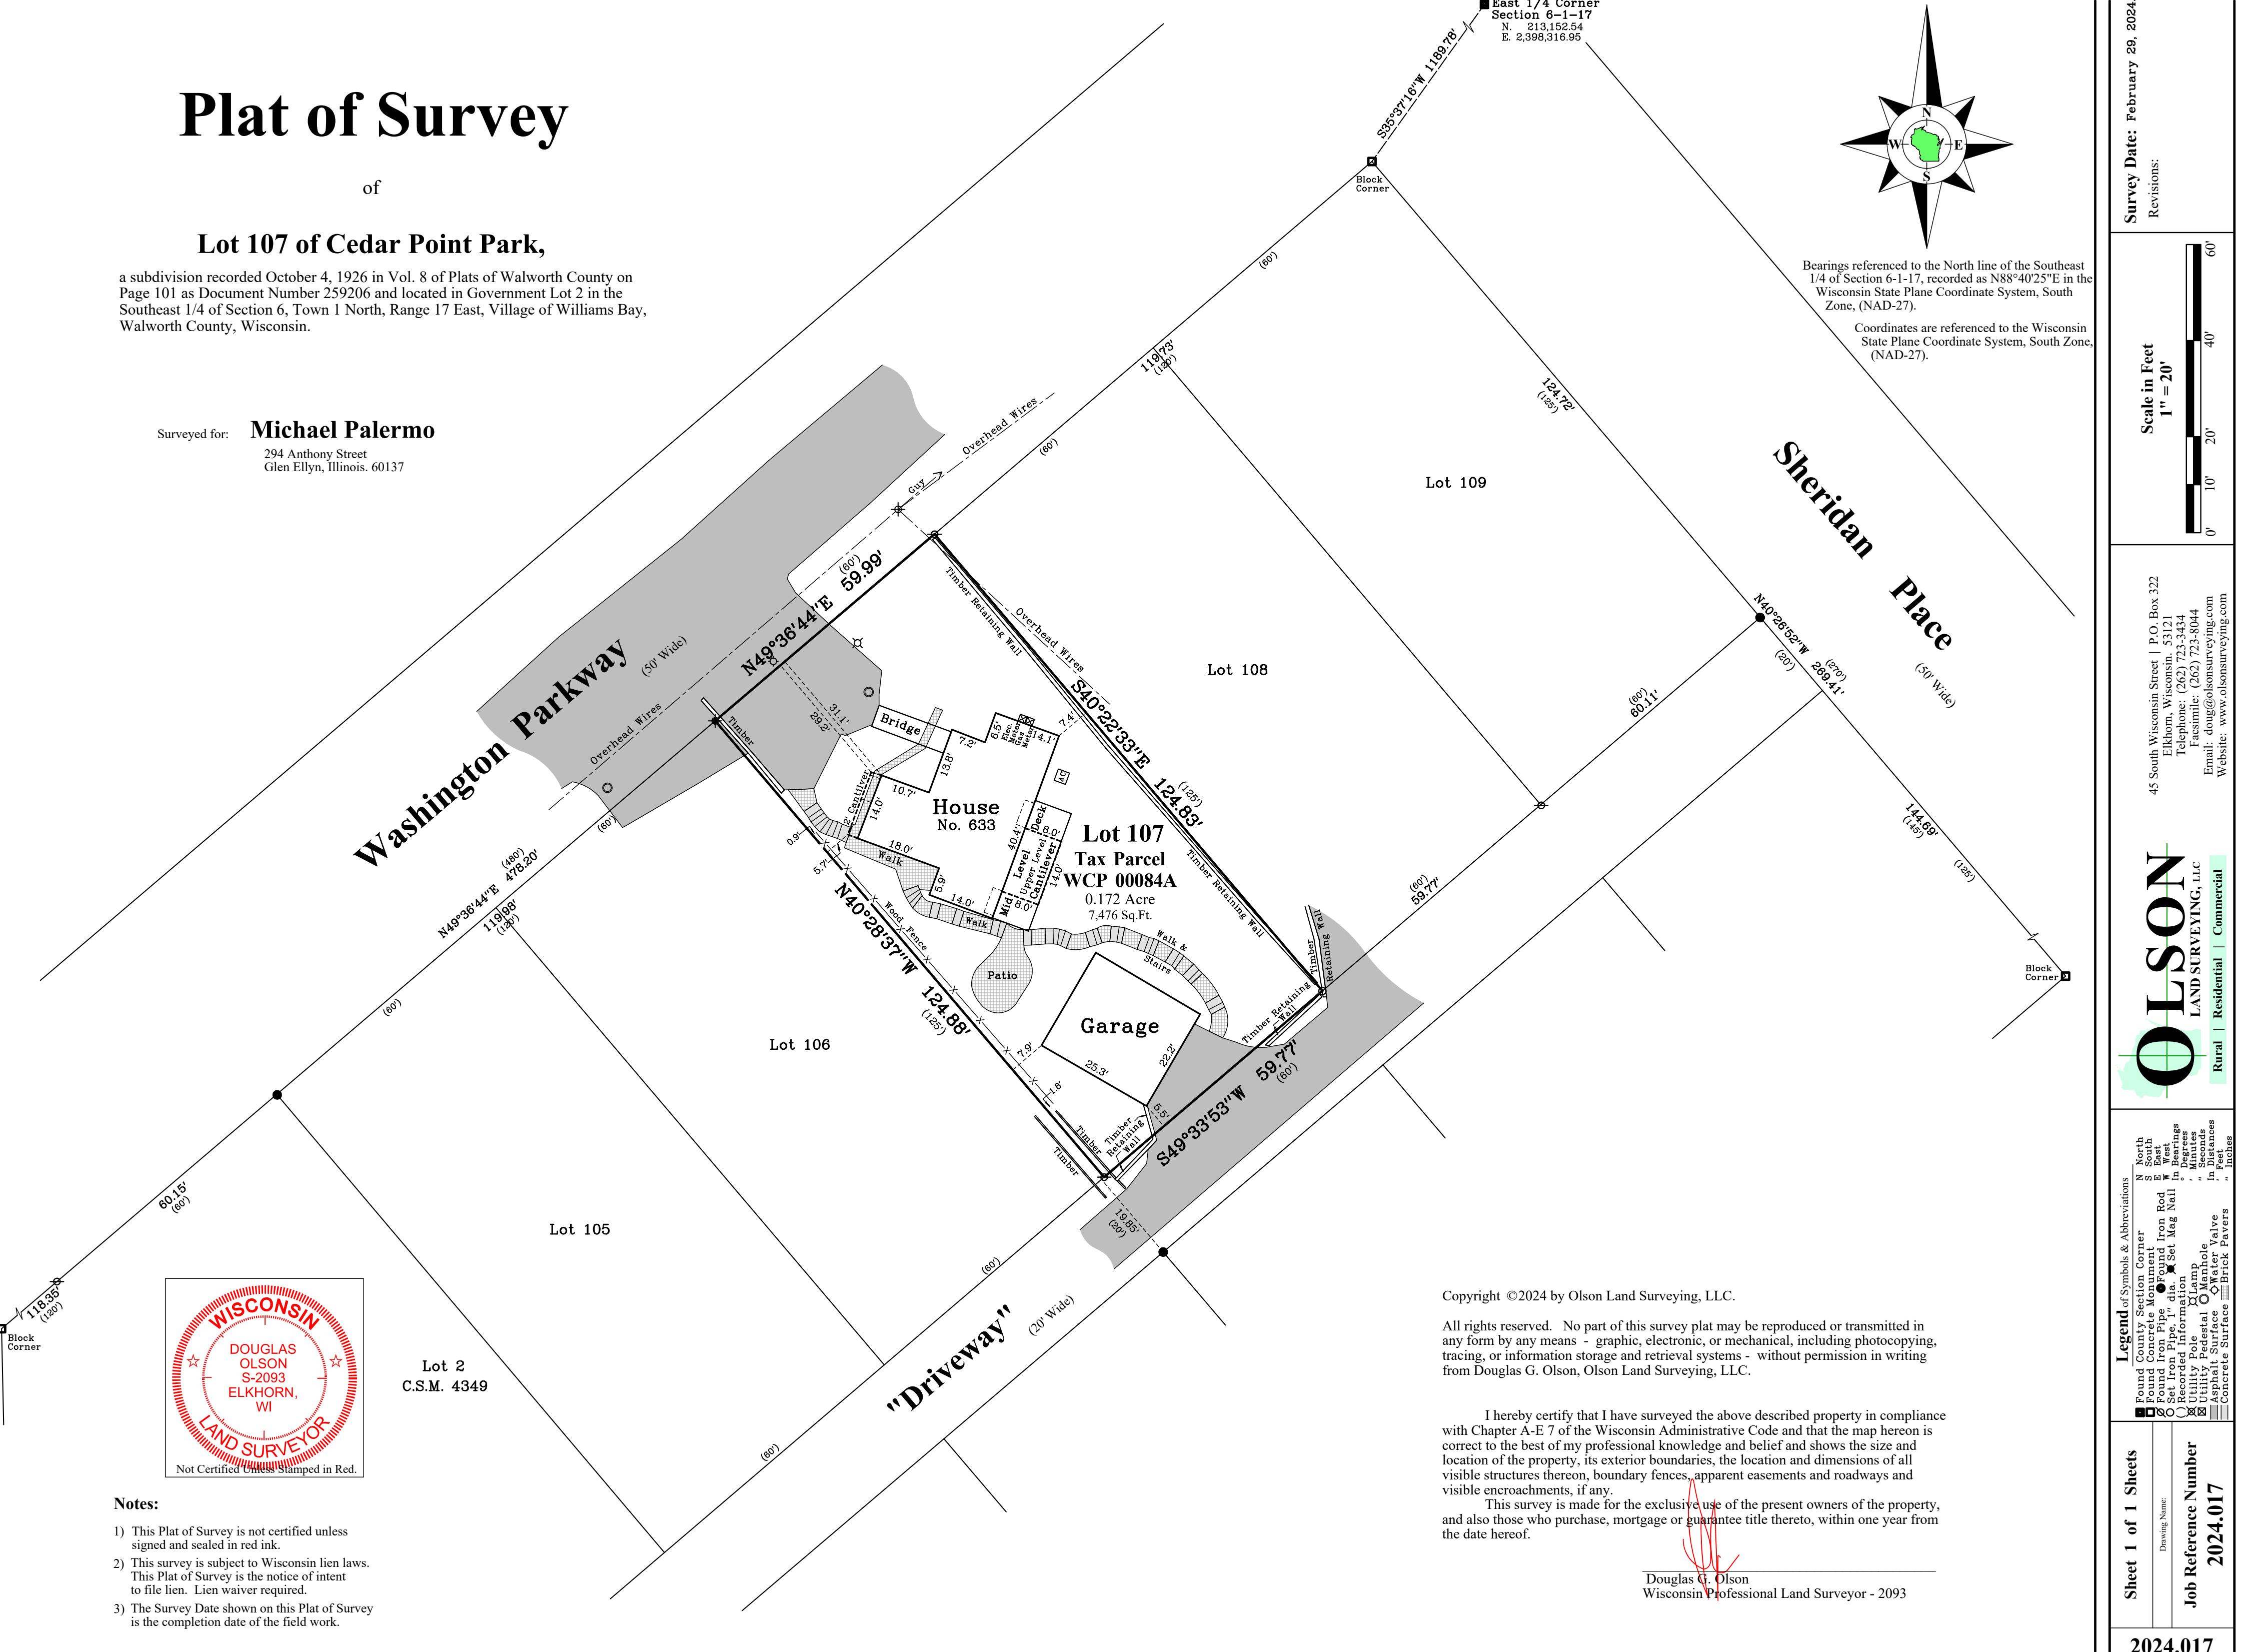

## Notes:

- 1) This Plat of Survey is not certified unless signed and sealed in red ink.
- 2) This survey is subject to Wisconsin lien laws. This Plat of Survey is the notice of intent to file lien. Lien waiver required.
- 3) The Survey Date shown on this Plat of Survey is the completion date of the field work.


Copyright ©2024 by Olson Land Surveying, LLC.

All rights reserved. No part of this survey plat may be reproduced or transmitted in any form by any means - graphic, electronic, or mechanical, including photocopying, tracing, or information storage and retrieval systems - without permission in writing from Douglas G. Olson, Olson Land Surveying, LLC.

I hereby certify that I have surveyed the above described property in compliance with Chapter A-E 7 of the Wisconsin Administrative Code and that the map hereon is correct to the best of my professional knowledge and belief and shows the size and location of the property, its exterior boundaries, the location and dimensions of all visible structures thereon, boundary fences, apparent easements and roadways and visible encroachments, if any.

This survey is made for the exclusive use of the present owners of the property, and also those who purchase, mortgage or guarantee title thereto, within one year from the date hereof.

Douglas G. Olson  
Wisconsin Professional Land Surveyor - 2093

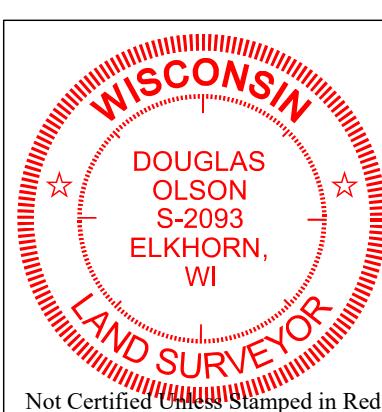

Lot 2  
C.S.M. 434

1) This Plat of Survey is not certified unless

signed and sealed in red ink.

to file lien. Lien waiver required.

The logo for Olson Land Surveying, LLC is positioned on the left side of the page. It features a green silhouette of the state of Minnesota. Overlaid on the map is a large, bold, black 'O' at the bottom, with the word 'OLSON' stacked vertically in large, bold, black capital letters above it. To the right of the 'OLSON' text, the words 'LAND SURVEYING, LLC' are written in a smaller, black, sans-serif font. A thin green vertical line runs through the center of the 'O' and the 'OLSON' text.

Legend of Symbols & Abbreviations	
Found	County
Section	Corner
Concrete	Monument
Iron Pipe	Found Iron Rod
Set Iron Pipe, 1"	Set Mag Nail
) Recorded Information	
Utility Pole	Lamp
Utility Pedestal	Manhole
Asphalt Surface	Water Valve
Concrete Surface	Brick Pavers
	N North
	S South
	E East
	W West
	o Bearings
	o Degrees
	" Minutes
	" Seconds
	In Distances
	feet
	" inches

**Sheet 1 of 1 Sheets** Drawing Name: \_\_\_\_\_

2024.01