



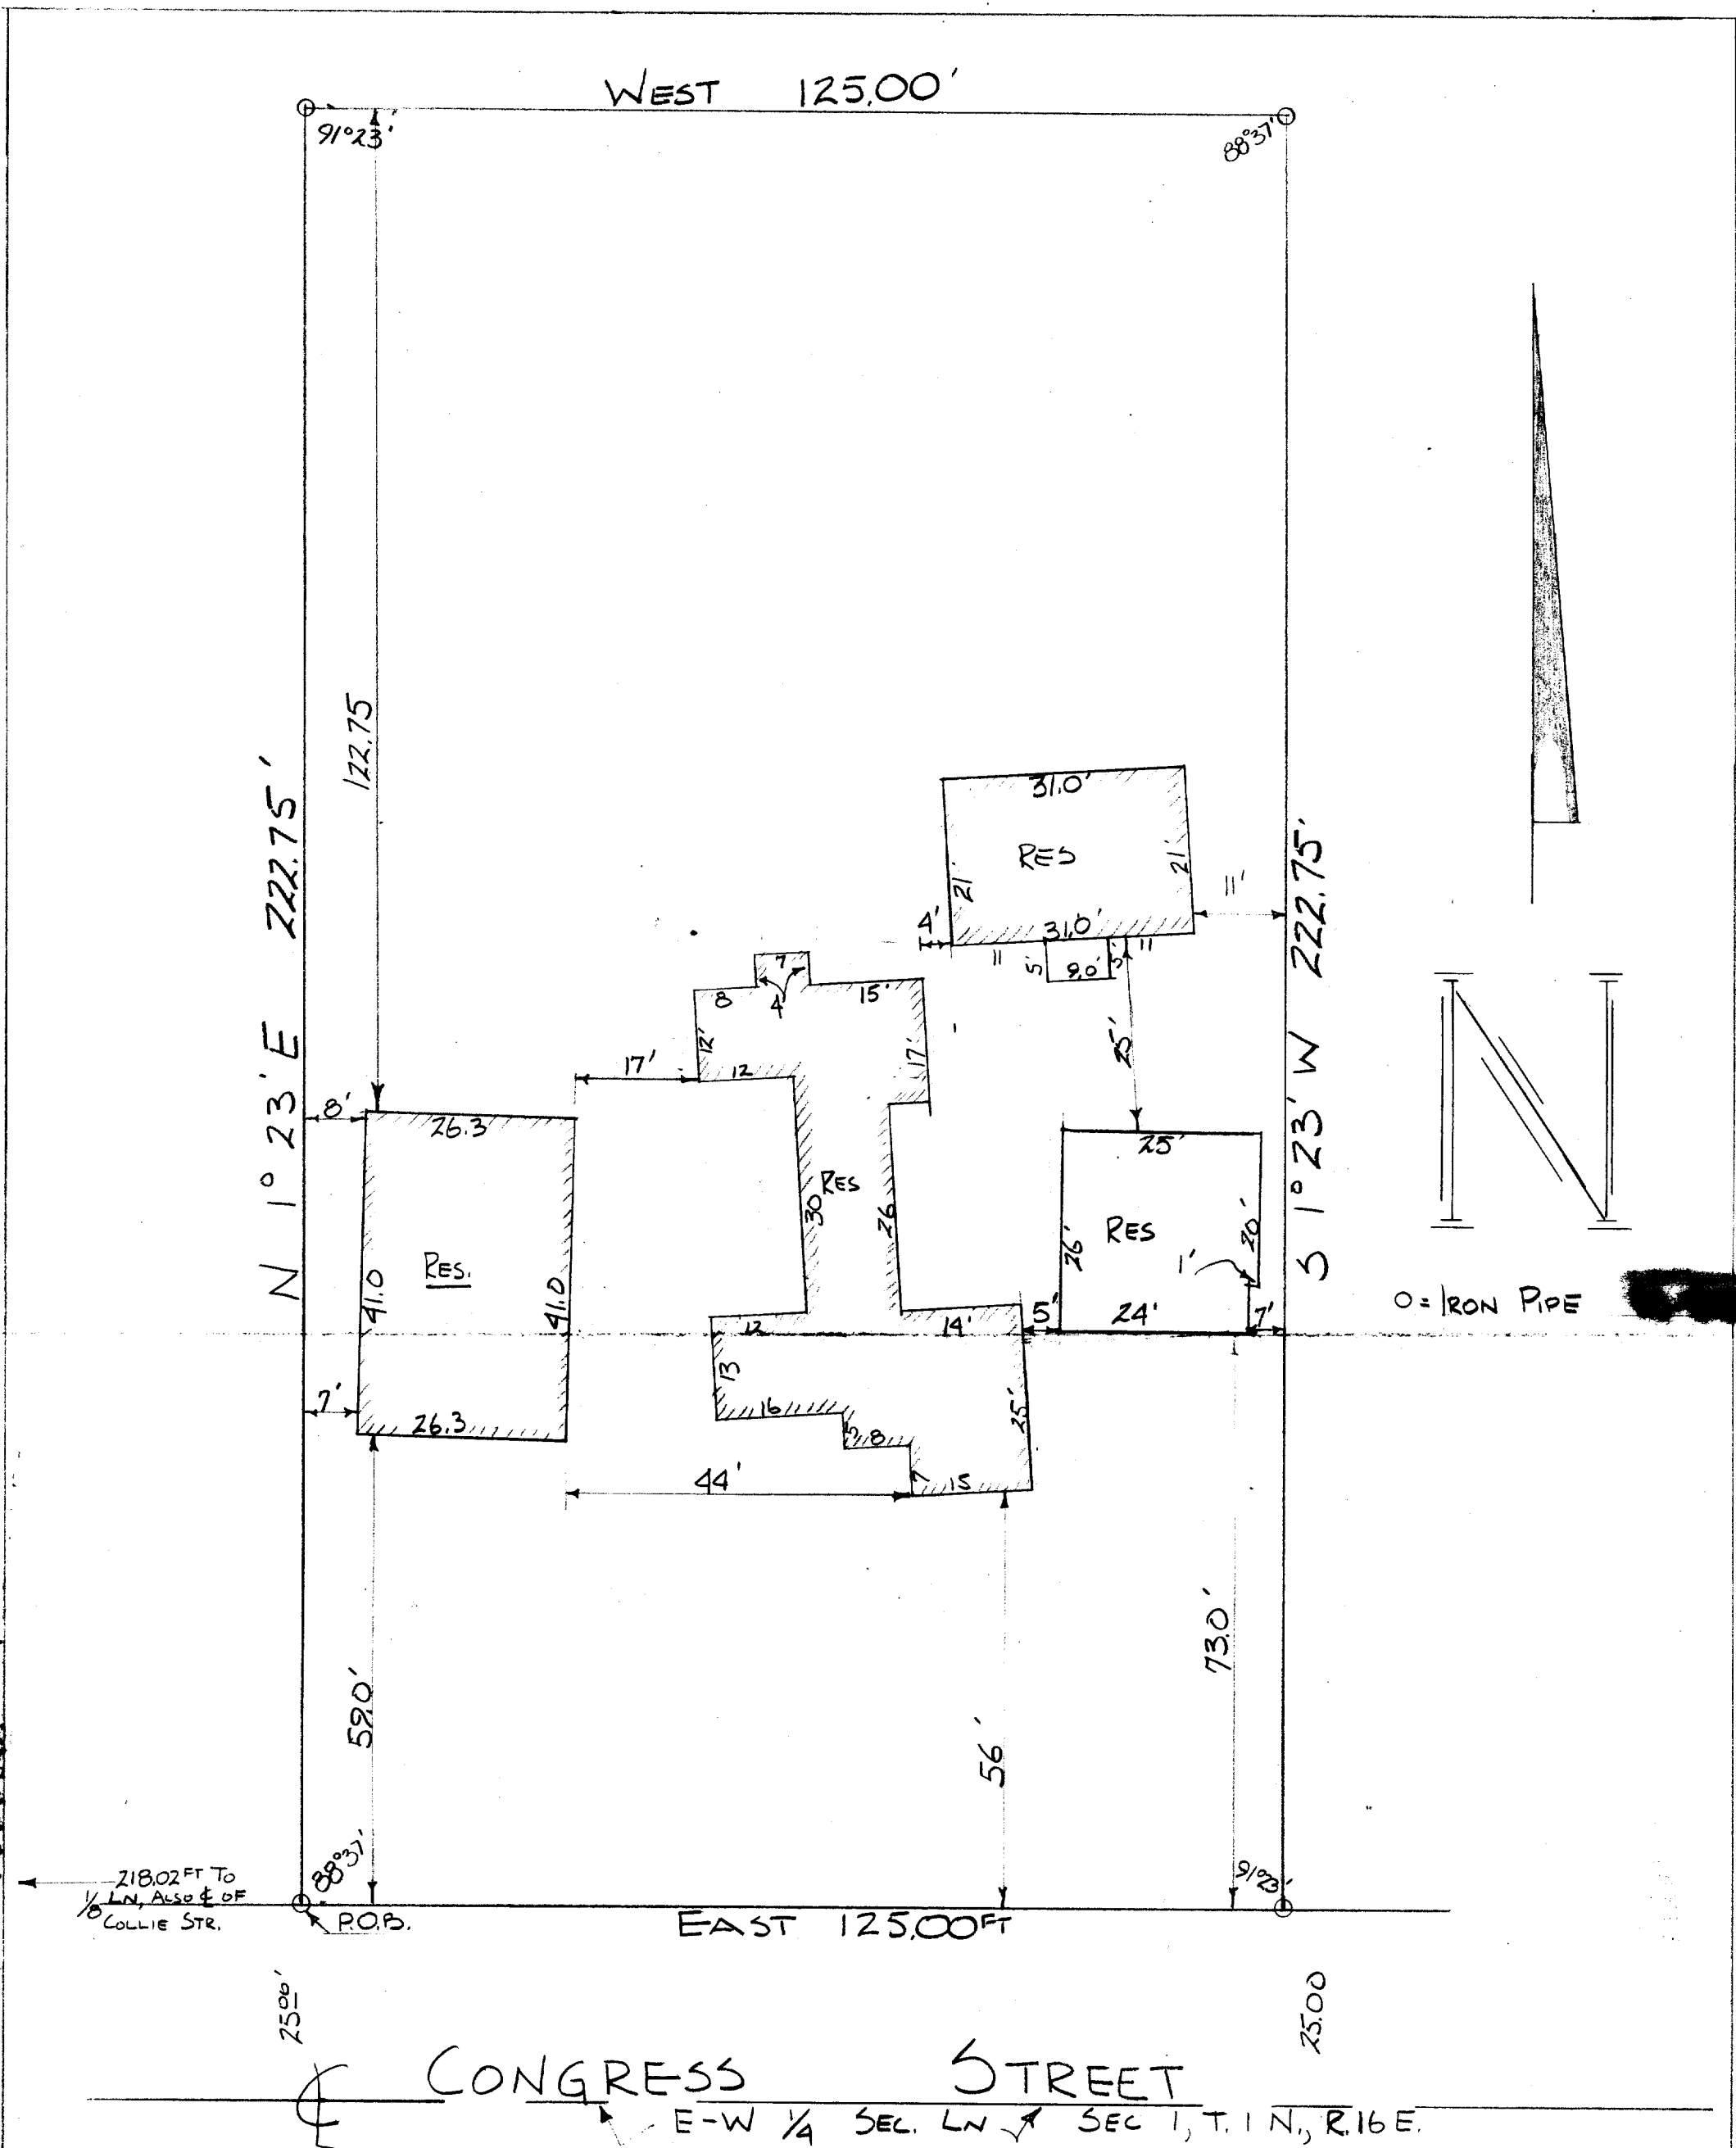

DESCRIPTION: Commencing at a point that is 25.00 feet N. 1° 23' E. of and 218.02 feet East of the SW corner of the West 1/4 of the NW 1/4 of Fractional Section 1, T. 1 N., R. 16 E. Village of Williams Bay, Wisconsin; thence East 125.00 feet to an iron stake, thence S 1° 23' E. 222.75 feet to an iron stake, thence West 125.00 feet to an iron stake, thence S 1° 23' E. 222.75 feet to the place of beginning.

CERTIFICATE: I, James F. Biagi, surveyor do hereby certify that I have surveyed the property herein described, and that the location of the improvements are as shown on the drawing above.

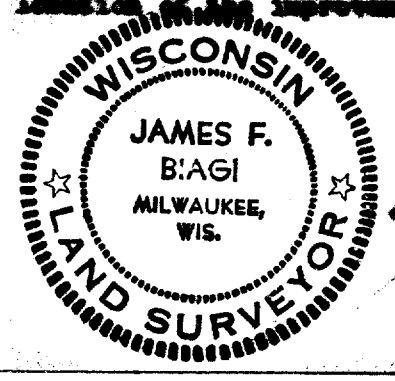

*[Handwritten signature of James F. Biagi]*