


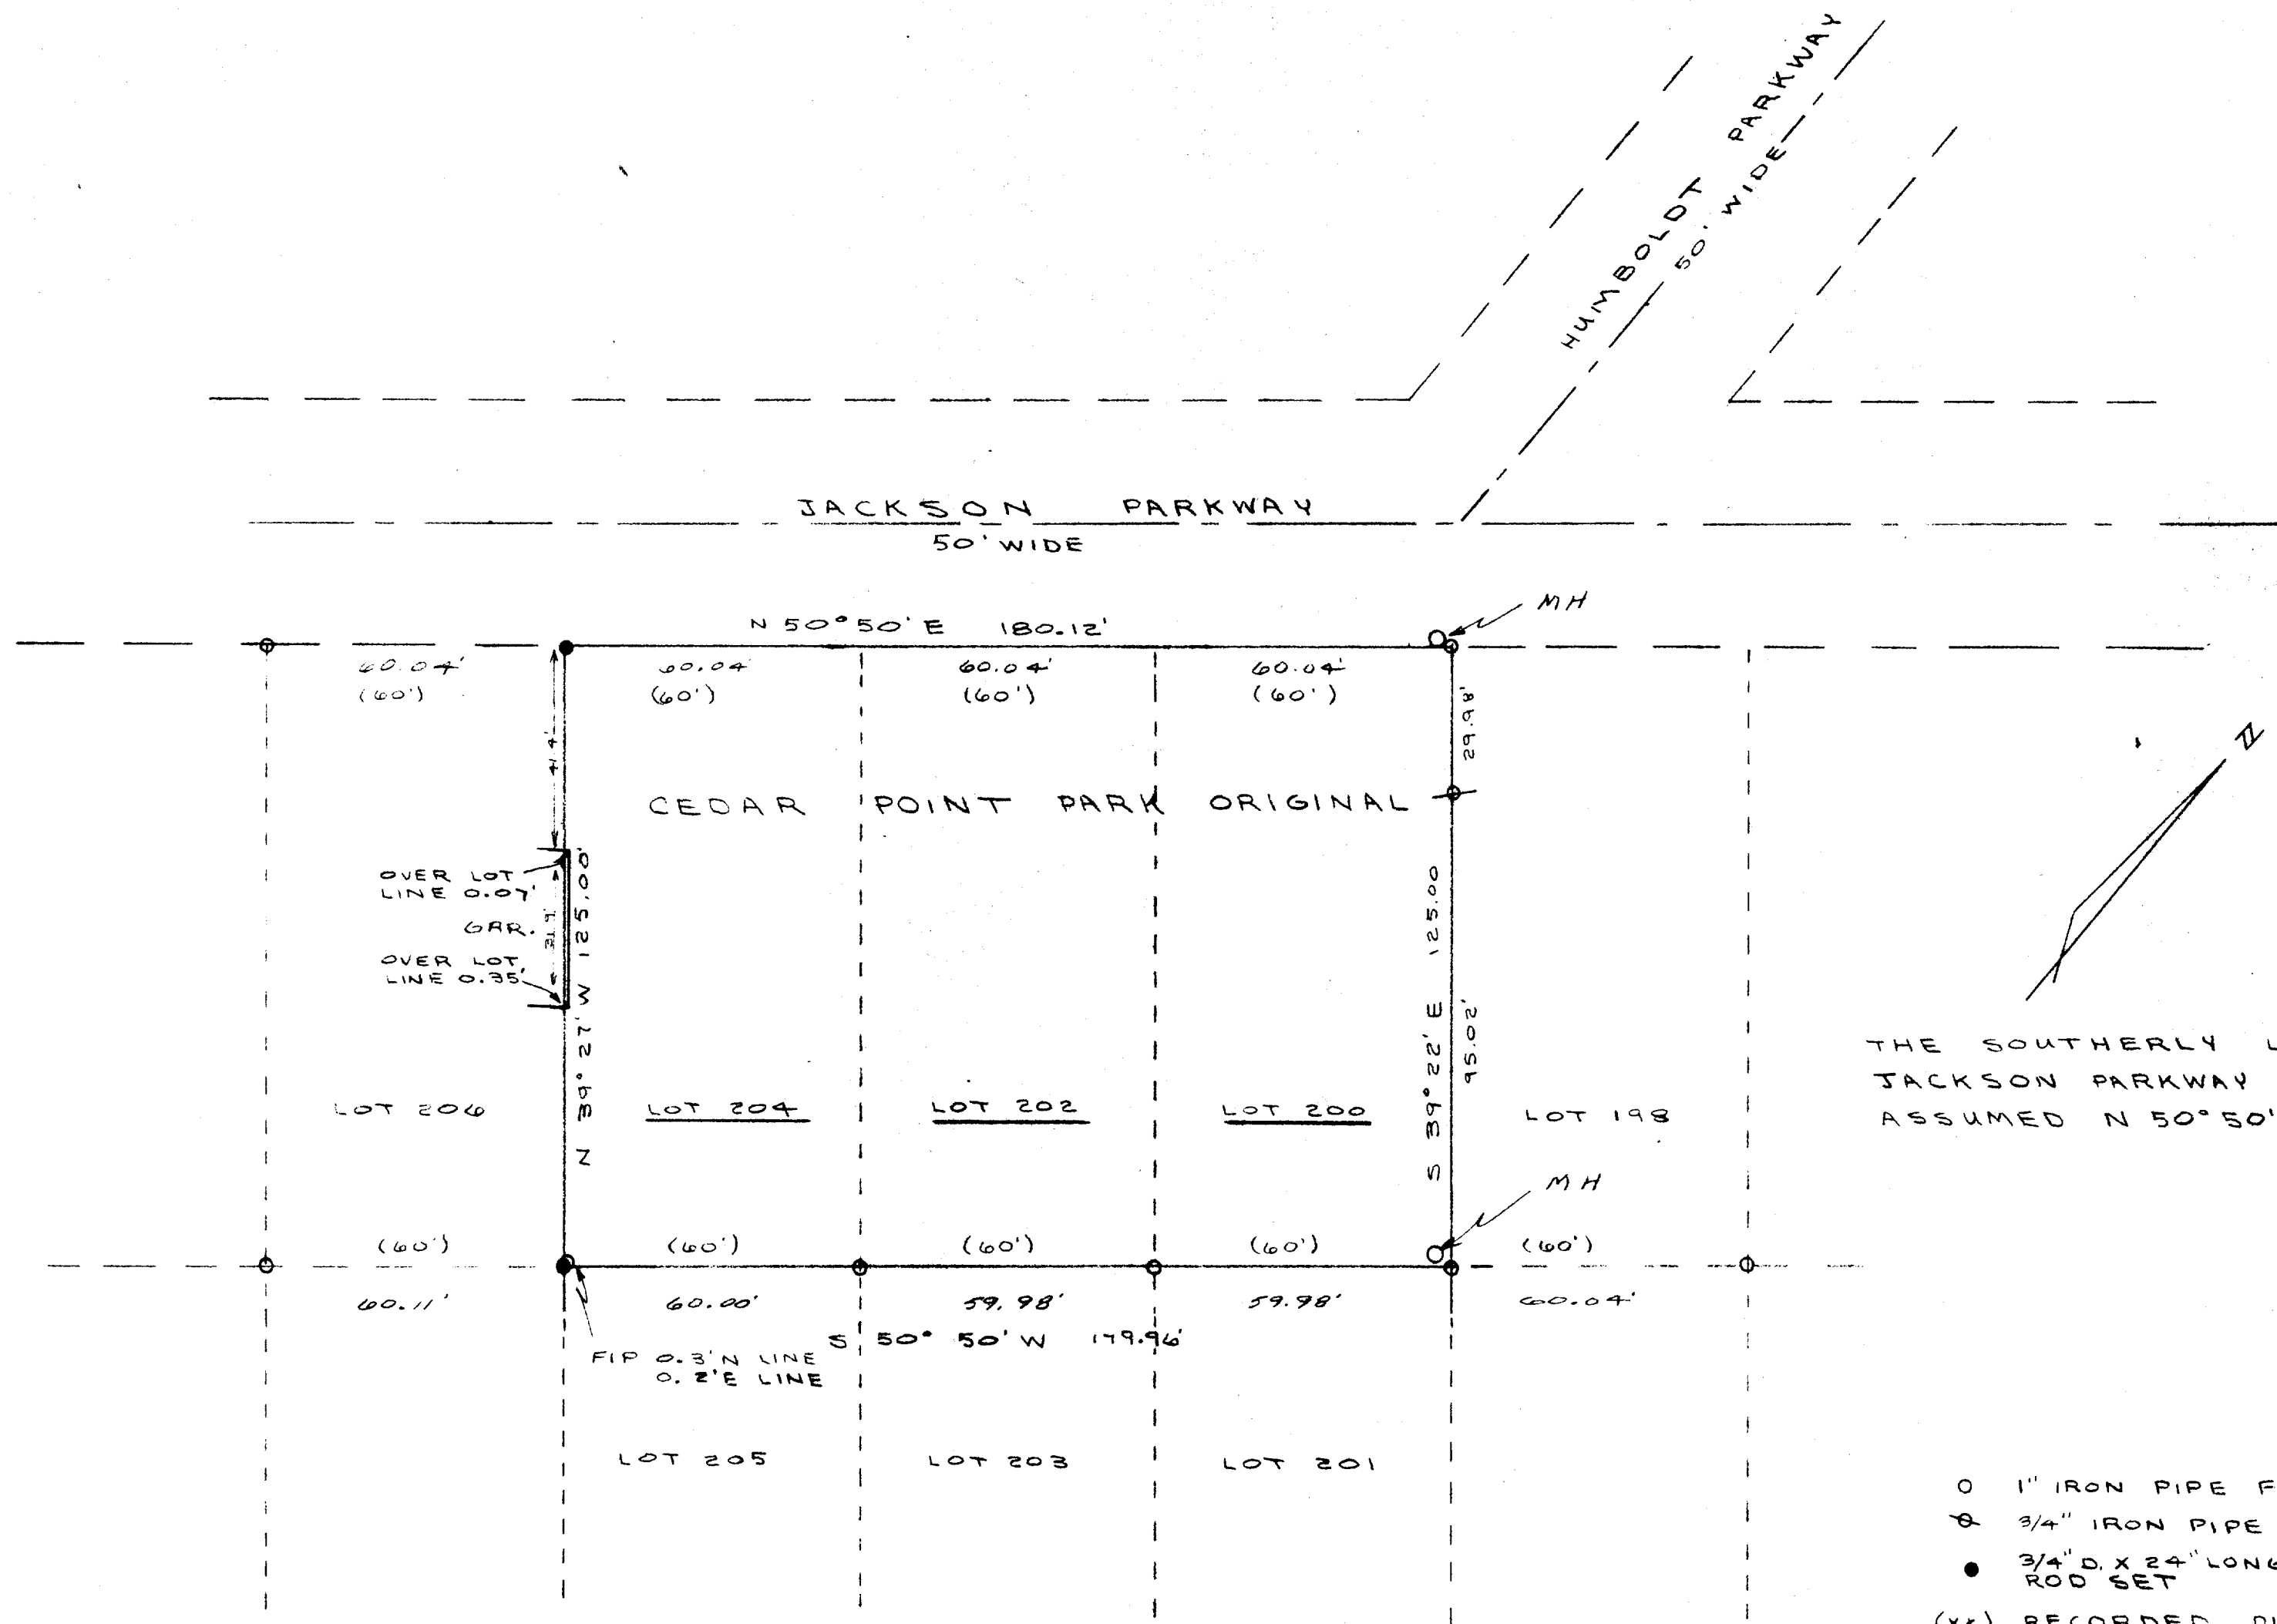


NOTE: THE LOCATION OF THE MANHOLE ON LOT 200 INDICATES THAT THERE MAY BE AN EASEMENT ALONG THE EASTERLY SIDE OF THE LOT

SURVEYED FOR CLIFF SPEARE
1520 HAWTHORN PLACE
DEARFIELD, ILL 60015

THE PROPERTY HEREON DESCRIBED HAS BEEN SURVEYED UNDER MY DIRECTION AND THE ABOVE MAP IS A TRUE REPRESENTATION THEREOF TO THE BEST OF MY KNOWLEDGE AND BELIEF

DATED THIS 14TH DAY OF MAY 1977

Thomas P. A. Jensen
THOMAS P. A. JENSEN
REGISTERED LAND SURVEYOR NO. S-1084

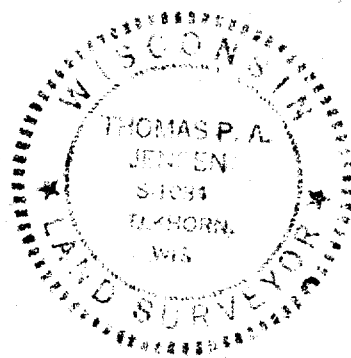

PLAT OF SURVEY OF

LOT S 200, 202 AND 204 CEDAR POINT PARK ORIGINAL, LOCATED IN SEC 6, T1N, R1E, WILLIAMS BAY, WALWORTH COUNTY WIS.

SCALE 1" = 30'

DATE May 17, 1977

Thomas P. A. Jensen
SURVEYOR

#1658.070