


# PLAT OF SURVEY

OF LOT 93 OF BAYWOOD HEIGHTS ADDITION NO. 2,  
BEING PART OF THE NW 1/4 OF THE NW 1/4 OF SECTION 1, T. 1 N., R. 16 E., OF THE 4TH P.M.,  
VILLAGE OF WILLIAMS BAY, WALWORTH COUNTY, WISCONSIN

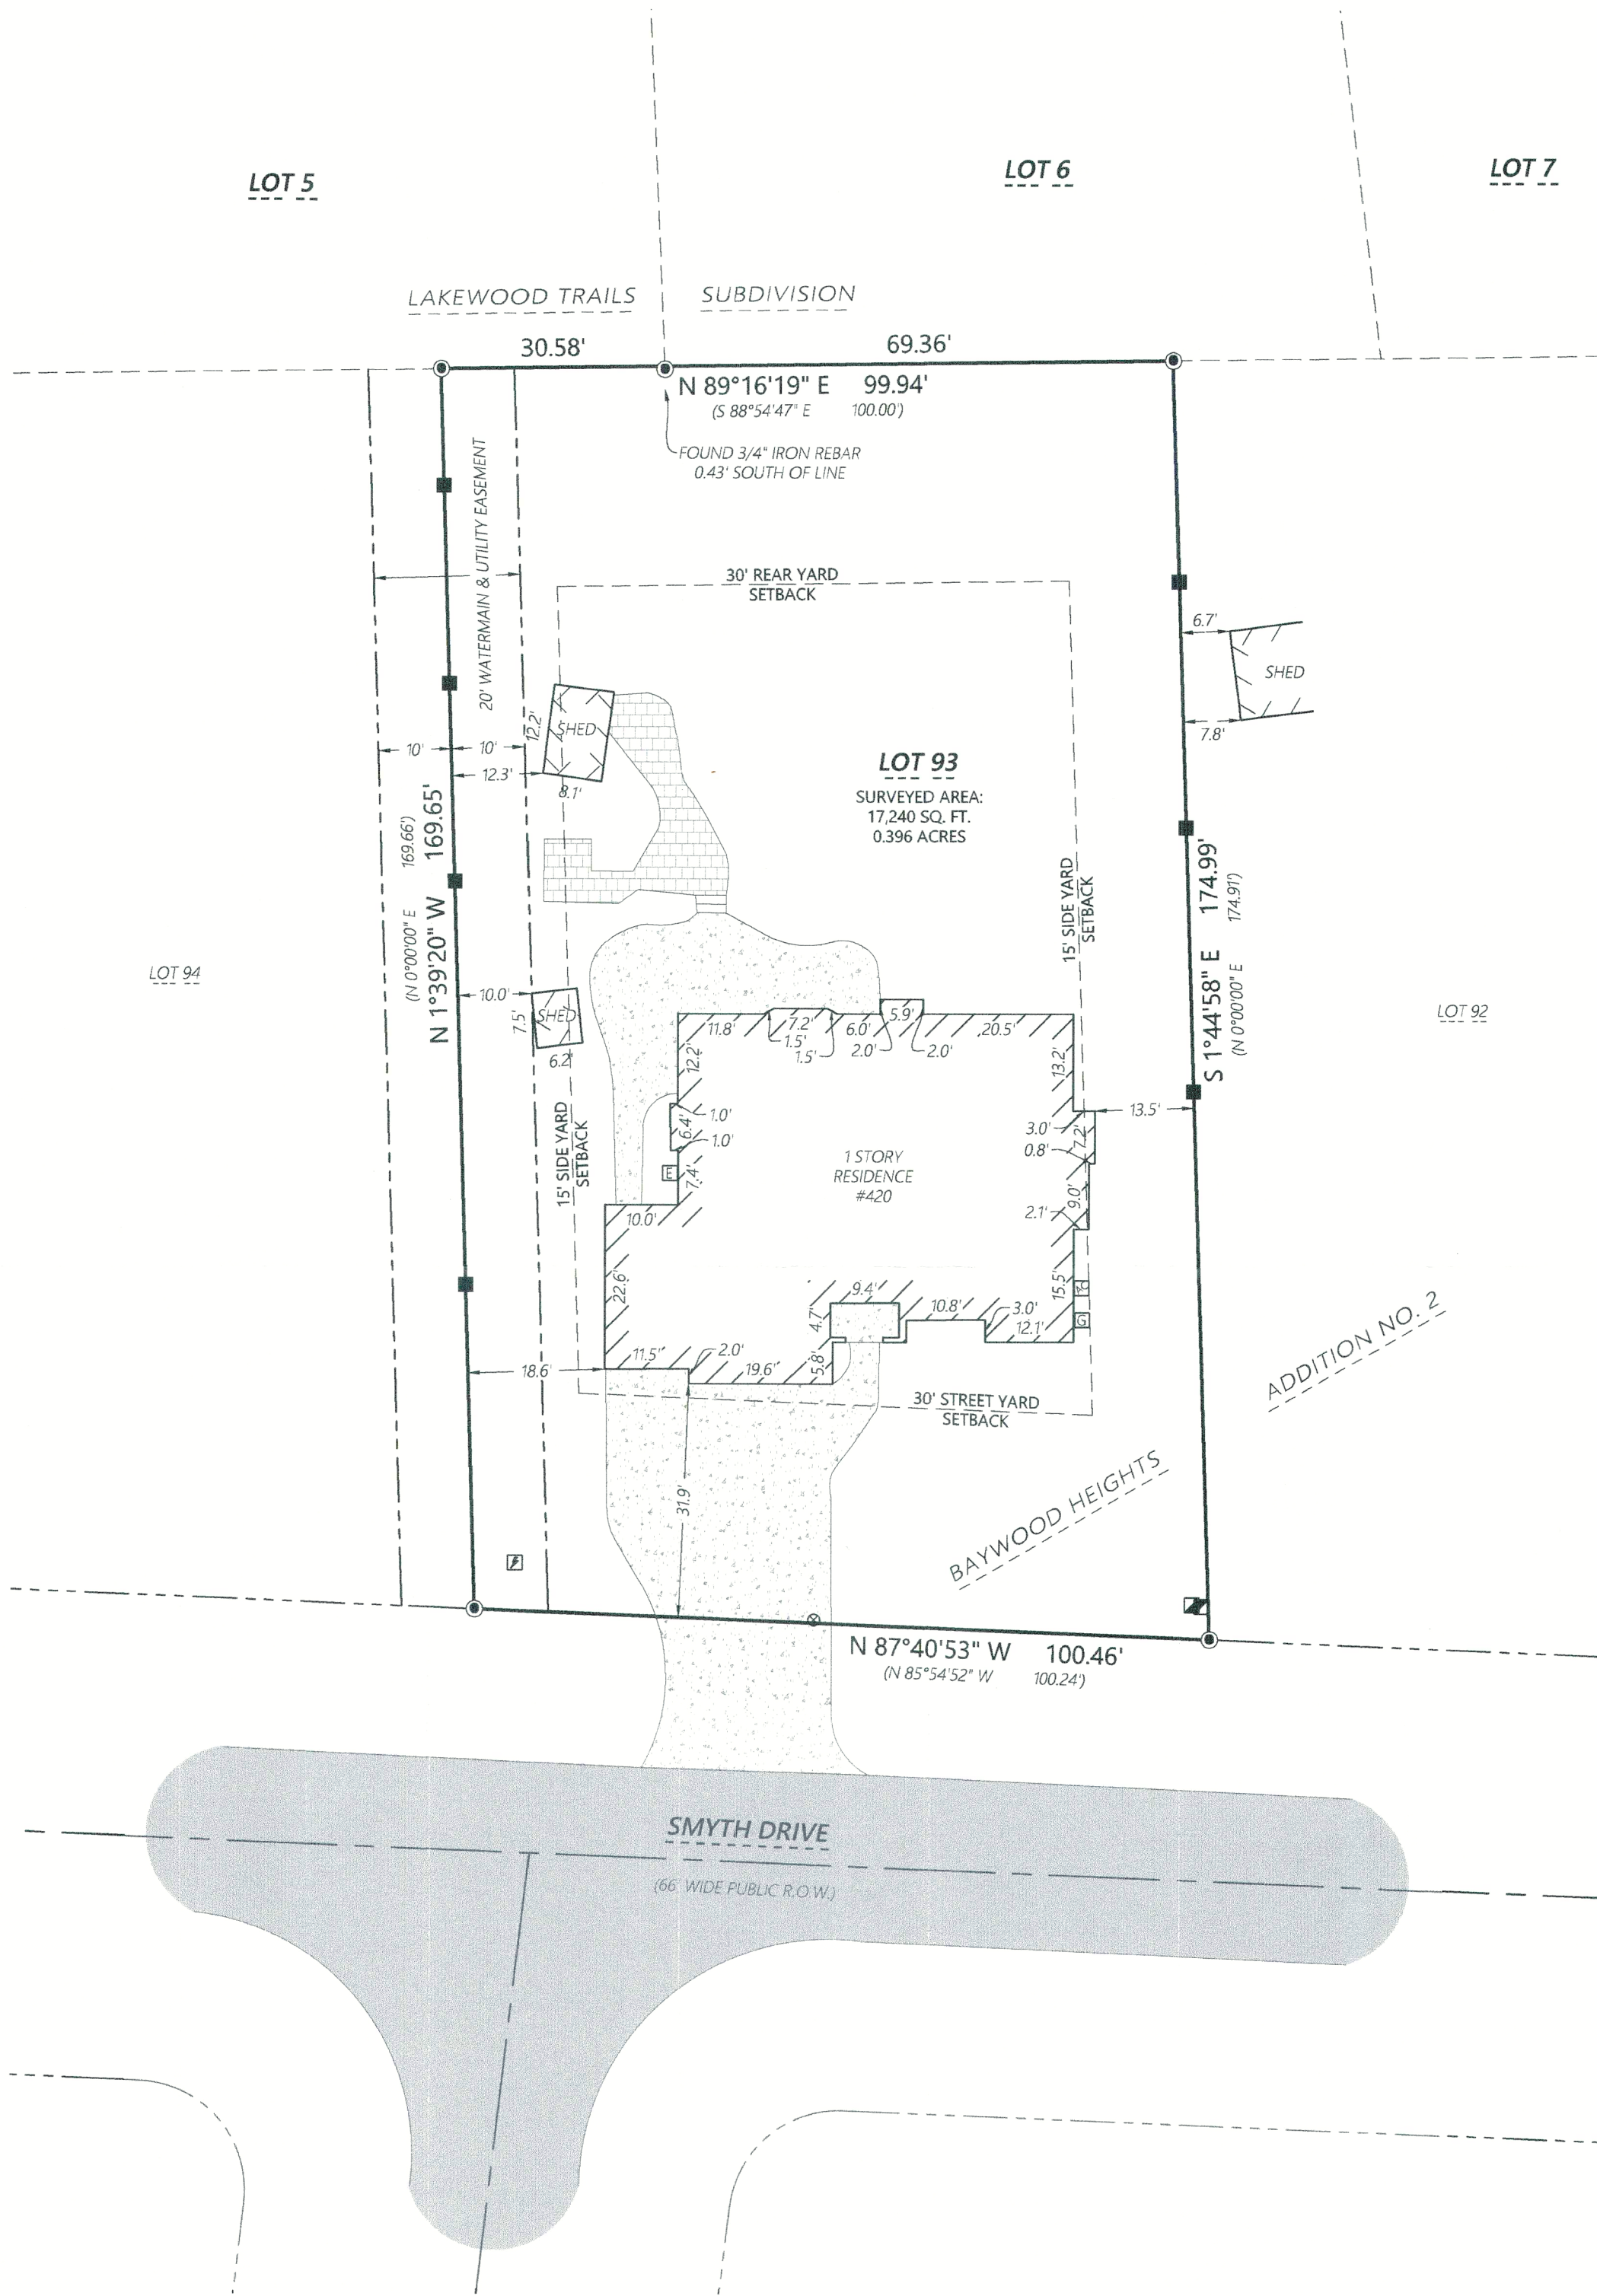

## MONUMENT KEY

- 3/4" Iron Rebar Found
- (XXX.XX) Record Information
- Wooden Lath Set on Line

## LEGEND

- Existing Boundary Line
- - - Existing Right-of-Way
- - - Existing Adjacent Property
- - - Existing Centerline
- - - Existing Easement Line
- ⊠ Existing Electric Meter
- ⊠ Existing Gas Meter
- ⊠ Existing Air Conditioner
- ⊠ Existing Transformer
- ⊠ Existing Electric Pedestal
- ⊠ Existing Telephone Pedestal
- ⊠ Existing Water Valve
- Existing Asphalt Pavement
- Existing Concrete
- Existing Brick

## SURVEY NOTES

- SURVEYED PROPERTY SUBJECT TO ANY AND ALL EASEMENTS AND AGREEMENTS RECORDED AND UNRECORDED.
- ANY EASEMENTS AND/OR RESTRICTIONS SHOWN ON THIS SURVEY ARE FROM THE RECORDED SUBDIVISION PLAT.
- THIS SURVEY IS A RETRACEMENT OF A SURVEY PERFORMED BY JOHN P. KROTT DATED JULY 20, 1999.

*Kristin J. Belongia*

Kristin J. Belongia, P.L.S.  
Wisconsin Professional Land Surveyor S-2943

State of Wisconsin } ss  
County of Walworth }

I hereby certify that I have supervised the survey of the property described above and to the best of my knowledge and belief, the plat drawn hereon complies with Chapter A-E 7 of the State of Wisconsin Administrative Code, Minimum Standards for Property Surveys and correctly represents said survey and its location.

Given under my hand and seal at Elkhorn, Wisconsin this 17th day of April, 2026  
Last day of field work April 9th, 2026



If the surveyor's signature is not red in color, the plan is a copy that should be assumed to contain unauthorized alterations. The certification contained on this document shall not apply to any copies.

ORDER NO: 35874

FIELD CREW: BMR  
DRAWN BY: BMR  
SHEET 1 OF 1

FOR THE EXCLUSIVE USE OF:  
Michelle Pauli & John Pauli  
420 Smyth Drive  
Williams Bay, WI 53191

PLAT OF SURVEY

**Batterman**  
engineers surveyors planners  
BELOIT | ELKHORN | JANESVILLE  
2857 S. Bartells Dr., Beloit, WI 53511  
608.365.4464 | www.rhbatterman.com

