
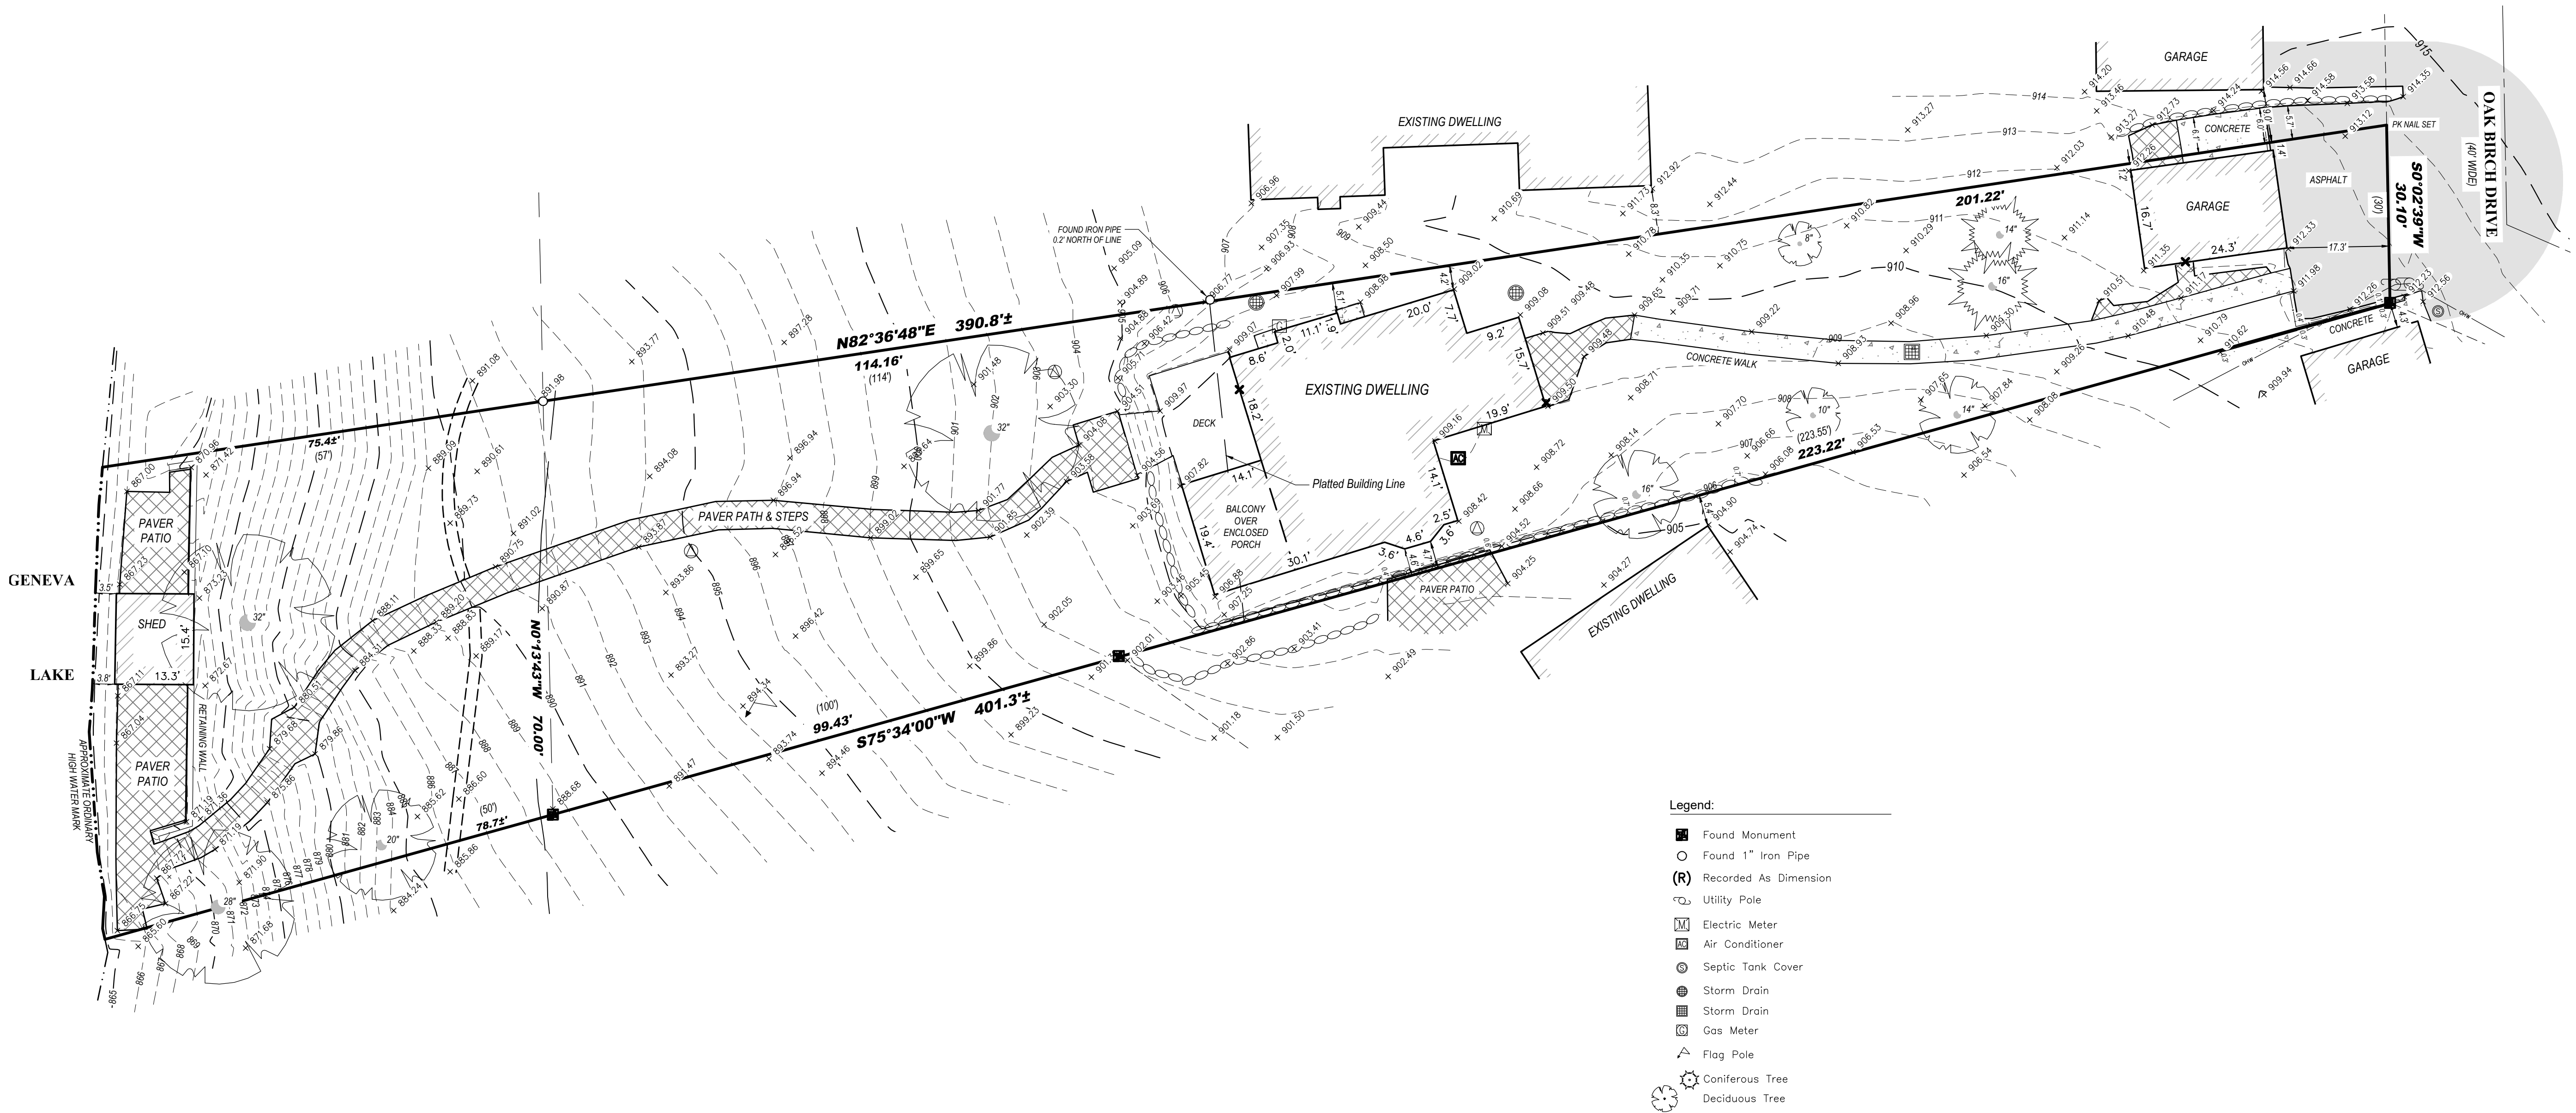


PLAT OF SURVEY

LOCATION: 68 Oak Birch Drive
Williams Bay, WI
PREPARED FOR: Maddock Construction
PROPERTY DESCRIPTION:
Lot 11, Cedar Point Park, First Addition, recorded as Document No. P246718, with the Register of Deeds in and for Walworth County, on September 29, 1924, located in the East 1/2 of Section 6, Town 1 North, Range 17 East, Village of Williams Bay, Walworth County, Wisconsin.
TAX ID: WCP1 00009A

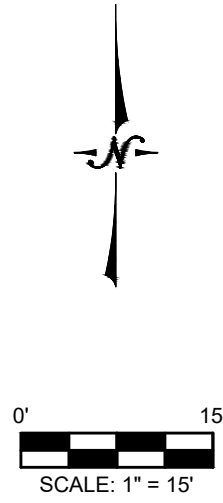

BEARINGS HEREON RELATE TO THE SOUTH LINE OF LOT 11, ASSUMED BEARING SOUTH 75°34'00" WEST.

APPROXIMATE ORDINARY HIGH WATER MARK - FOR REFERENCE ONLY PER STATE STATUTE 236.025

"ANY LAND BELOW THE ORDINARY HIGH WATER MARK OF A LAKE OR A NAVIGABLE STREAM IS SUBJECT TO THE PUBLIC TRUST IN NAVIGABLE WATERS THAT IS ESTABLISHED UNDER ARTICLE IX, SECTION 1, OF THE STATE CONSTITUTION."