


**SURVEYING & SUBDIVIDING
DELAN, WISCONSIN 53115**

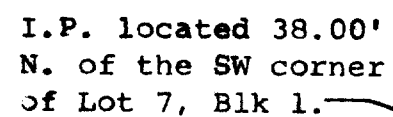

I, James M. Dunham, Surveyor, certify that I have surveyed the property described as follows,

and the above map is a true representation thereof and shows the size and location of the property, its exterior boundaries, the location and dimensions of all structures thereon, fences apparent easements and roadways and visible encroachments, if any. This survey is made for the exclusive use of the present owners of the property, and also those who purchase, mortgage, or guarantee the title ~~thereto~~ within one (1) year from date hereof; and as to them I warrant the accuracy of said survey and map.

June 30, 1977

A circular seal for a Wisconsin Land Surveyor. The outer ring contains the text "WISCONSIN" at the top and "LAND SURVEYOR" at the bottom, separated by two five-pointed stars. Inside this ring, the name "JAMES M. DUNHAM" is printed in a larger font, followed by "S-1331", "DELAVAN,", and "WIS." in a smaller font.