


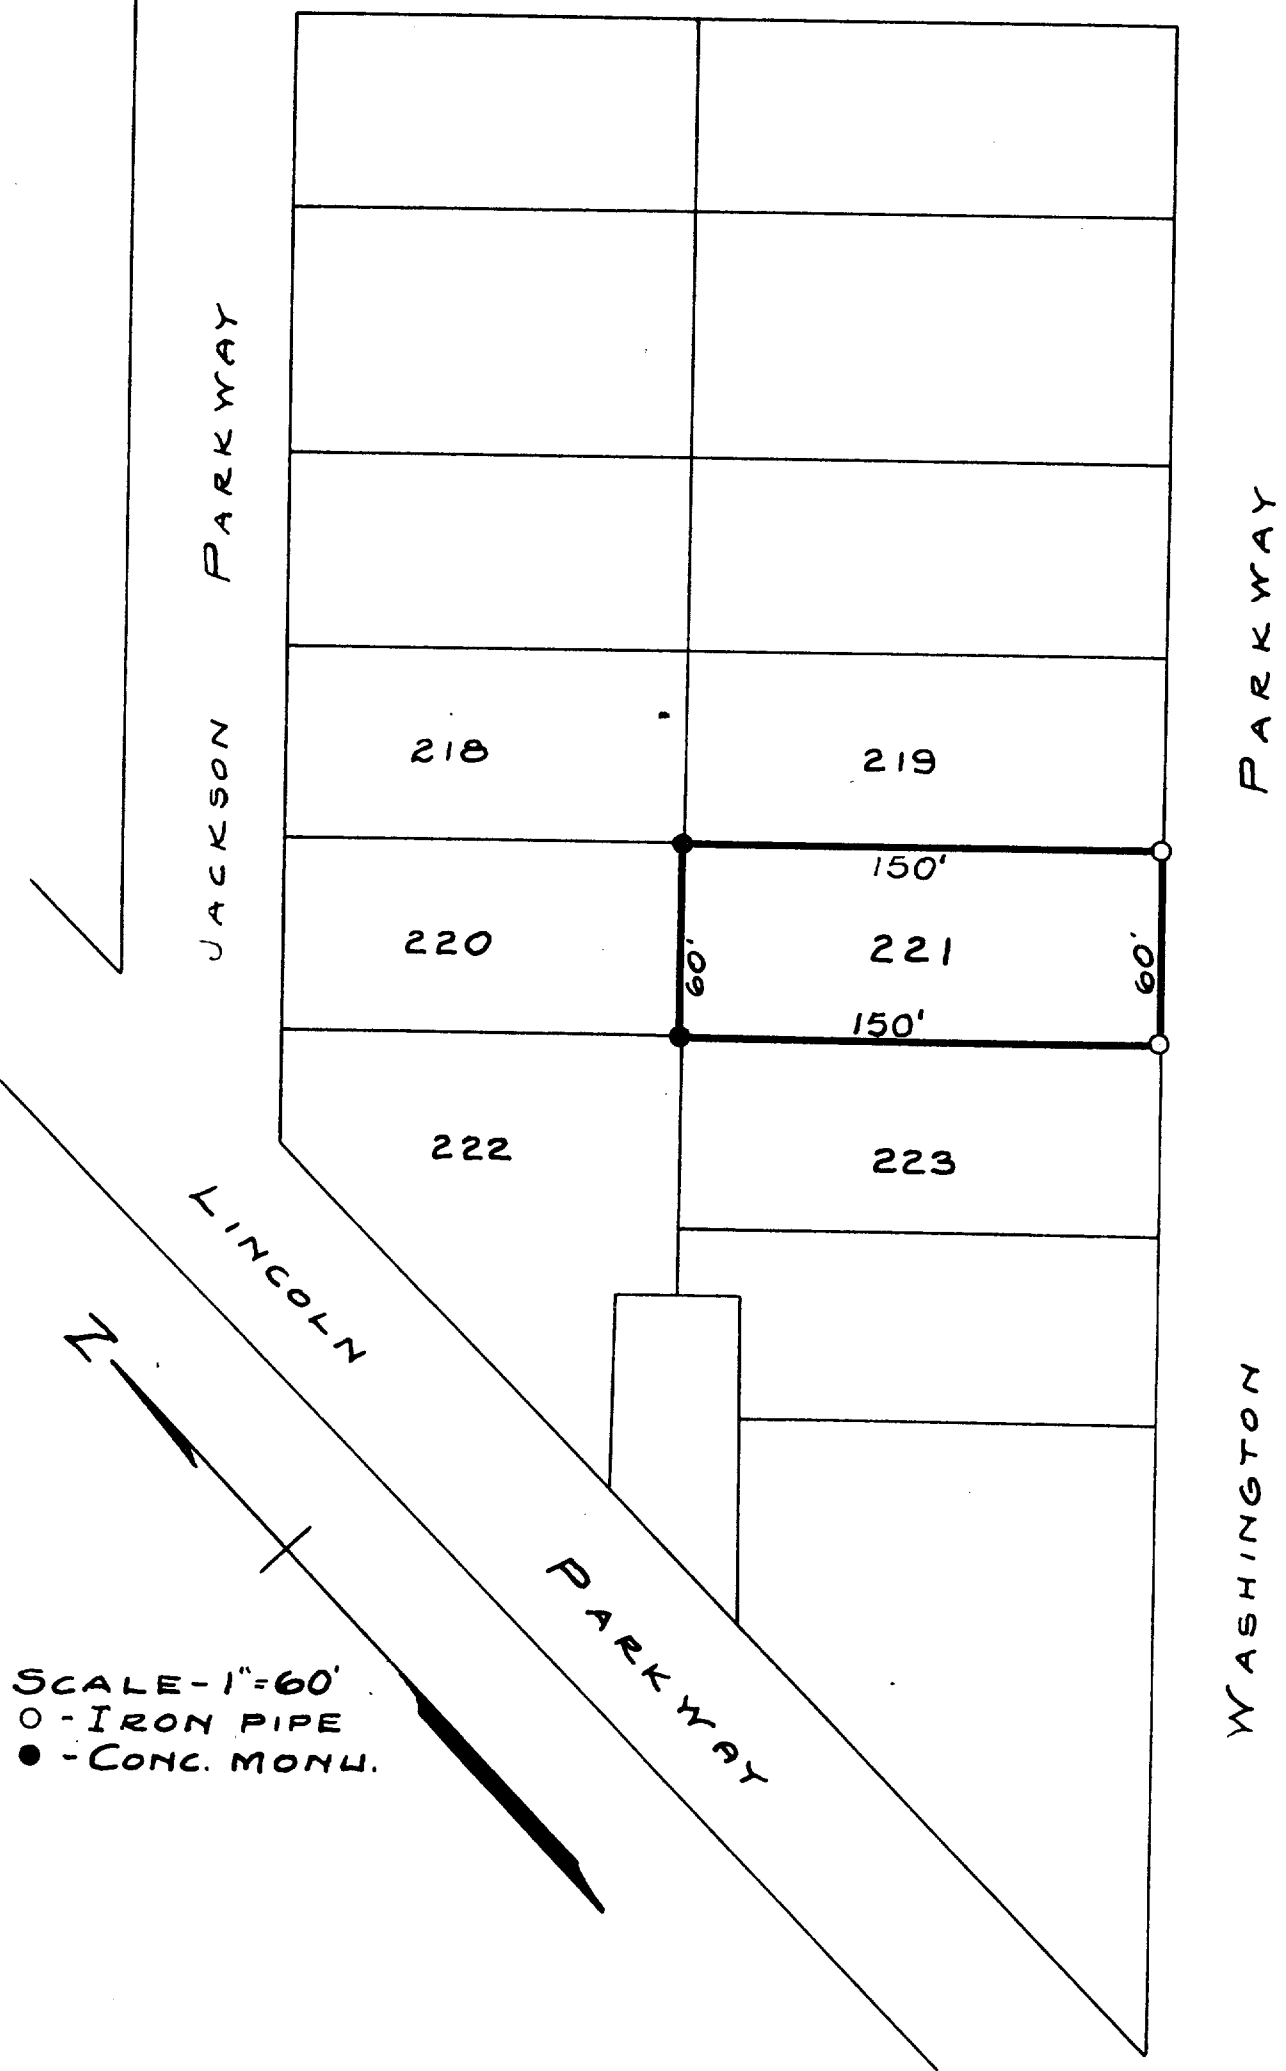

SCALE - 1" = 60'
O - IRON PIPE
● - CONC. MONU.

PLAT OF SURVEY OF LOT 221 OF THE ORIGINAL CEDAR POINT PARK SUBDIVISION WHICH IS LOCATED IN THE VILLAGE OF WILLIAMS BAY, SECTION 6, T1N R17E, WALWORTH COUNTY, WISCONSIN.

SEPT. 1946

Lloyd L. Jensen
SURVEYOR