


Plat of Survey of
Lot 37 & 38, Cedar Point Park Subdivision,
Section 6, Town 1 North, Range 17 East,
Village of Williams Bay, Walworth County,
Wisconsin.

Bearing reference:
The Northwestern line of
Cedar Point Drive was assumed
to bear N50°33'E

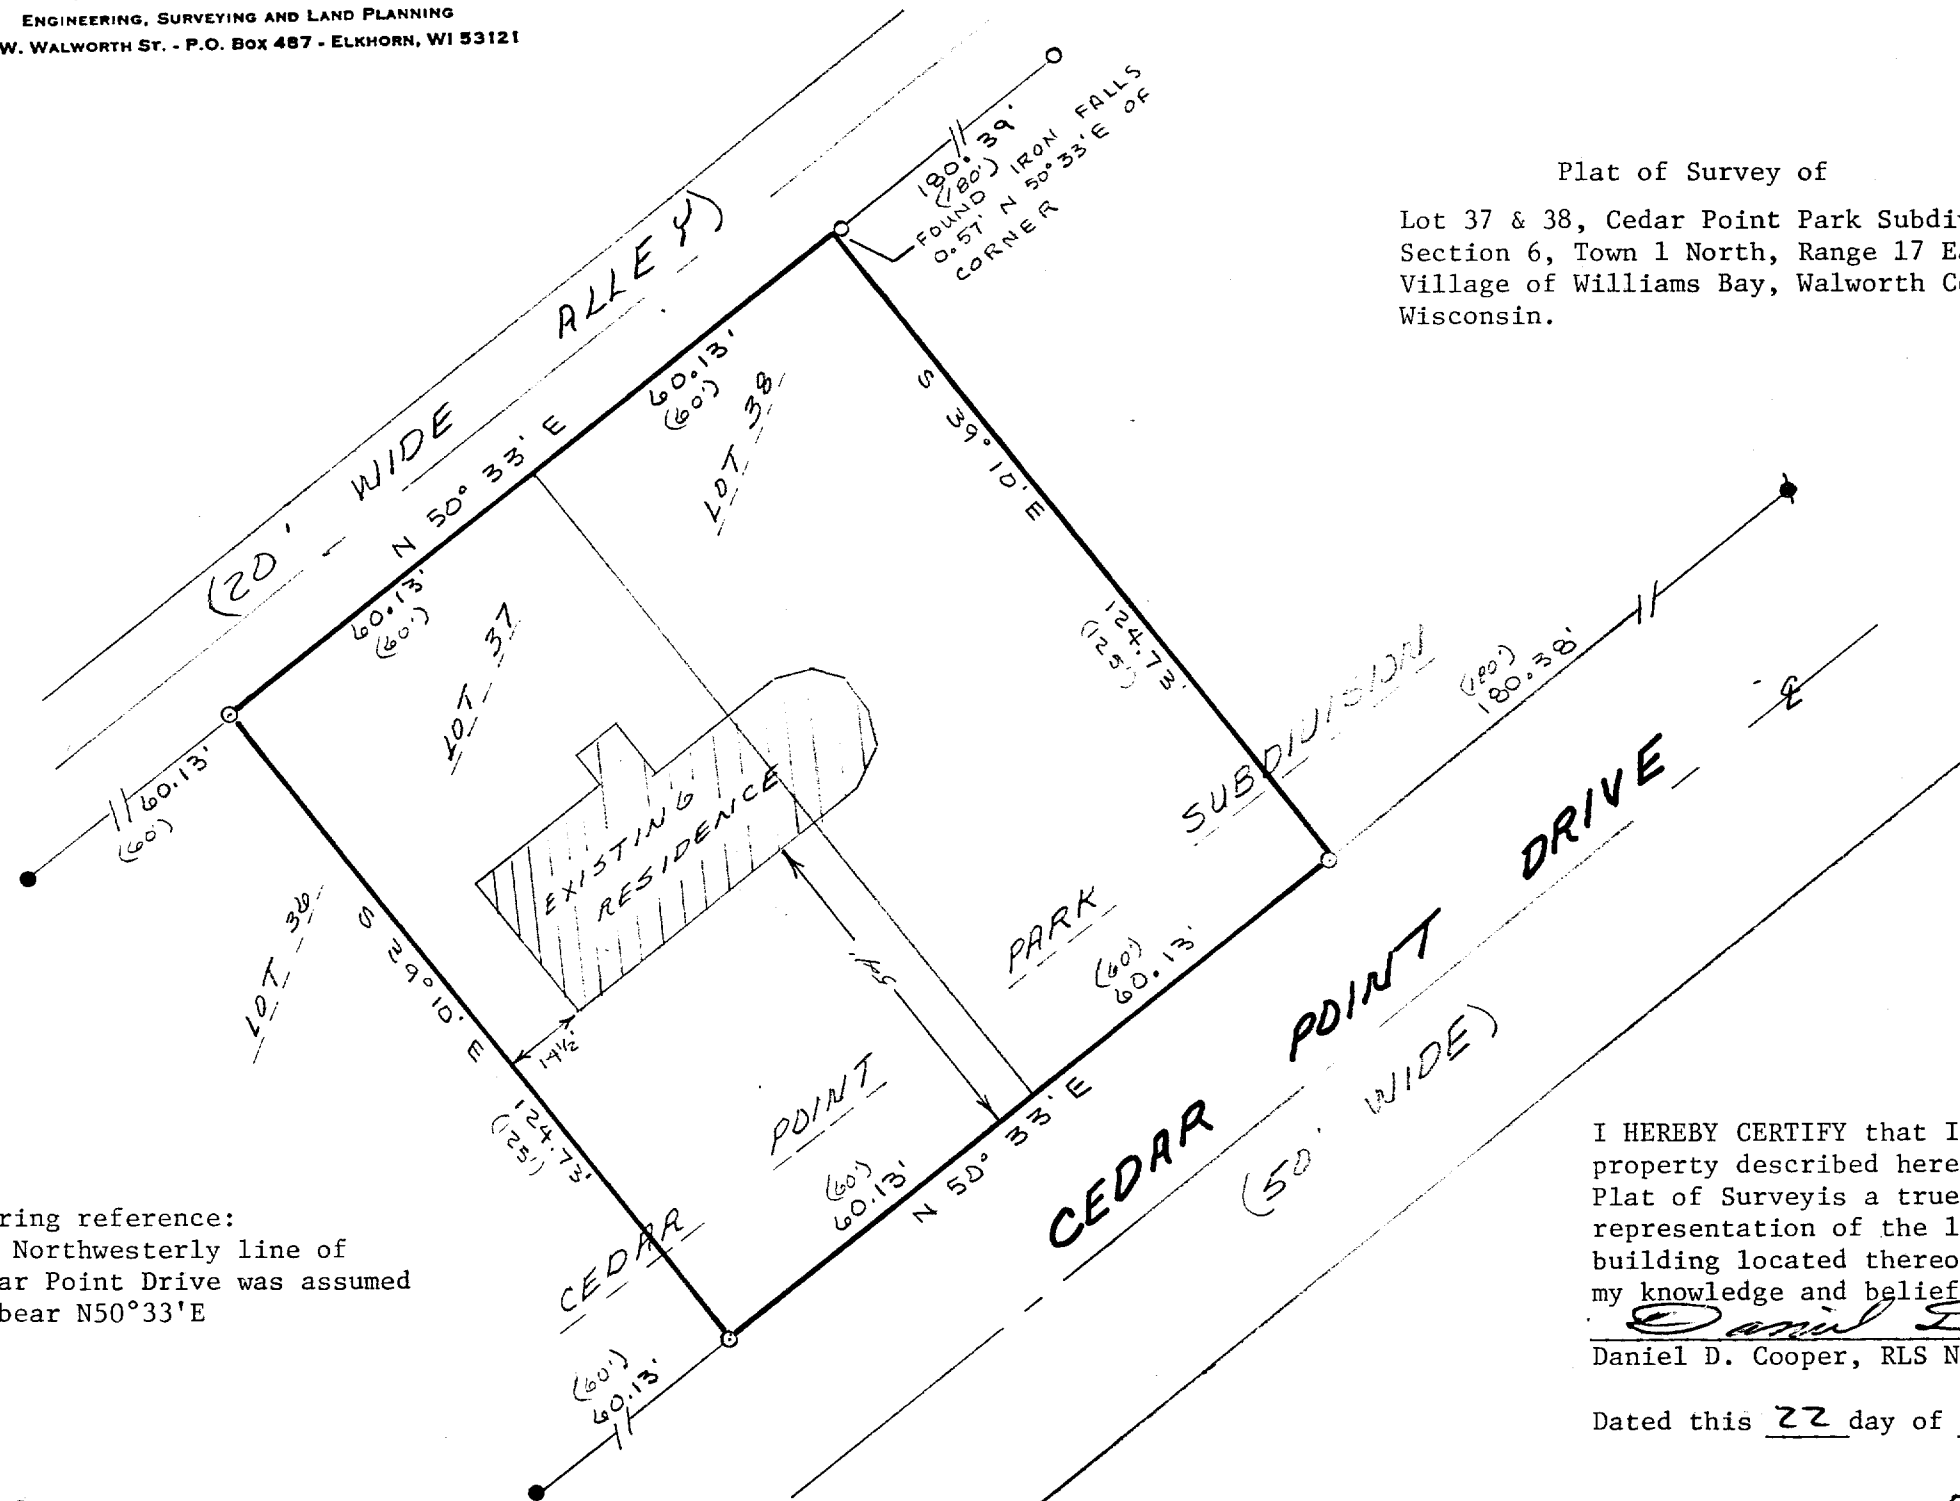

- () RECORD DIMENSION
● CONC. MON. FOUND
○ IRON PIPE FOUND
● IRON ROD FOUND

SCALE 1" = 30'
20 10 0 10 20 30 40

Ordered By: Bay Realty

I HEREBY CERTIFY that I have surveyed the
property described hereon and that this
Plat of Survey is a true and accurate
representation of the lot lines and the
building located thereon to the best of
my knowledge and belief.

Daniel D. Cooper
Daniel D. Cooper, RLS No. S-1464

Dated this 22 day of Sept., 1980

11-351-F

DRAWING NO. 1759