


HAROLD H. KOLB

REGISTERED PROFESSIONAL LAND SURVEYOR
LAKE GENEVA, WISCONSIN

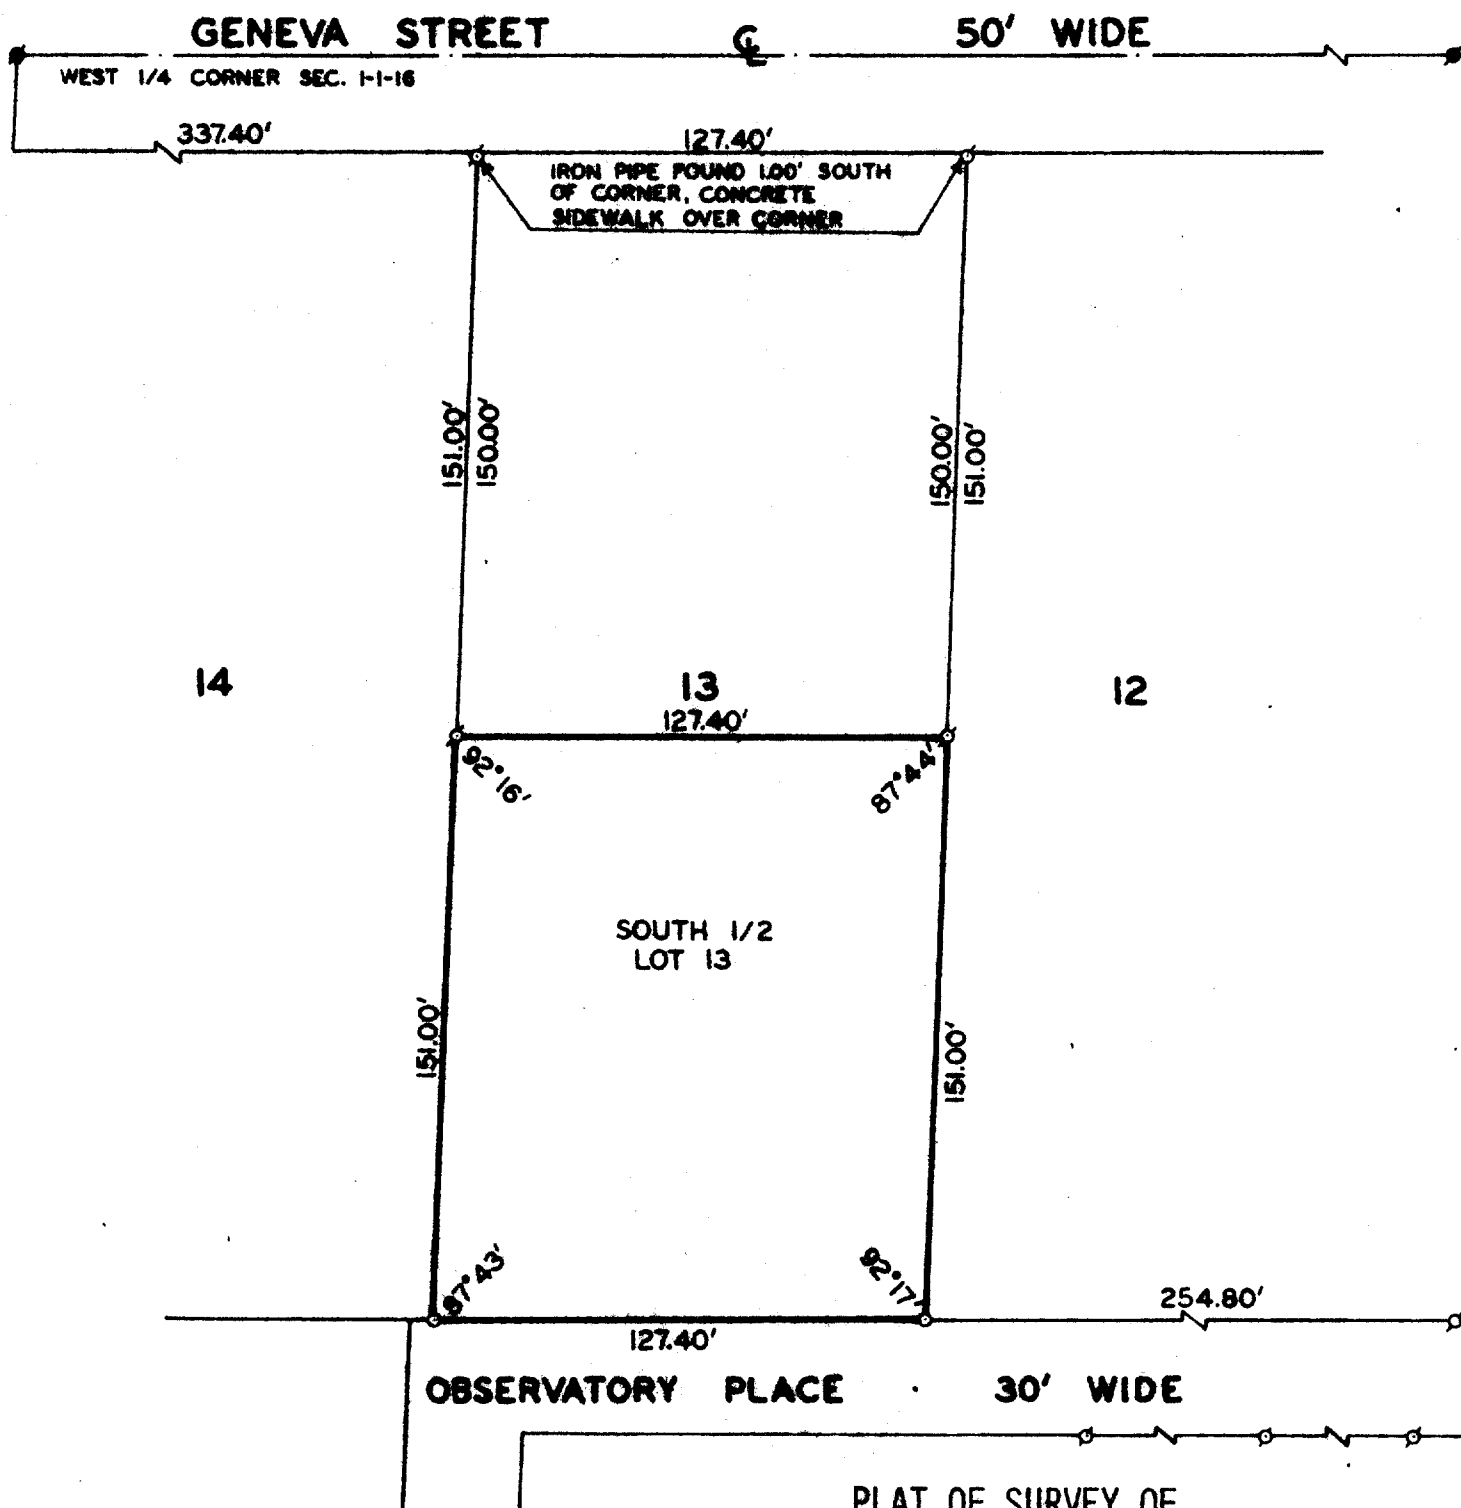

PLAT OF SURVEY OF

THE SOUTH 1/2 OF LOT 13, OBSERVATORY
SUBDIVISION, VILLAGE OF WILLIAMS BAY,
WALWORTH COUNTY, WISCONSIN.



ORDERED BY: KENNETH SPATZ

Parcel 11013-24B

I, HAROLD H. KOLB, DO HEREBY CERTIFY THAT I HAVE
SURVEYED THE PROPERTY HEREON DESCRIBED ACCORDING
TO THE OFFICIAL RECORDS, AND THAT THE PLAT HEREON
IS A CORRECT REPRESENTATION OF THE LOT LINES.



SCALE: 1" = 50'
LEGEND

- O - IRON PIPE PLACED
- Ø - IRON PIPE FOUND
- - CONCRETE MONUMENT FOUND

Harold H. Kolb

HAROLD H. KOLB
WISCONSIN REGISTERED LAND SURVEYOR, S-187
DATE *JUNE 16, 1977*

11-359