


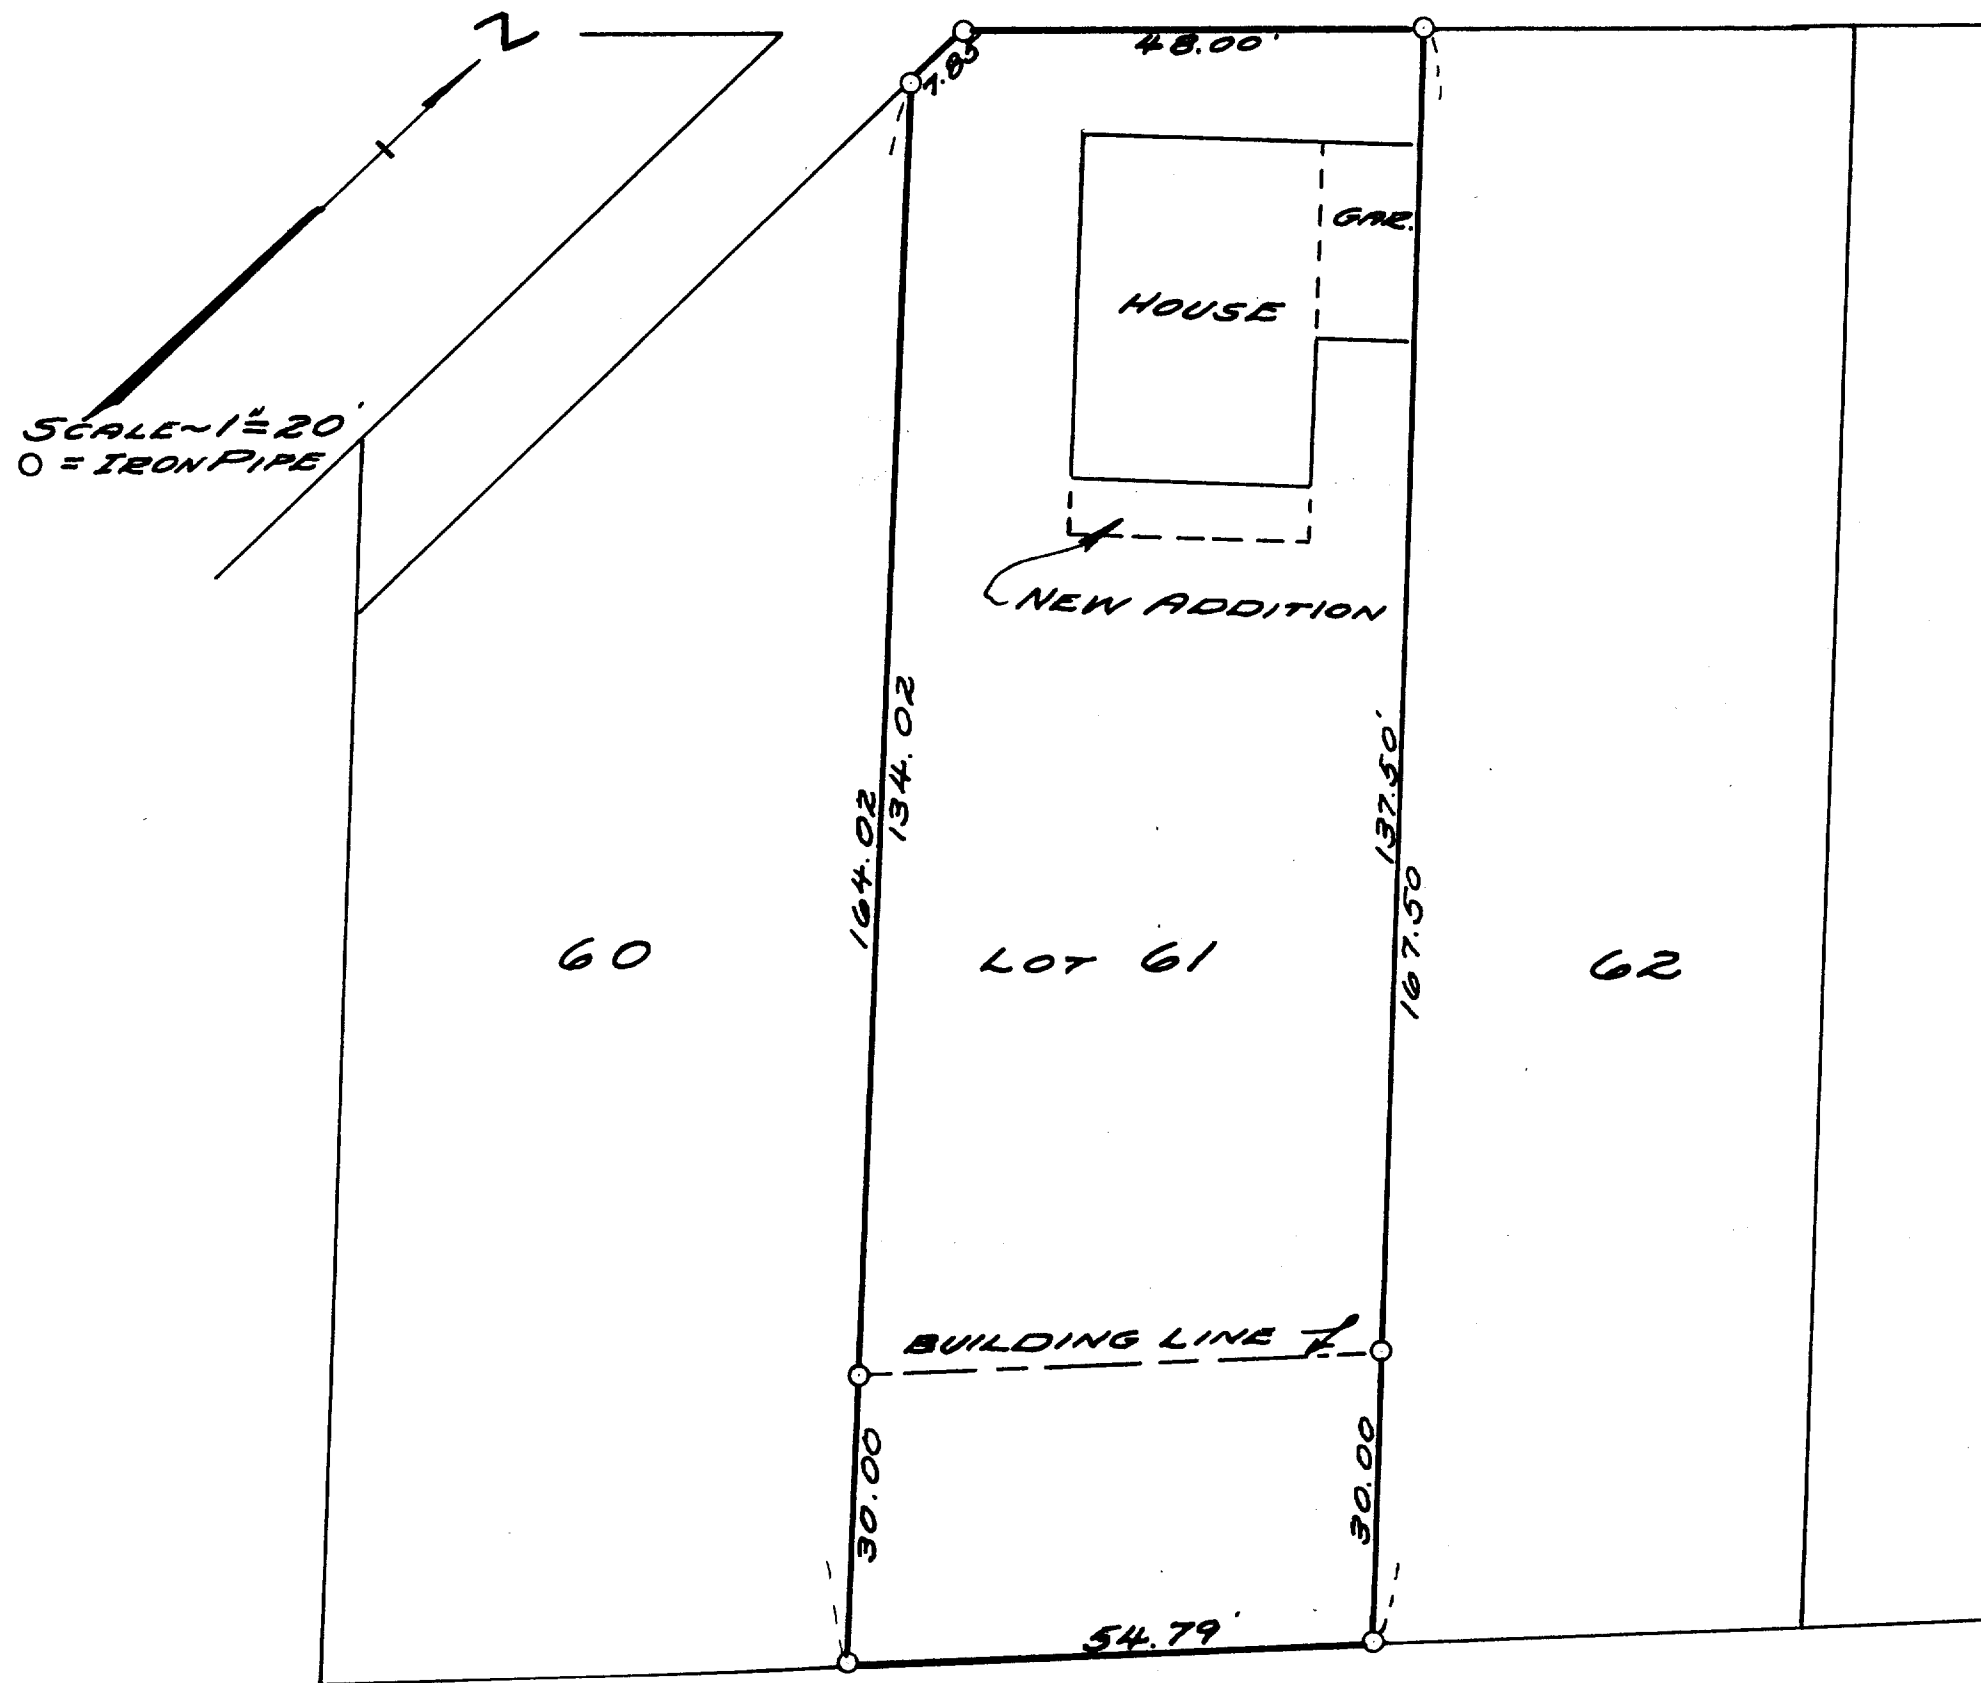

I HEREBY CERTIFY THAT I HAVE SURVEYED LOT 61
OF THE ORIGINAL CEDAR POINT PARK SUBDIVISION IN
THE VILLAGE OF WILLIAMS BAY, WISCONSIN AND THAT
THE ABOVE PLAT IS A CORRECT REPRESENTATION
THEREOF. I FURTHER CERTIFY THAT I HAVE
LOCATED THE BUILDING LINE AS SHOWN IN THE
DEED FOR SAID LOT 61

DEC. 20, 1947

H. E. Johnson
SURVEYOR
R. C. E. 2093