



DUNHAM SURVEYING, S.C.
SURVEYING & SUBDIVIDING
DELAVER, WISCONSIN 53115

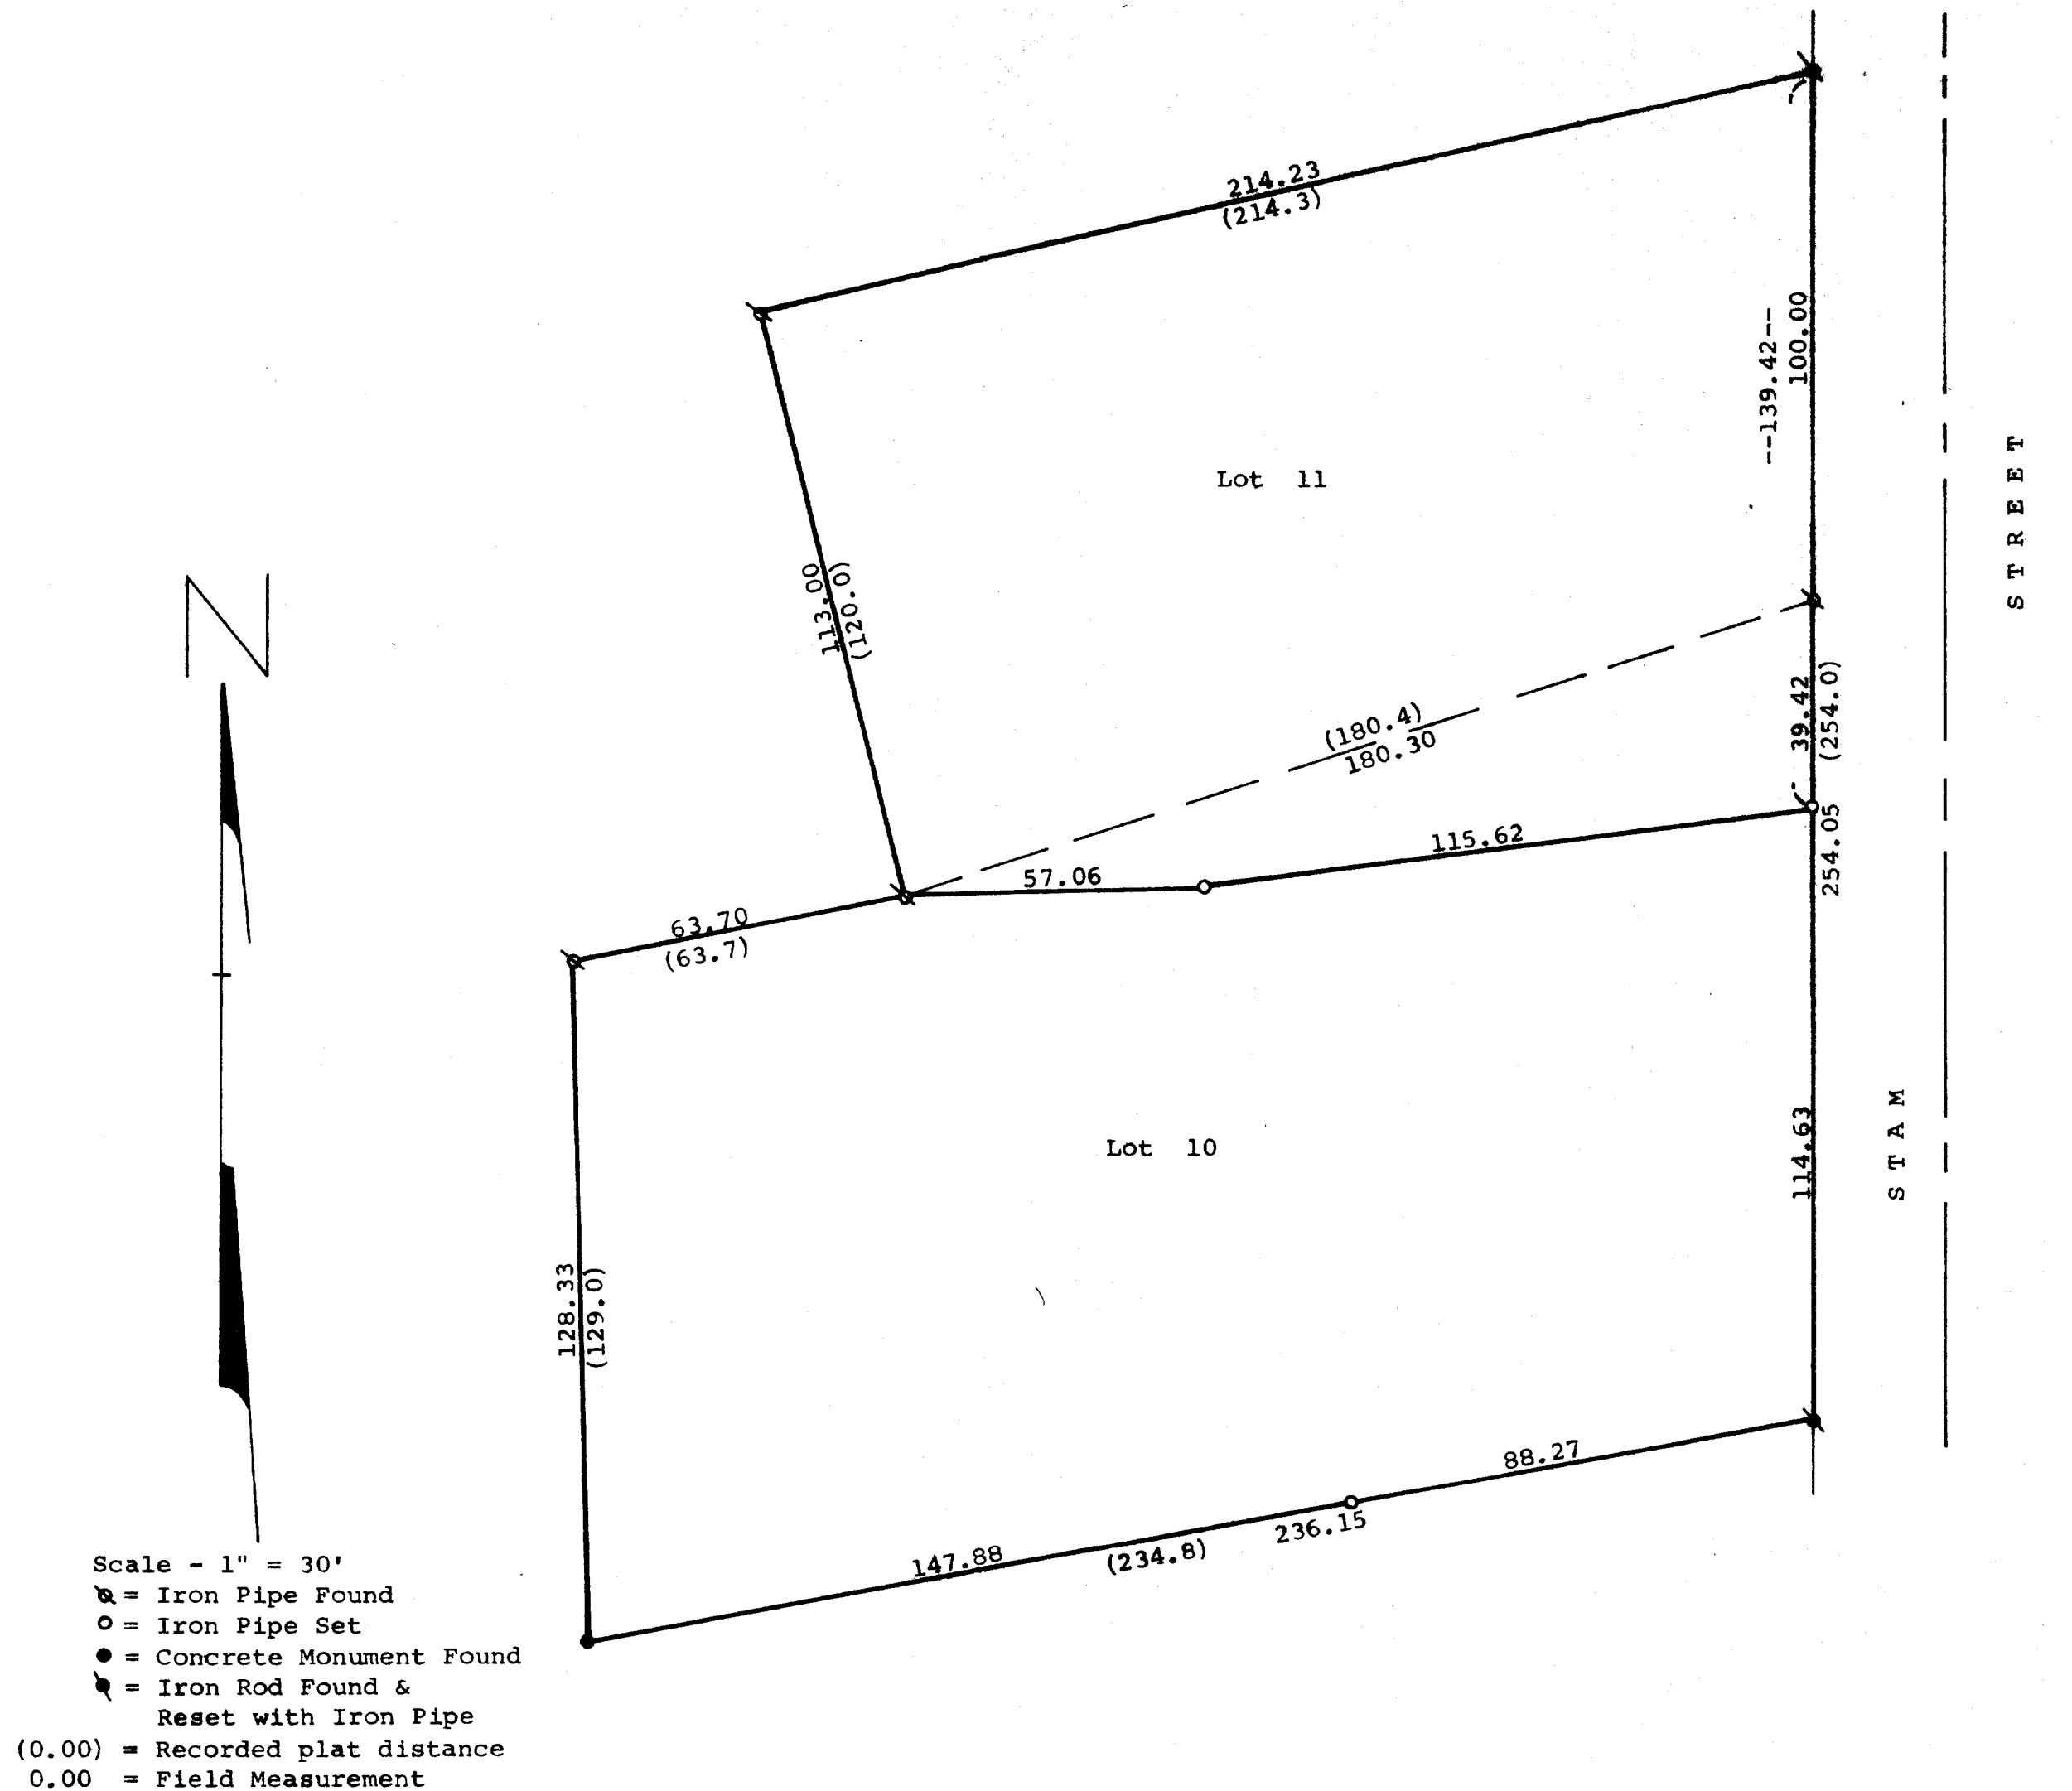

Plat of survey of Lots 10 and 11, Block 2 of University Heights, a subdivision located in the Village of Williams Bay, Walworth County, Wisconsin.
July 27, 1977

James M. Dunham
James M. Dunham, Surveyor

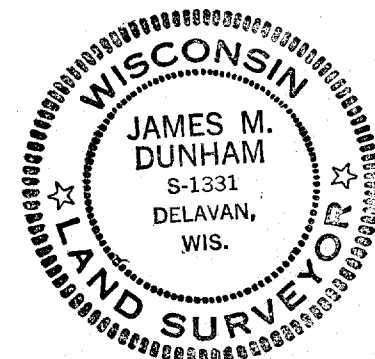

WUH-12
11-13

11-363