



PLAT OF SURVEY OF

LOT 176 CEDAR POINT PARK 2ND ADDITION
VILLAGE OF WILLIAMS BAY, WALWORTH
COUNTY, WISCONSIN

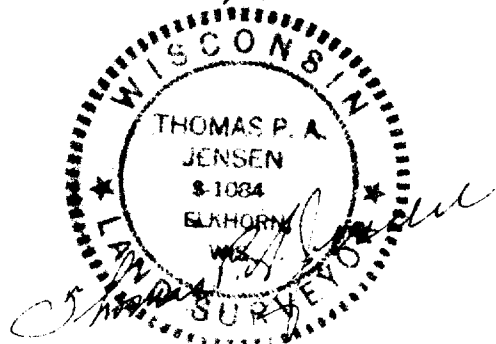

I CERTIFY THAT I HAVE SURVEYED THE
ABOVE DESCRIBED PROPERTY & THAT THE
PLAT SHOWN HEREON IS AN ACCURATE
SURVEY & A TRUE REPRESENTATION
THERE OF & CORRECTLY SHOWS THE
BOUNDARY LINES OF SAID PROPERTY.
MAR. 17, 1978

JENSEN SURVEYING
MAPPING
ELKHORN WIS

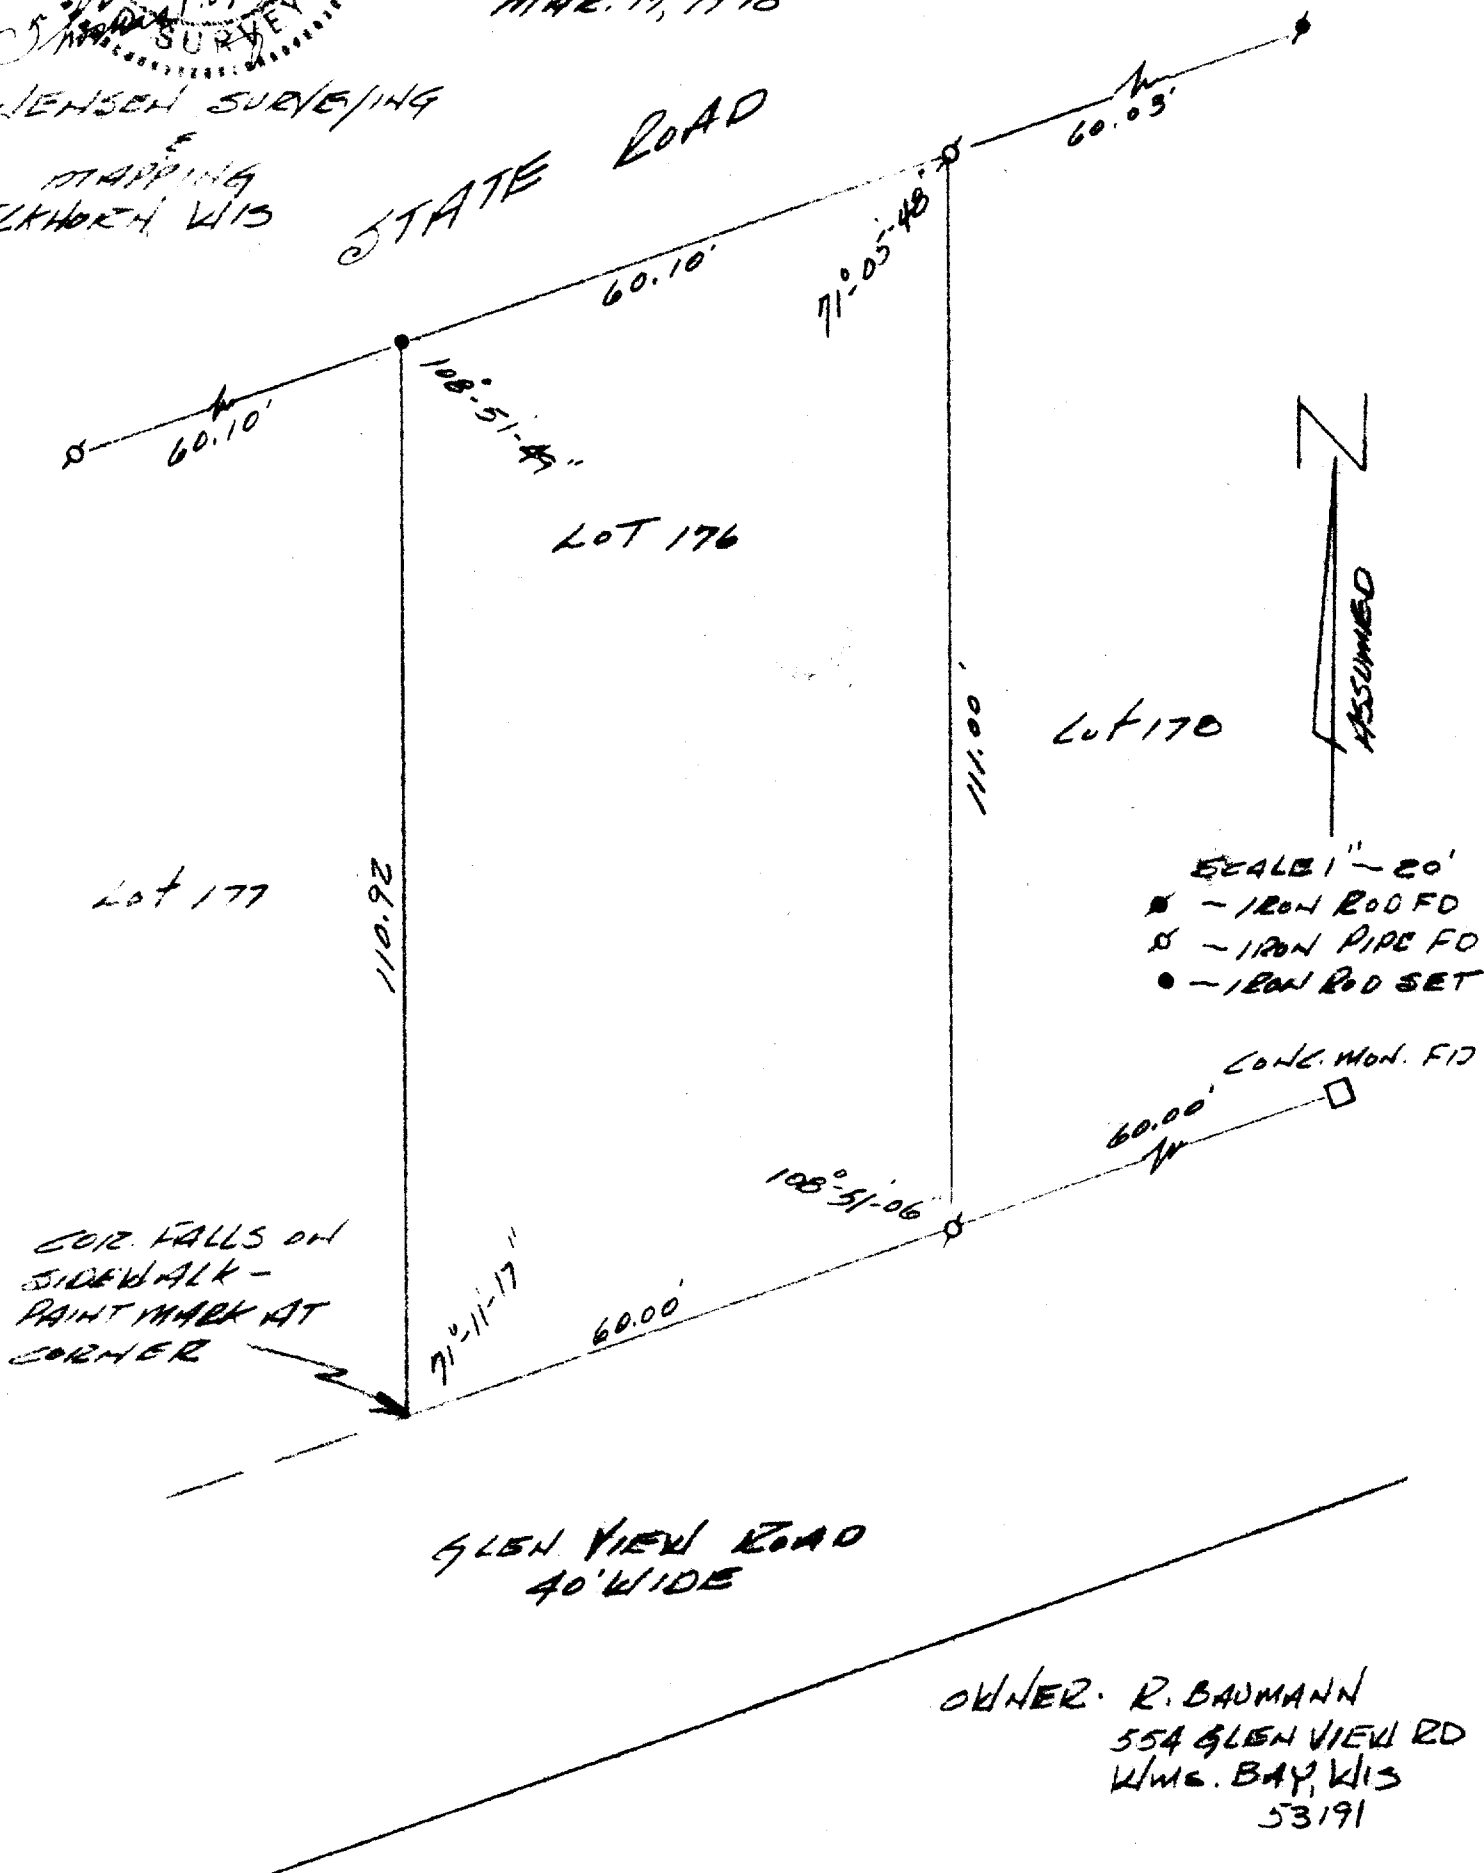

P.O. 1978. 011

11-368