


GEORGE T. DUNHAM  
SURVEYING & SUBDIVIDING  
DELAVER, WISCONSIN

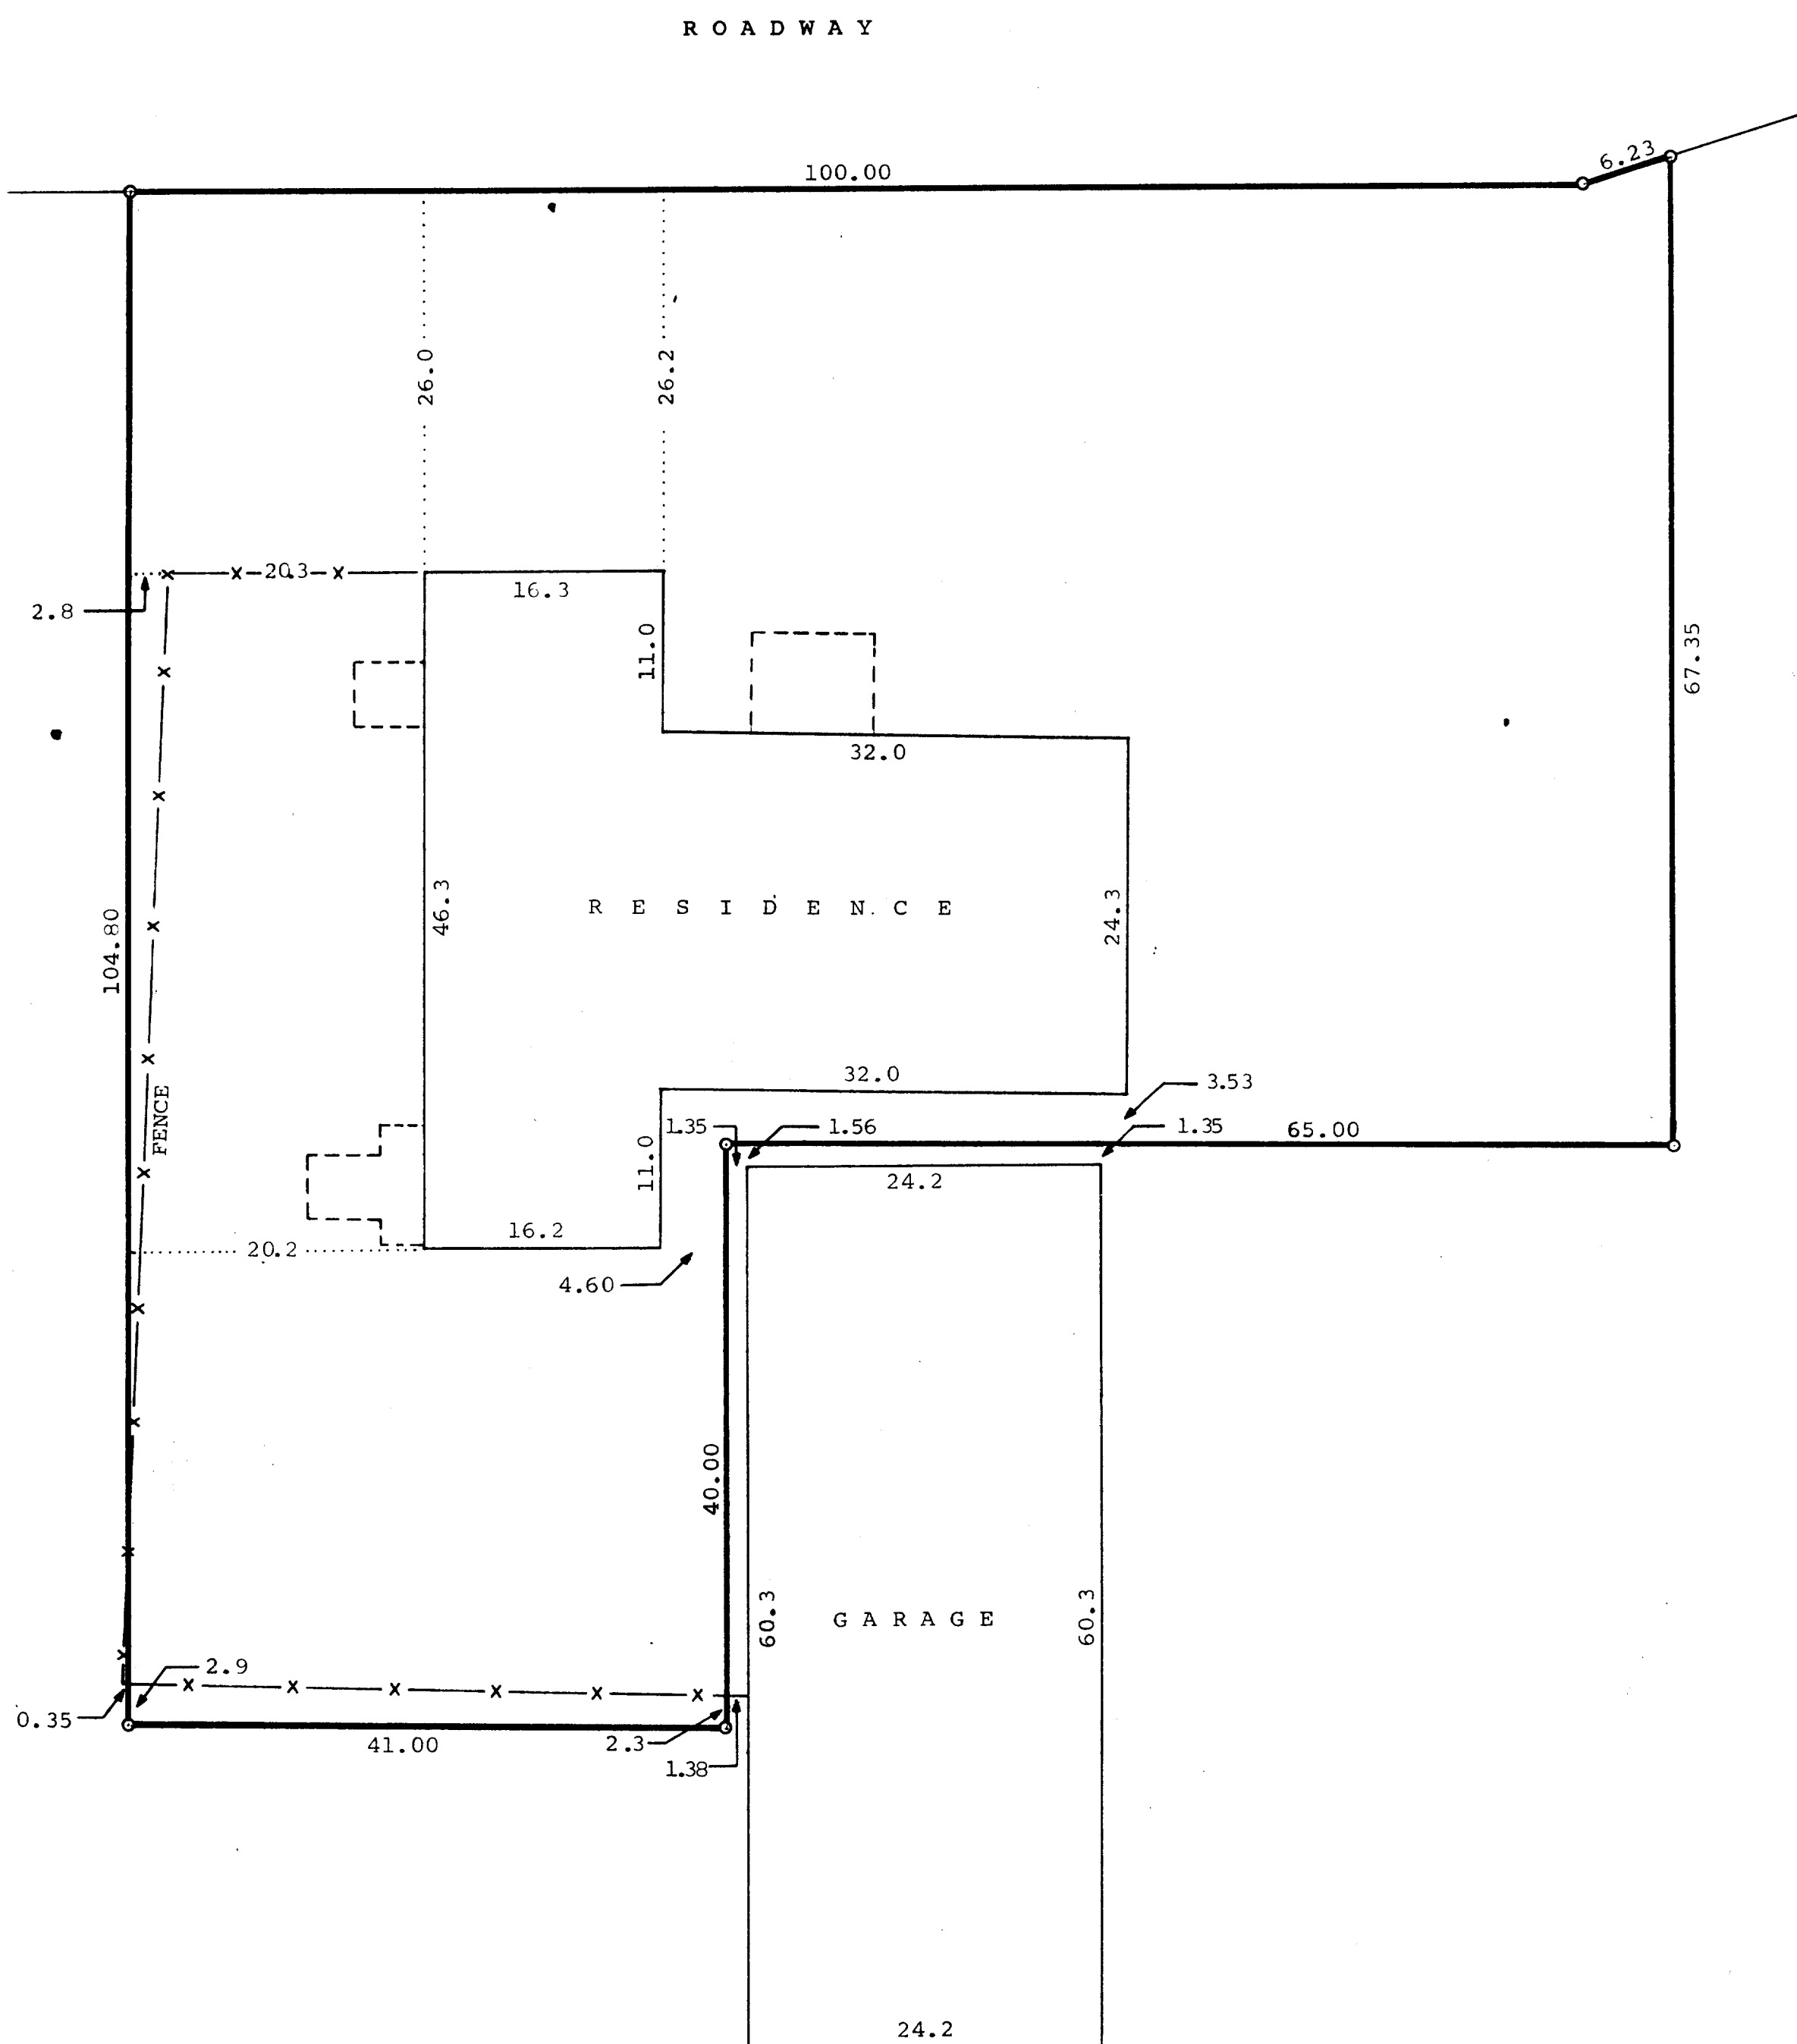

Scale - 1" = 10'  
O = Iron Pipe

Plat of survey of the West 106 feet of the Outlot in Loch Vista Club  
Subdivision No. 2 EXCEPT the South 40.00 feet of the East 65.00 feet  
thereof, located in the Village of Williams Bay, Walworth County, Wisc.  
August, 1962

*George T. Dunham*  
George T. Dunham, Surveyor