


**HAROLD H. KOLB**

REGISTERED PROFESSIONAL LAND SURVEYOR  
LAKE GENEVA, WISCONSIN


—COLLIE— (47.5 FEET WIDE) —AVE.

ALLEY (15.0 FEET WIDE)

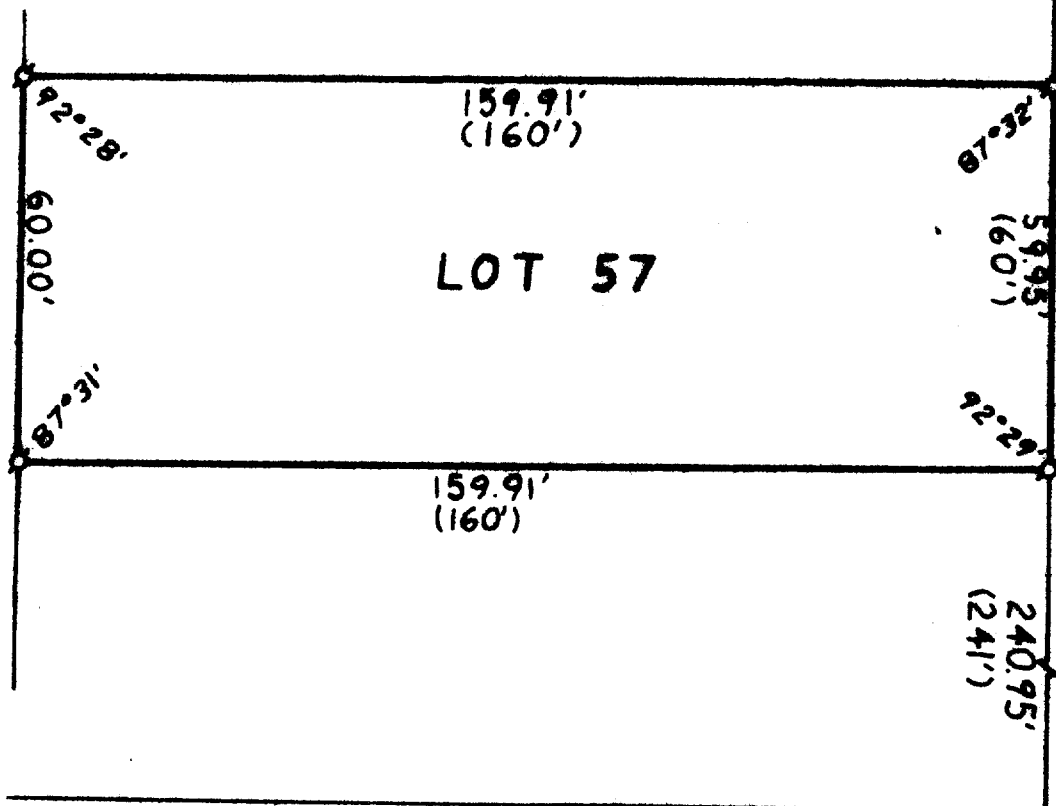

PLAT OF SURVEY OF  
LOT 57, BAY VIEW SUBDIVISION,  
VILLAGE OF WILLIAMS BAY,  
WALWORTH COUNTY, WISCONSIN

ORDERED BY: JOSEPH KOTLARZ

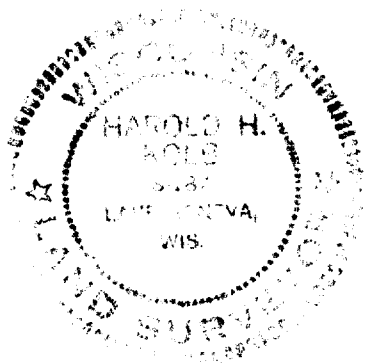

I, HAROLD H. KOLB, DO HEREBY CERTIFY THAT  
I HAVE SURVEYED THE PROPERTY HEREON DE-  
SCRIBED ACCORDING TO THE OFFICIAL RECORDS,  
AND THAT THE PLAT HEREON IS A CORRECT  
REPRESENTATION OF THE LOT LINES.

N



Scale 1" = 30'

**LEGEND**

- — IRON PIPE PLACED, 1" x 24" 1.13 LB./LIN. FT.
- — CONCRETE MONUMENT, 8" DIA. x 30"
- ⊙ — IRON PIPE SOUND (I) — AS PLATTED

*Harold H. Kolb*

HAROLD H. KOLB  
WISCONSIN REGISTERED LAND SURVEYOR, S-187

DATE *Feb 13, 1978*