


SURVEILLANCE CONTINUING
DELAVER, WISCONSIN 53115



- = Concrete Monument
- = Iron Pipe Found
- = Iron Pipe Set
- ✕ = Spike Set at Northeast
Corner of Low Retaining Wall

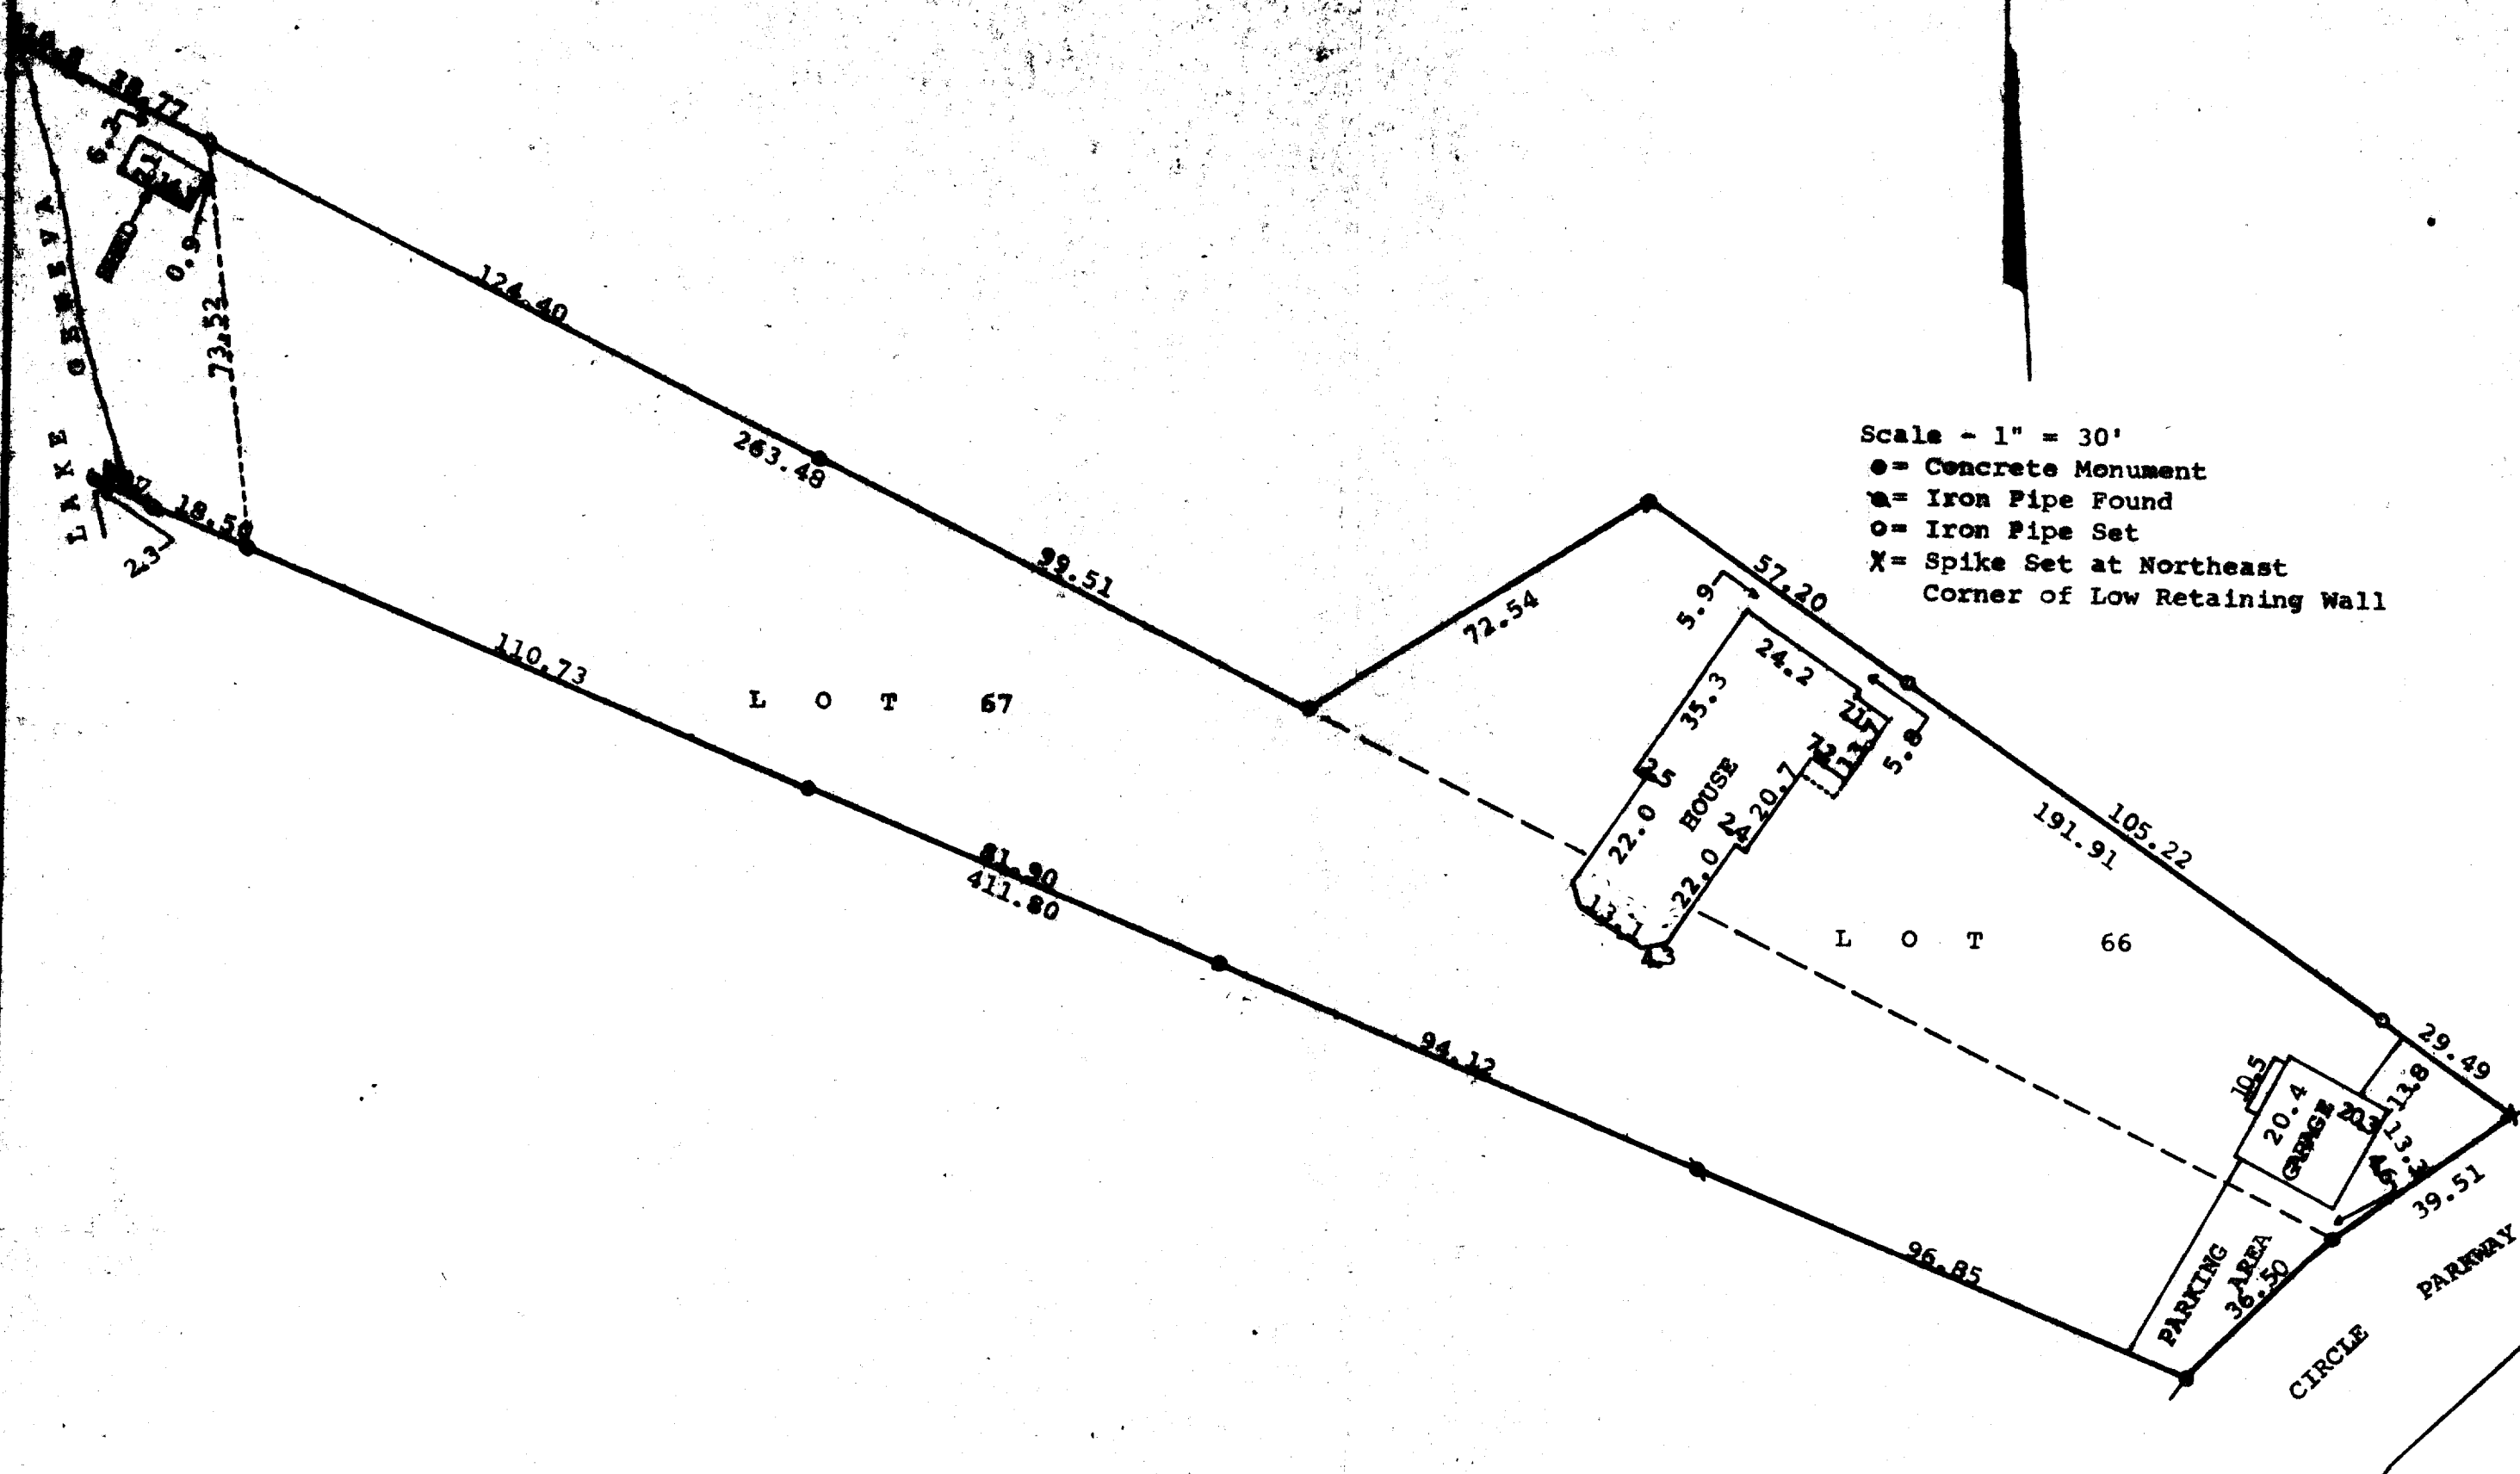

I, George T. Dunham, Surveyor, certify that I have surveyed the property described as follows,
Lots 66 and 67, First Addition Cedar Point Park, Village of Williams Bay, Walworth County, Wisconsin,
and the above map is a true representation thereof and shows the size and location of the property, its exterior boundaries, the location and dimensions of all structures thereon, fences apparent easements and roadways and visible encroachments, if any.
This survey is made for the exclusive use of the present owners of the property, and also those who purchase, mortgage, or guarantee the title thereto within one (1) year from date hereof; and as to them I warrant the accuracy of said survey and map.
September 25, 1978

George F. Dunham
George F. Dunham, Surveyor

